


SCALE: - 1/2" = 1 FOOT (DETAILS AS SHOWN)	
AREA OF RUDDER (A)	= 105 sq. ft.
C.G. 1BAFT AXIS (D)	= 2.47 ft.
L x D	= 260
SPEED	= 12 KNOTS.
DIAMETER OF RUDDER HEAD	= 3' (RULE 9 1/2")

CAST STEEL MAINPIECE, FORGED STEEL STOCK.
CAST STEEL CARBON CONTENT NOT TO EXCEED 0.23% (FOR WELDING).
MAINPIECE AND ARMS IN ONE PIECE.
ALL TO LLOYDS TEST AND SURVEY.

ALL CHANGE OF SECTION
TO BE GRADUAL.

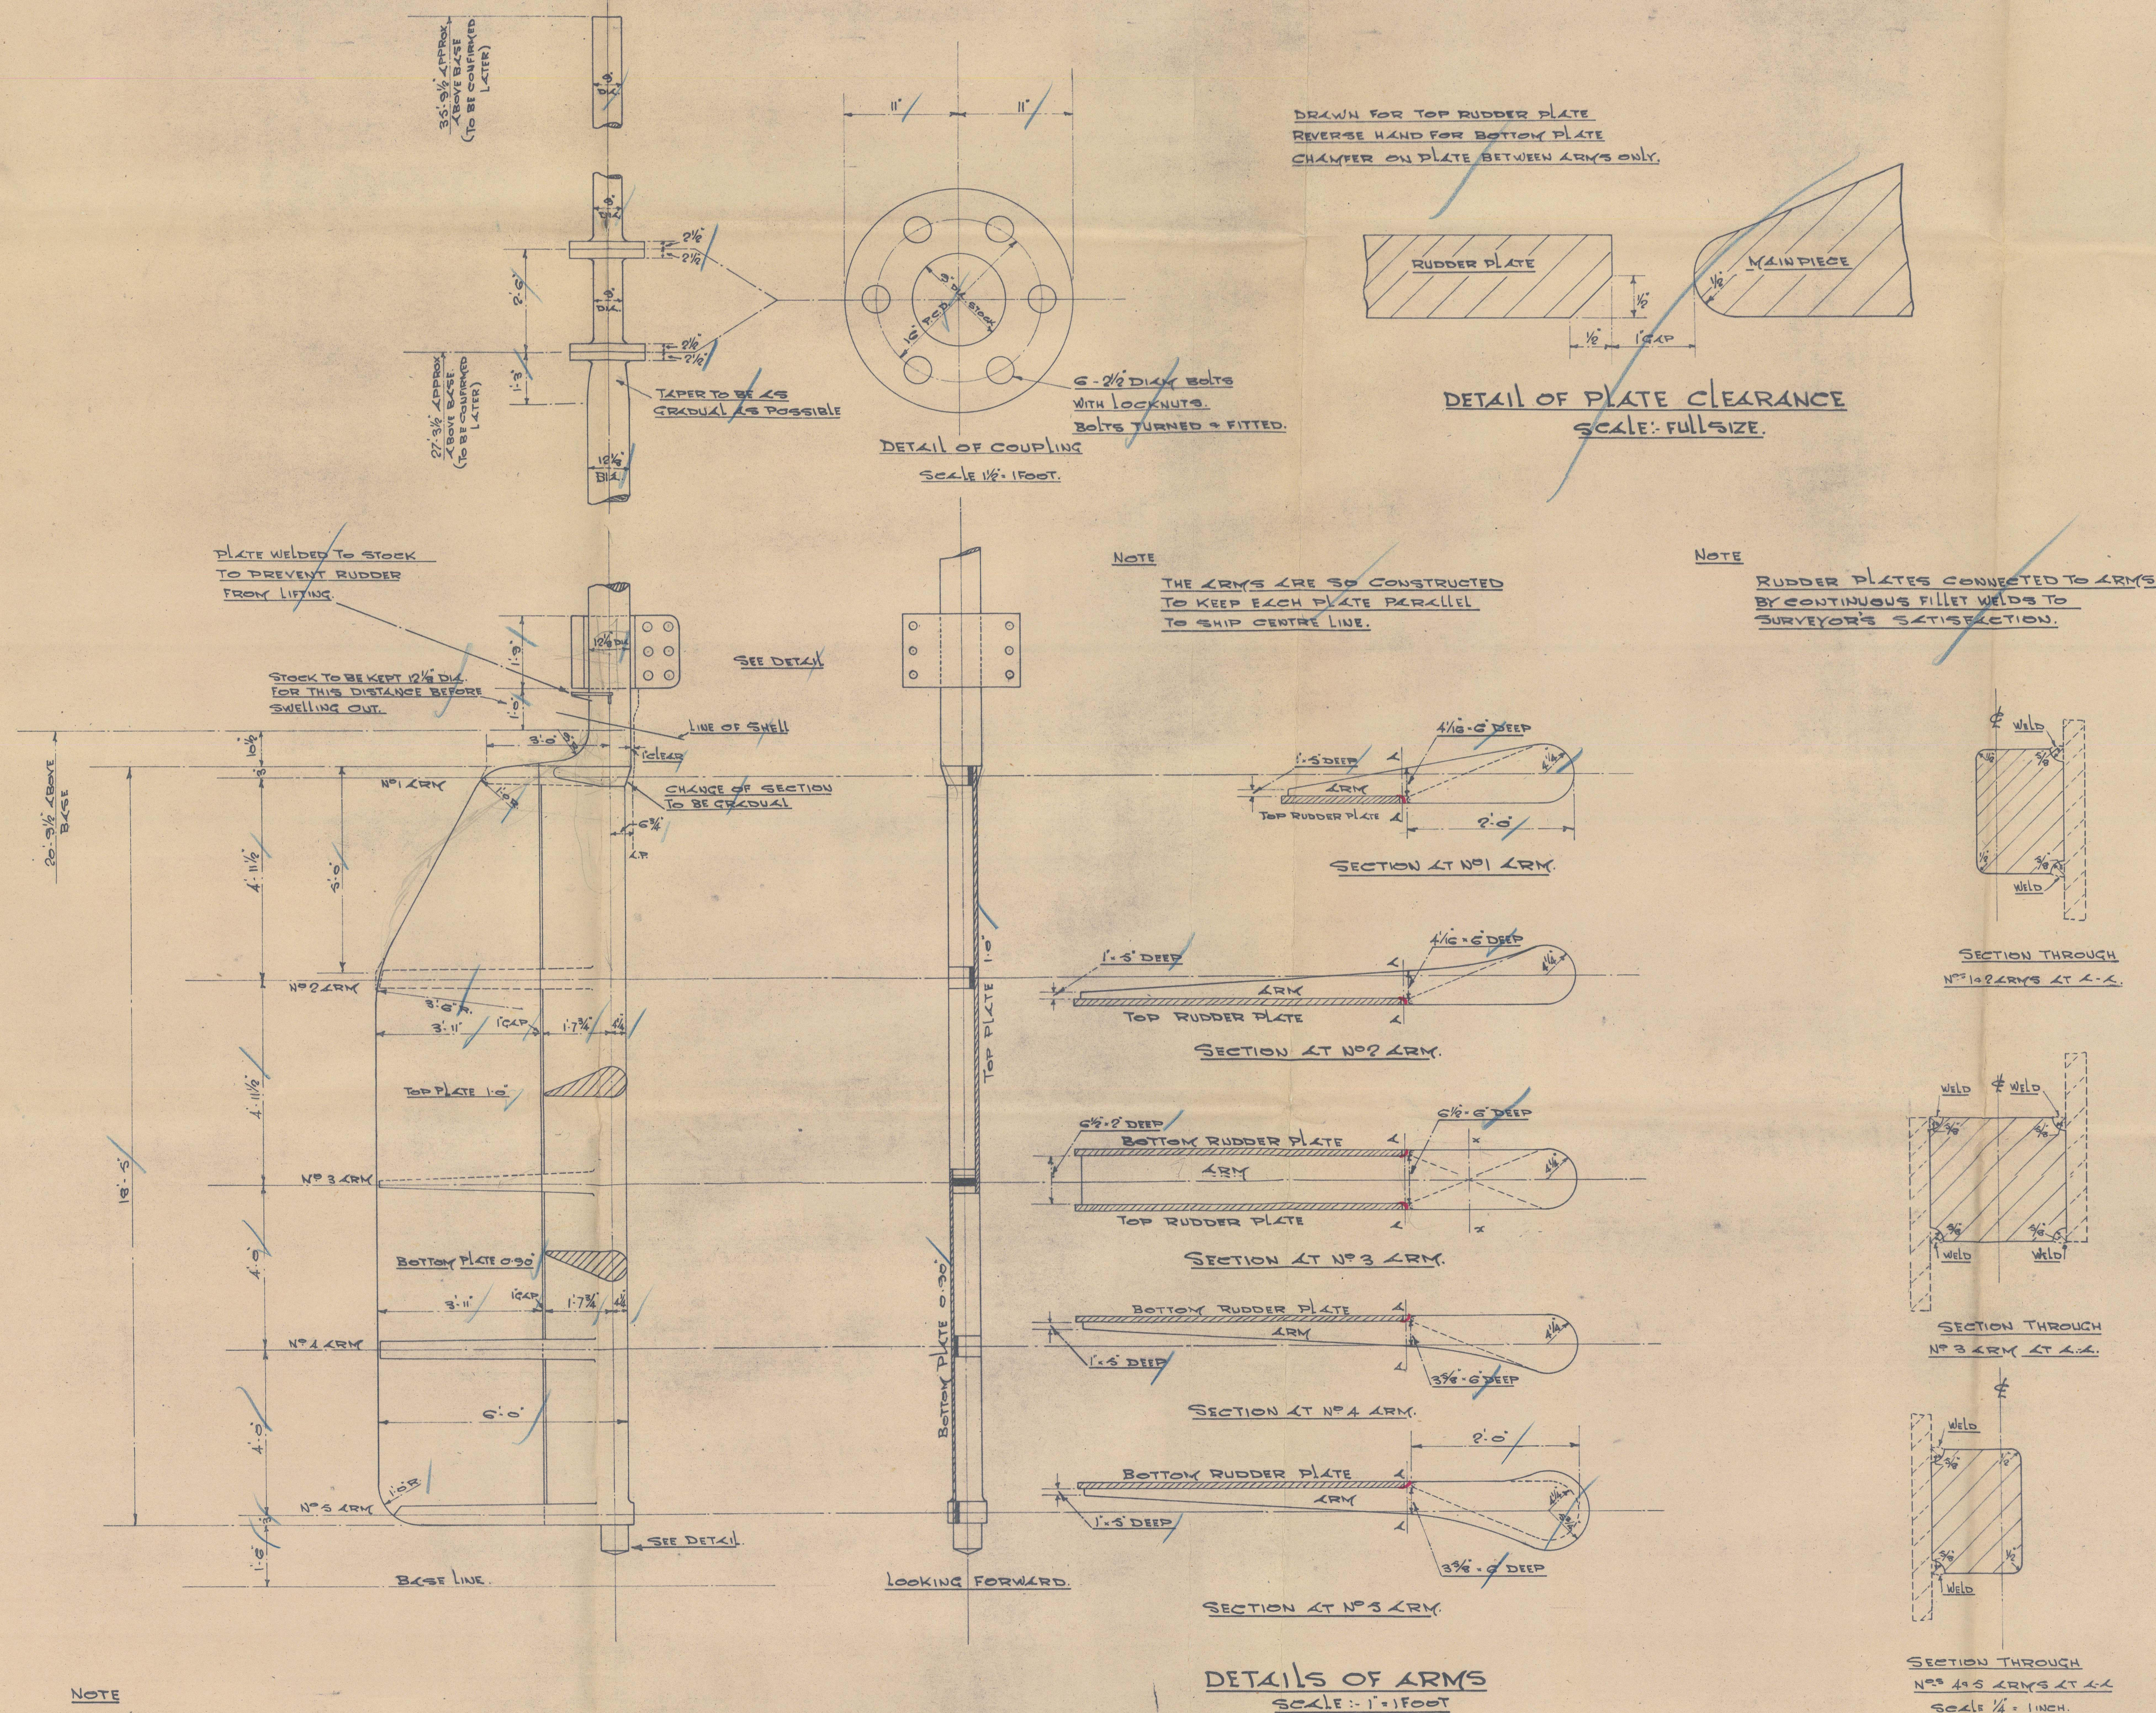


NOTE

AFTER COMPLETION THE PARTS ARE TO
BE BOLTED TOGETHER FOR LLOYD'S SURVEYOR'S
APPROVAL REGARDING ALIGNMENT.

STERN FRAME

SCALE :- $\frac{1}{2}$ " = 1 FOOT.

STERN FRAME OF CAST STEEL
TO LLOYDS TEST AND SURVEY.

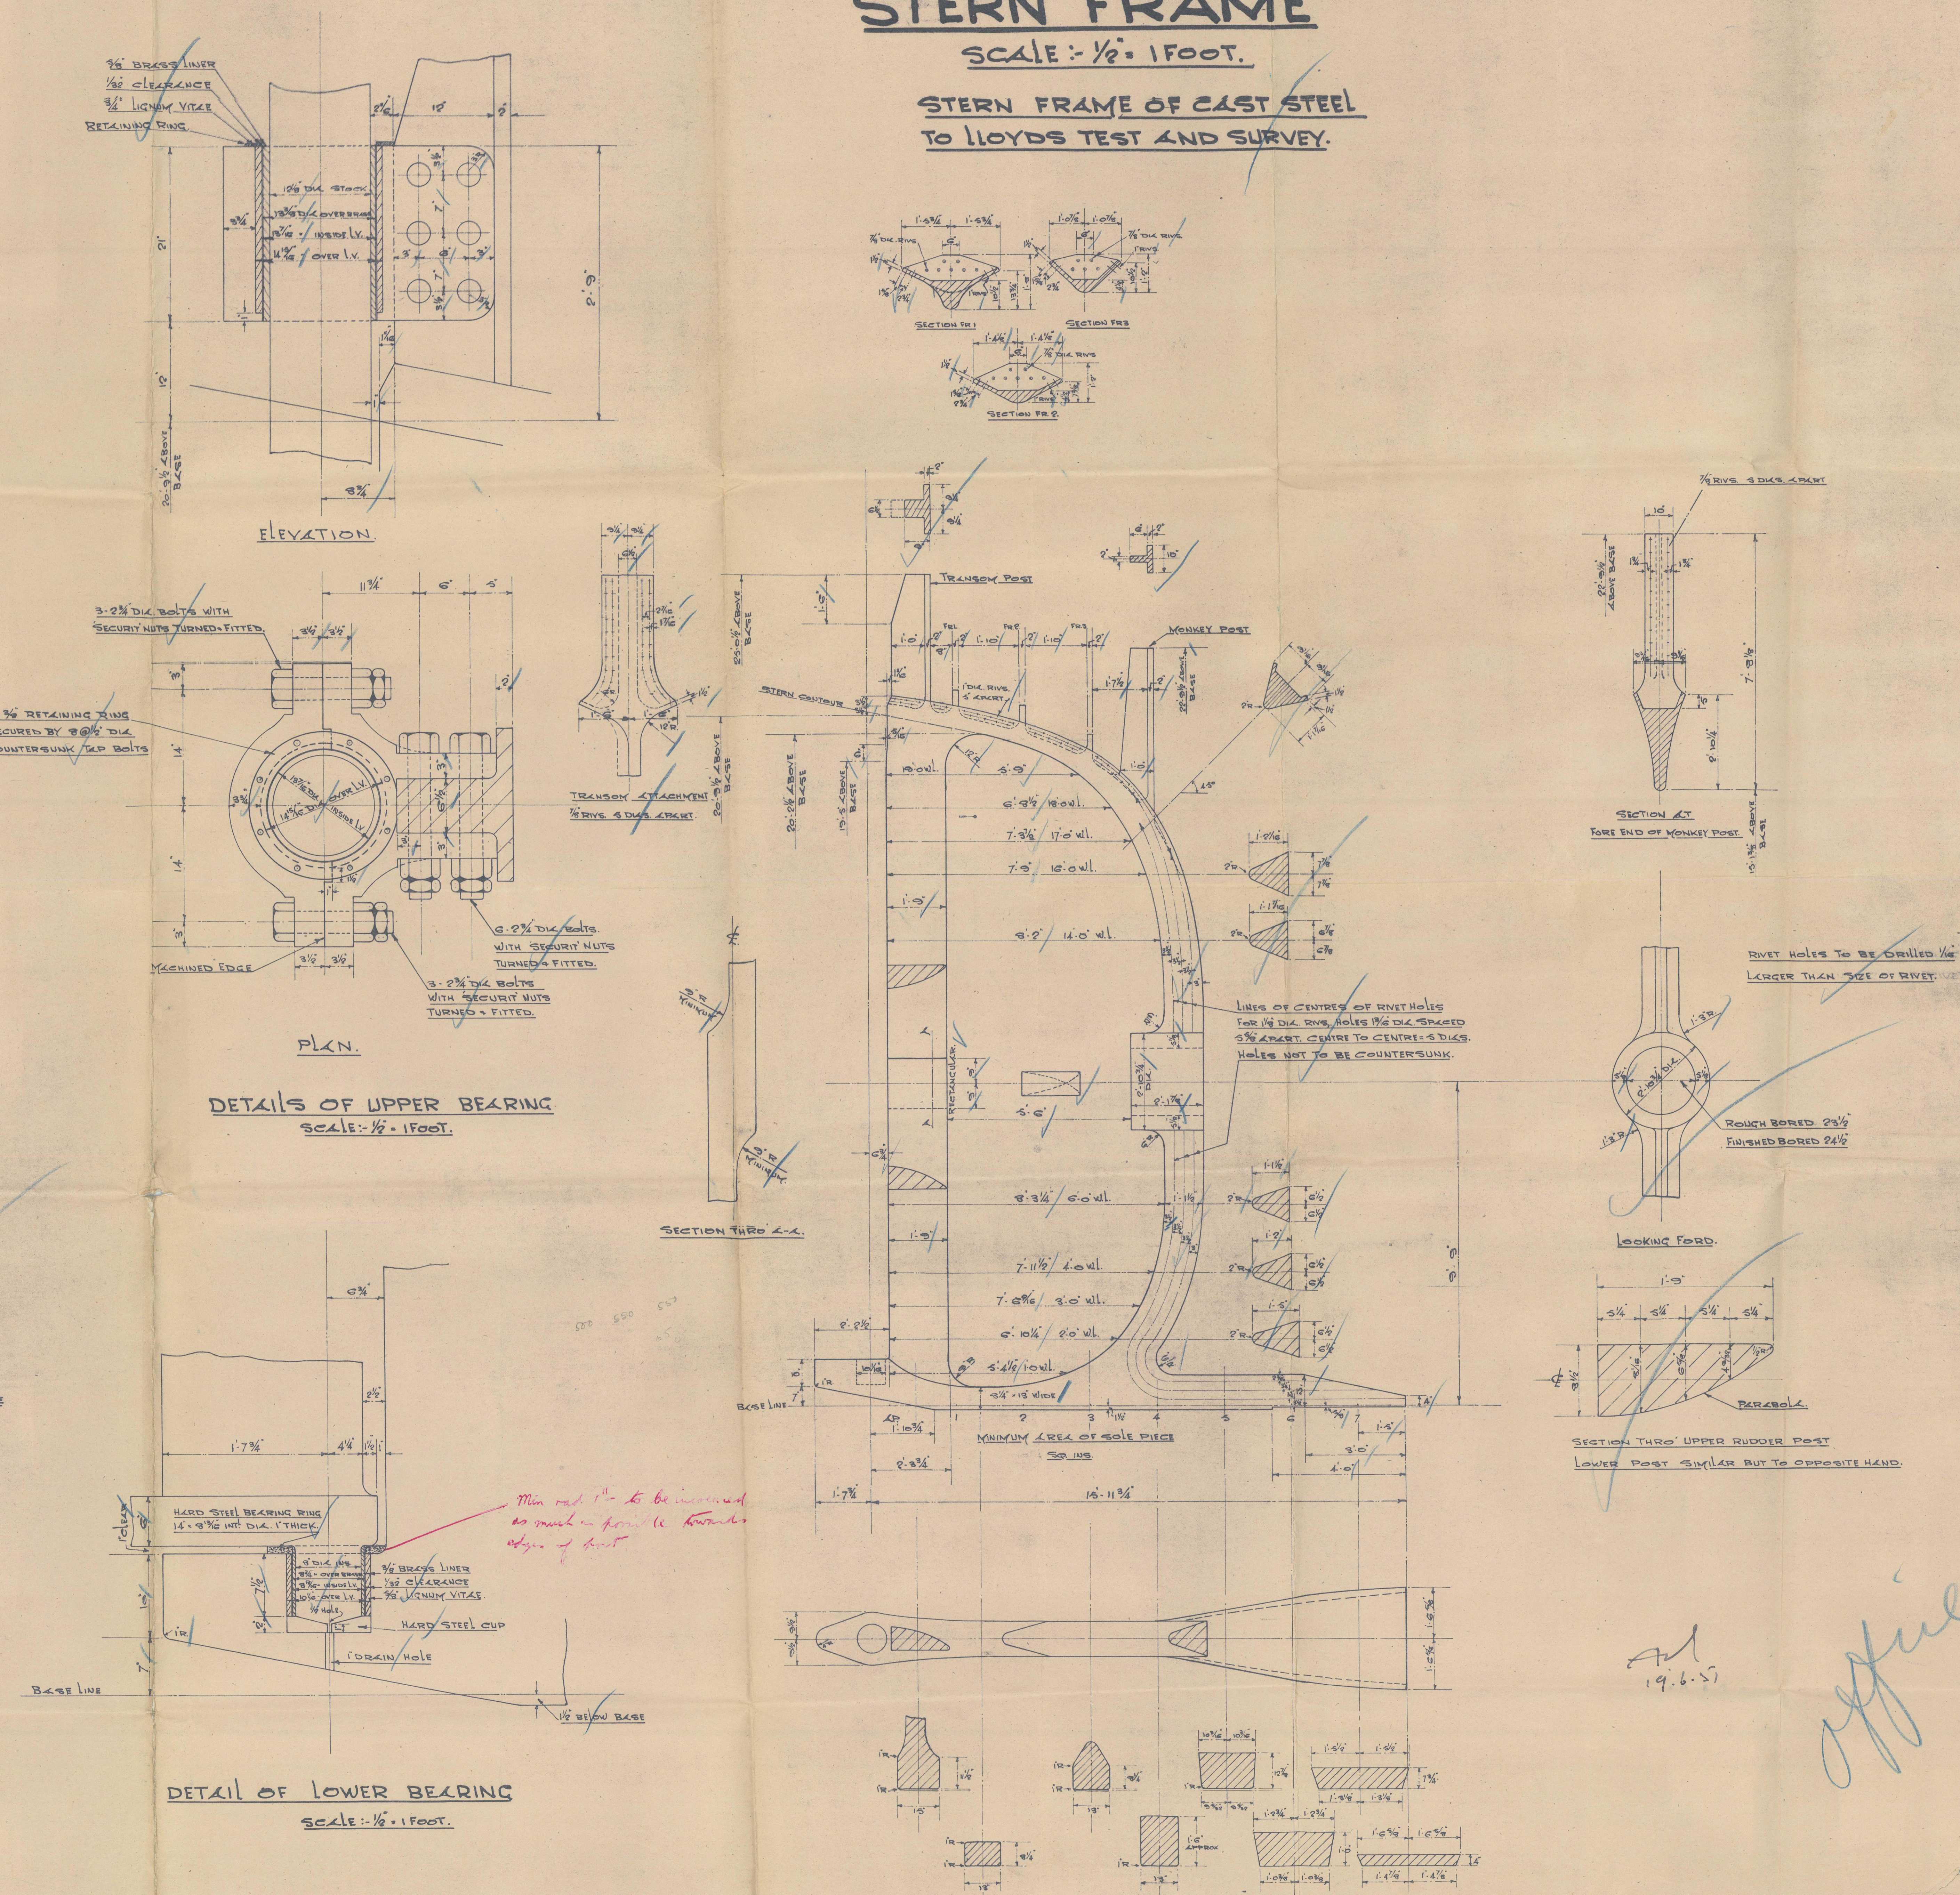

Office

ROOK WOOD

* RUSH WOOD.

Sternframe & rudder

RECORDS DEPT.,
LONDON.

10

JOHN READHEAD & SONS
YARD NOS. 572-4

STERNFRAME & RUDDER



© 2021

Lloyd's Register
Foundation