



Position A"

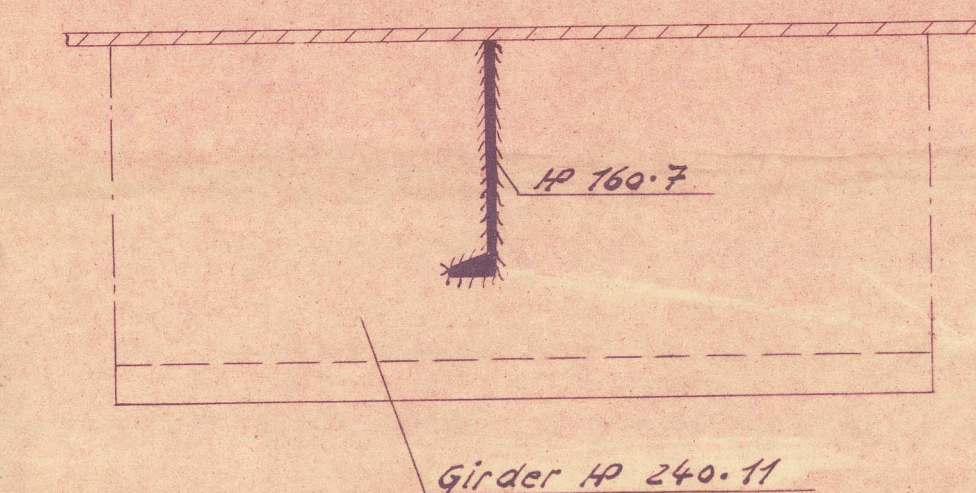

Where X bulwark-stays AP 140.6

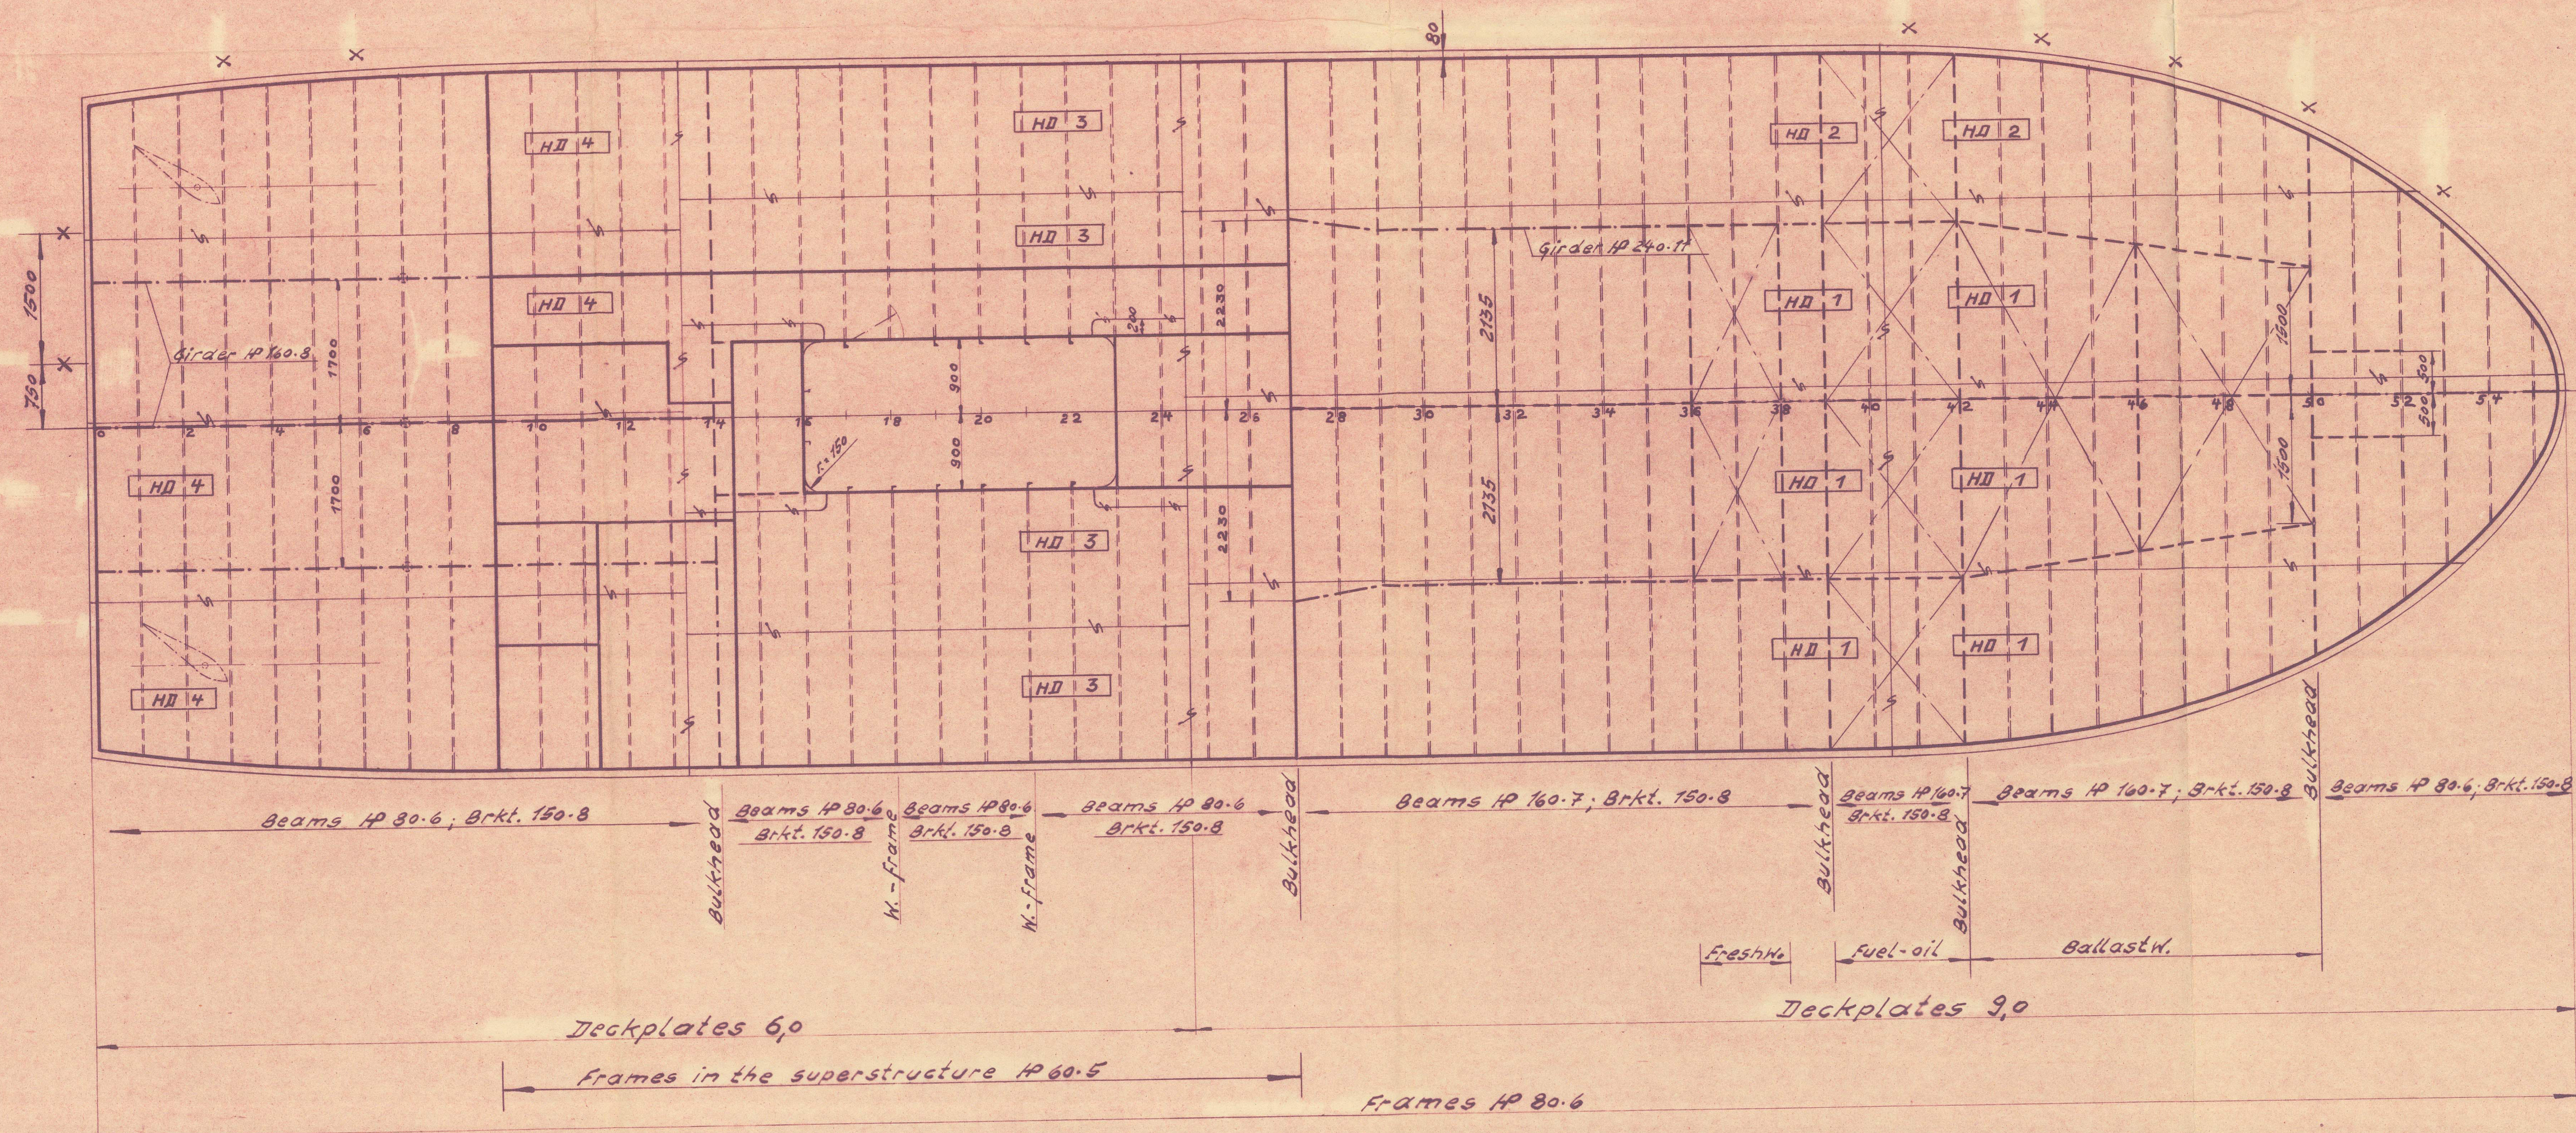

Plan as fitted.
No 1103

Characteristics
Length over Deck . . . 26.95' 0"
Length betn. perp. . . . 30' 0"
Breadth moulded . . . 27' 1/4"
Depth moulded . . . 7' 6"
Draft 4' 0"
Speed ab. 9 kn.


Capacity: Passenger . . . 30 Pers.
Vehicles 2 Trucks
2 Cars

Klasse-Lloyd's Register *A1
"For River & Estuary Service"

J. H. Kremer Sohn, shipyard, Elmshorn
Proprietor
Steel-plan
Scale 1:50
Entw. 21662 f. 10.62
Drawing: No 1100/1103-5

Genehmigt von Lloyd's Register am 12.10.62
Genehmigt von Maier-Form am 1.10.62

RECORDS DEPT.,
LONDON.

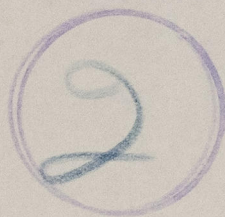

Profile and Decks

Retain with Hamburg


Ship First Entry

Report No. 13485

~~SS/MS~~ IWTA YAMUNA ★

Murens John, Yard No.

As fitted ✓

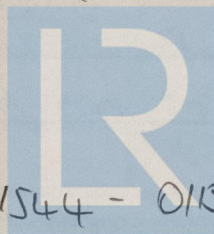

© 2021 ¹¹⁰³

Lloyd's Register
Foundation

011544 - 011554 - 0030