


see letter 27-6-46

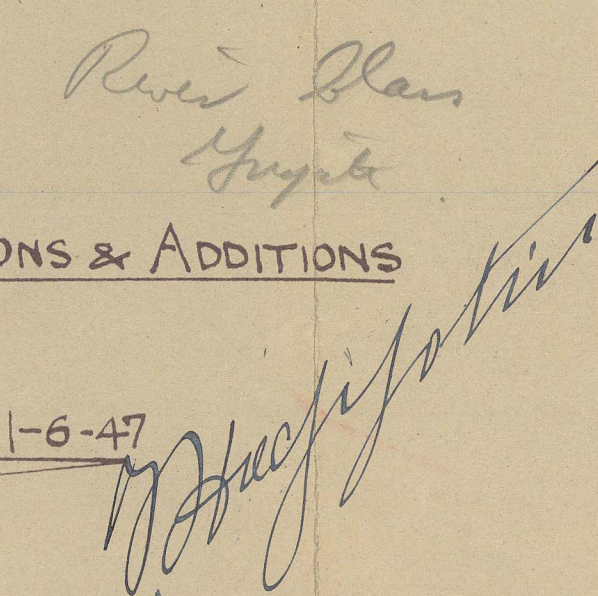

3

Conversion General Argt.

T.S.S. TETI ex LOSSIE.


Disburse 27.6.47.

Ex Recd. 8 Jan. 1947

Disburse 10 JUN 1947

T.S.S. TETI.

General Argt (Borrow)

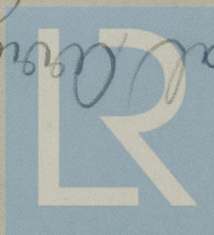

© 2021

Lloyd's Register
Foundation

011595-011602-0002