


SECTION TI-RO' ENGINE ROOM

DECK CAMBER $5 \frac{1}{2}$ " IN 22'-0"

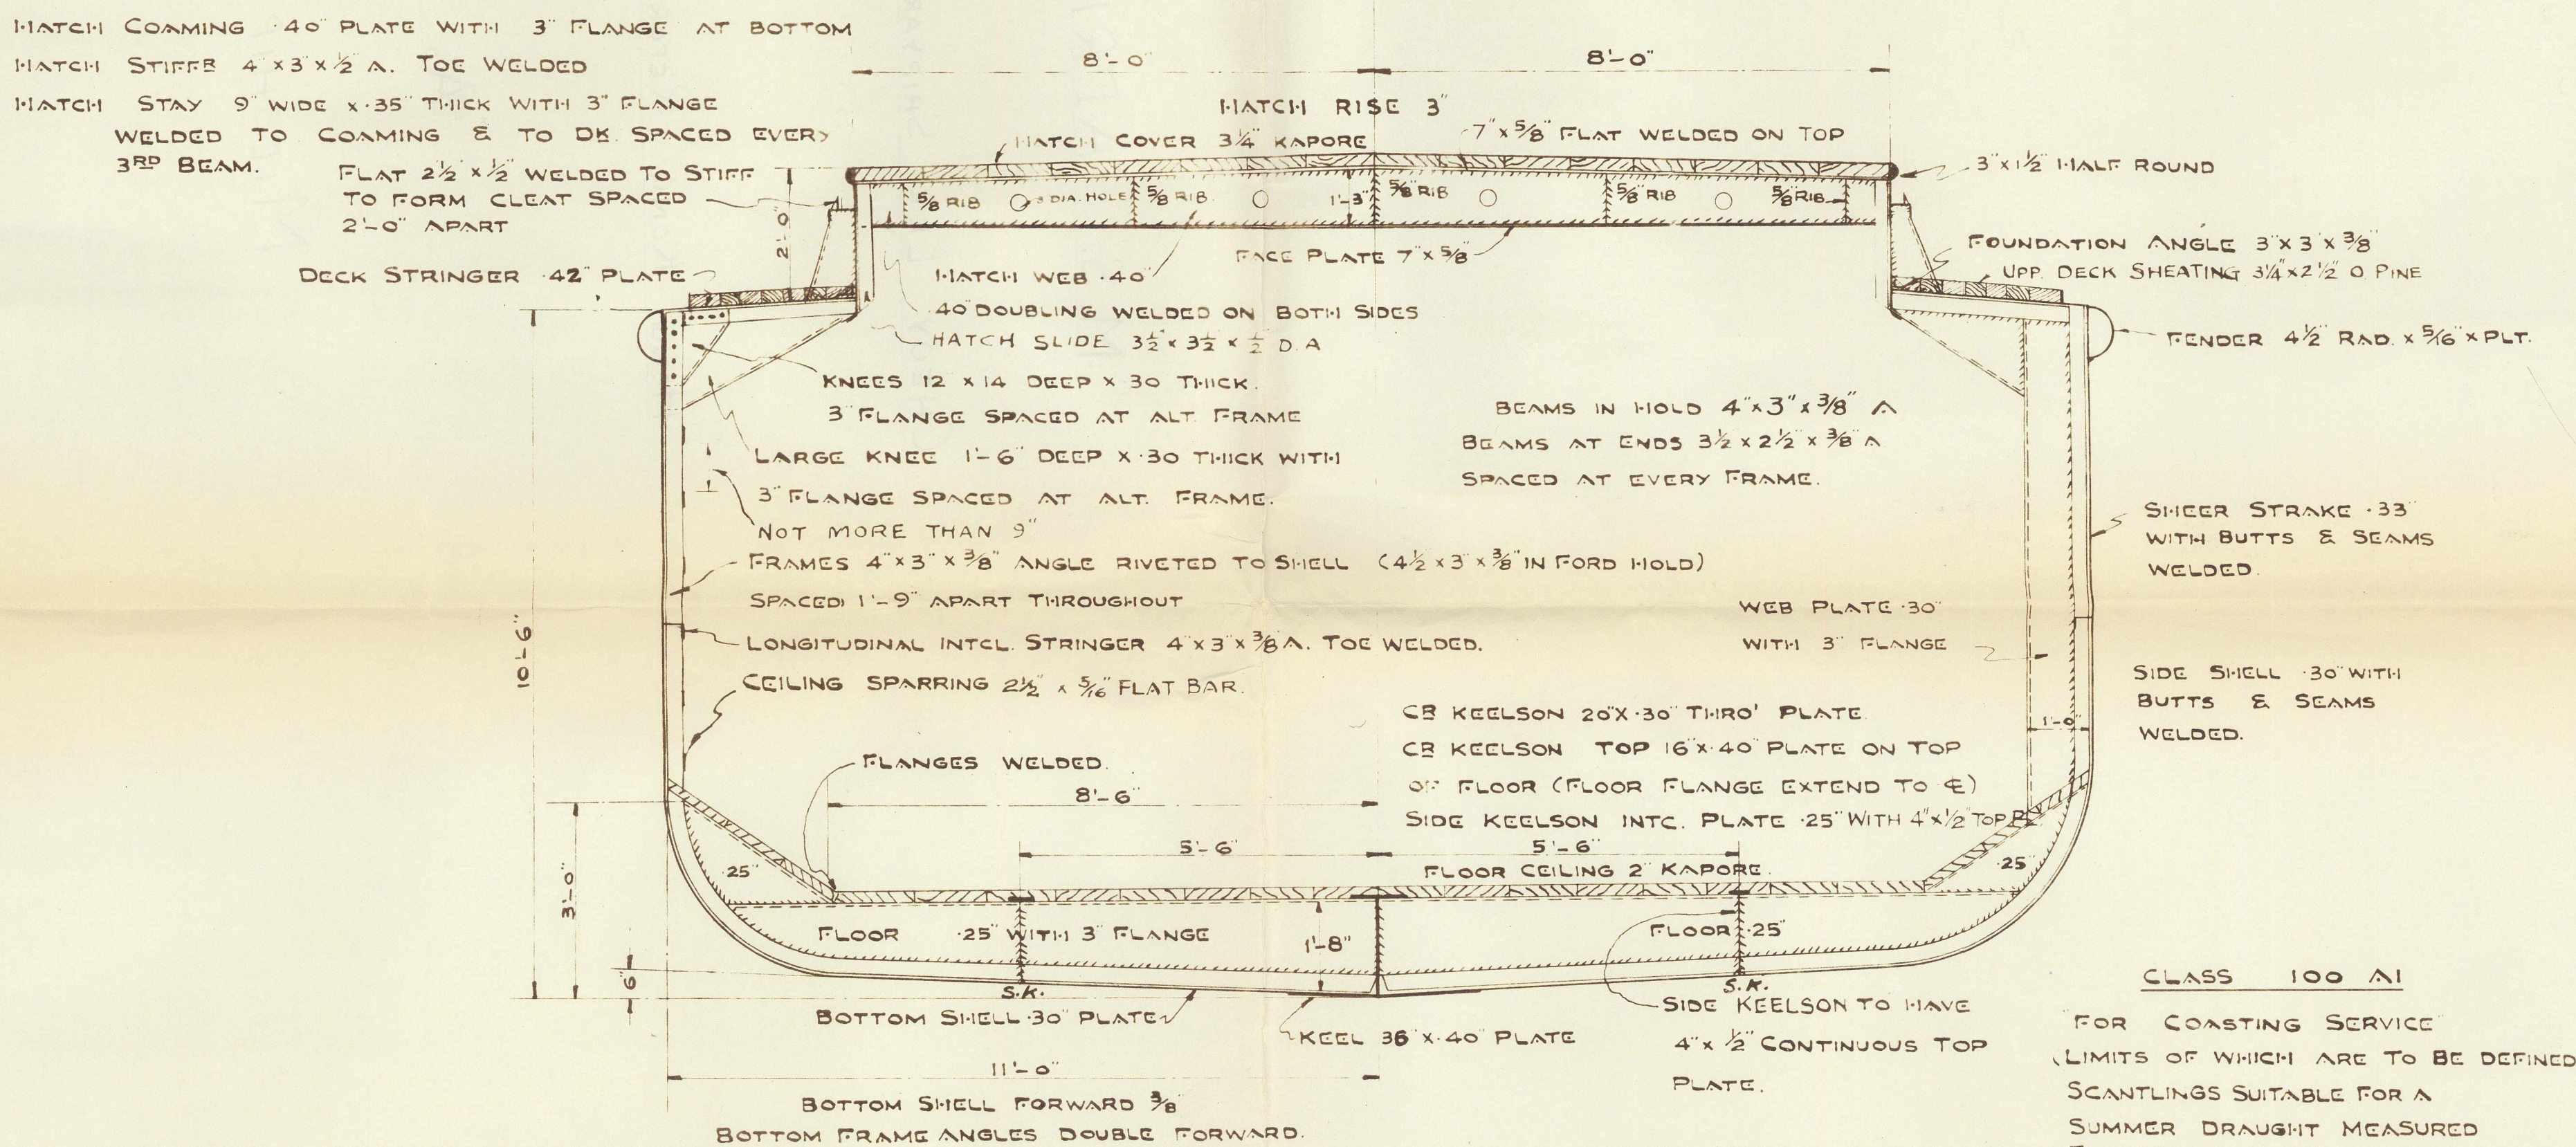

1/2 SECTION IN HOLD

1/2 SECTION TI-RO' WEB IN HOLD

M/V "ADRI VIII" SHIP NO. 701

MIDSHIP SECTION

STEEL CARGO CARRIER

DIMS:—10 8'-7" B.P. \times 22'-0" B.M. \times 10'-6" D. MOULD.

SCALE:—1/2"=1 FOOT

(AS FITTED)

APPROVED BY LLOYD'S
ON 27 AUG. 57

CHEOY LEE SHIPYARD
NGAU CHI WAN
KOWLOON, H.K.

CHECKED BY HONG TIM
DRAWN BY —
TRACED BY LEE CHEONG LAM
DRAWING NO 701-2/1
DATE 3RD JUNE 1957

M.S. "ADRI VIII"

D/S 743

CHEOY LEE SHIPYARD - YARD No. 701

HONG KONG REPORT No. 14637

RECORDS DEPT.
LONDON.

"AS FITTED"

2

MIDSHIP SECTION



© 2021

Lloyd's Register
Foundation

011665-011670-0040