


SCALE $\frac{1}{8}" = \text{ONE FOOT.}$

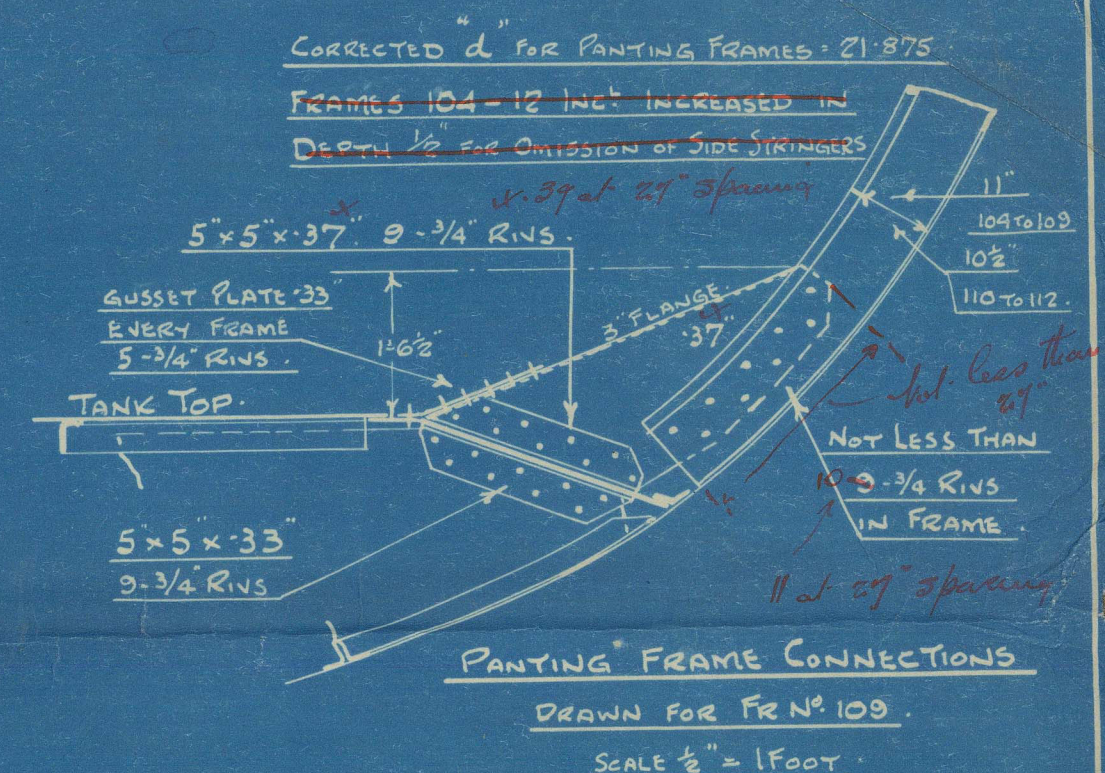

THE BURNT ISLAND SBC^o L^o

SS N^o 175

PROFILE + DECK

s.s. "Francis Gladgate"

hth. Npt. No. 18506



© 2021

Lloyd's Register
Foundation

011777-011790-0328