


LLOYD'S REGISTER OF SHIPPING

UNITED WITH THE BRITISH CORPORATION REGISTER

Ship's Name "STOCKHOLM" Official No. 8926

Memorandum of alterations reported since ship was surveyed for assignment of Load Lines in DECEMBER 1947

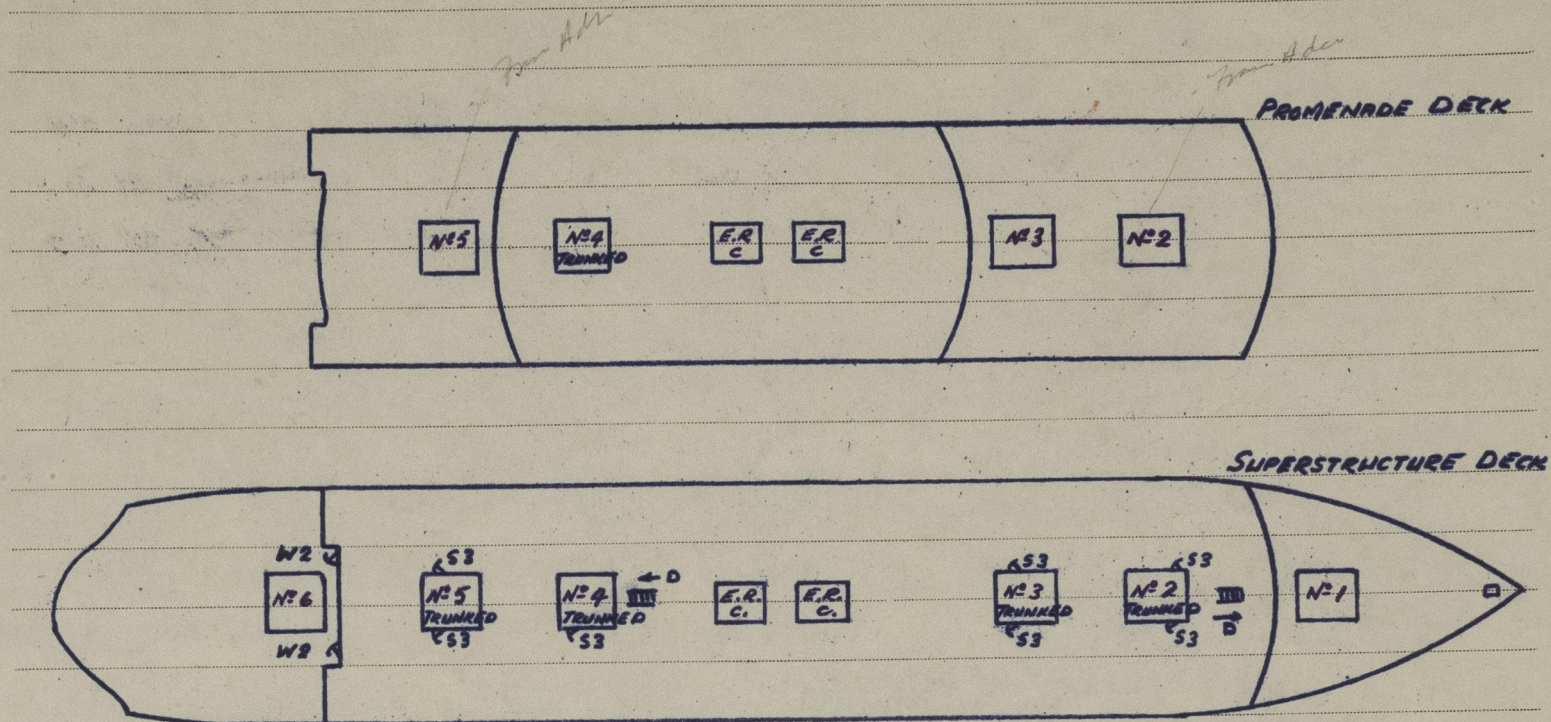

| | | | |
|----------------------|-------------------------------|-----------------|----------------|
| DESCRIPTION OF HATCH | N° 2 | N° 4 | N° 5 |
| | PROM. DK. | BOAT DK | PROM. DK. |
| DIMENSIONS OF HATCH | 8250 x 5500 | 6600 x 5500 | 6600 x 5500 |
| COAMINGS | HEIGHT ABOVE DK. | 900 | FLUSH |
| | THICKNESS | 12 | AS |
| | STIFFENERS | 180 x 90 x 10 L | APPROVED |
| | BRACKETS | 2 | APPROVED |
| HATCH BEAMS | VON TELL HATCH AS APPROVED | | |
| HATCH COVERS | MATERIAL | STEEL | STEEL |
| | THICKNESS | 8 mm | 8 mm + 3" WOOD |
| | HOW FITTED | N.T. | W.T. |
| SPACING OF TOGGLES. | 700 | 730 | 730 |

N° 2 & 5. Hatch covers re-protected
from A deck
N° 4. Hatch cover re-protected
from promenade deck.
S.S. (R+8).

SUPERSTRUCTURE DECK

6 @ 75 mm DIA AIR PIPES GOOSENECKS 800 mm HIGH (3 Pcs 35) FROM N° 1, 2 & 3 F.W. DEEP TANKS
1 @ 50 mm " " " " 800 mm " " D.B.C.D. SPACE FRs 144-145.
AIR PIPES PROVIDED WITH MEANS OF CLOSING.

BULWARK 1100 mm HIGH SUBSTANTIALLY CONSTRUCTED AND SUPPORTED,
WITH OPEN RAILS, AS ORIGINALLY APPROVED BETWEEN FRs 155 & 167 Pcs.