

SEIYUN

Yld. 3547.


23 DEC 1950

Lloyd's Register of Shipping.

Ship's Name M.V. SEASILVER

Official No. 169200

Memorandum of alterations reported since ship was surveyed for assignment of Load Lines
in

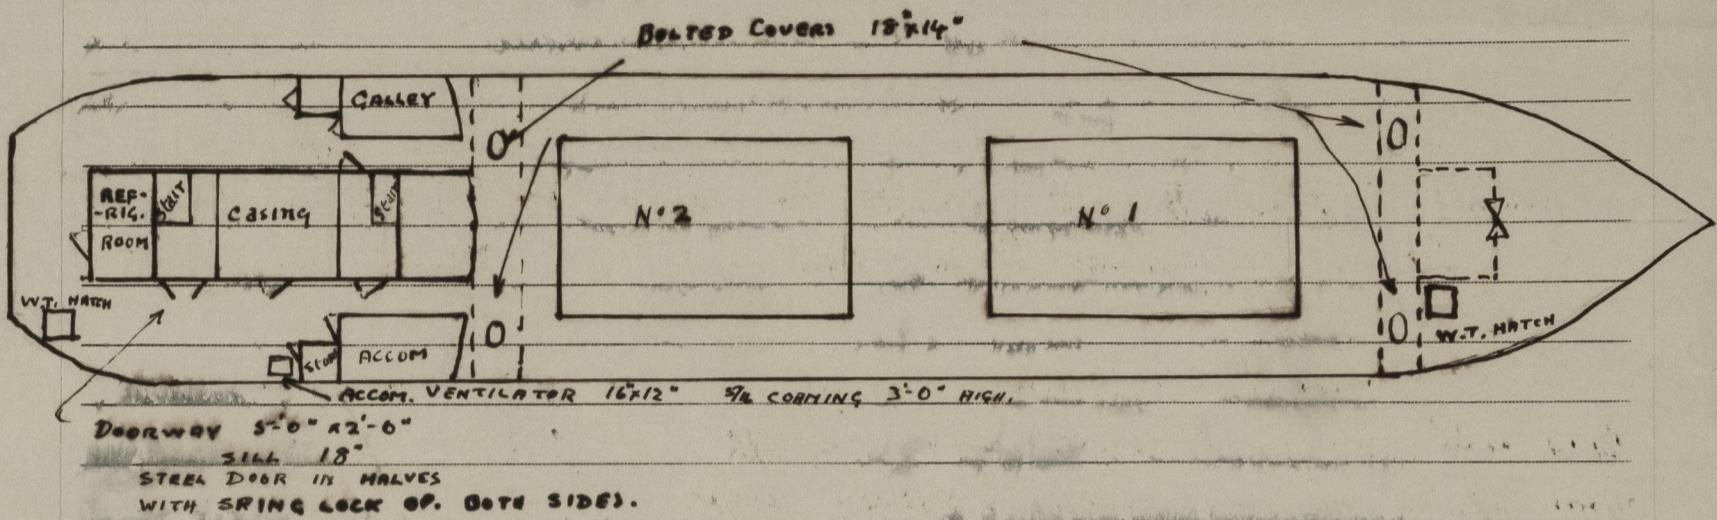

copper bands fitted at each end of tween deck and after end of hold to water seal hold when carrying petroleum in steel containers.

Store moved to upper F.P. Opening at after end of chain locker sealed and access given at fo'd end.

W.T. hatches to old store removed and openings sealed with riveted steel plate. Starbd hatch now fitted to upper F.P. and old manhole closed with riveted steel plate.

Refrigerator room fitted at after end of machinery casing. Ventilator with fan fitted on starbd side to supply trunk ventilation to accommodation.

N. Chambers.

Hull, 14-12-50

2021
© LRF 2021Lloyd's Register
Foundation

011869-011876-0178

Store moved to upper

Sear Silver.

The 18-14" marshals shown
in oil card. are in order.

JG
4/1/51

omit

© 2021

Lloyd's Register
Foundation

