

STEEL MOTOR BARGE

N^o 215

TO CLASS LLOYDS 100 A - FOR SERVICE IN THE
BRISTOL CHANNEL LIMITING PORT SEAWARD SWANSEA


MOULDED DIMENSIONS - 89'-0" x 19'-6" AT D⁵ x 8'-0"

SCALE 1/2" = 1 FOOT

OWNERS EQUIPMENT			
TWO BOWER ANCHORS EACH	4 3/8" STOCKLESS		
90 FATHOMS	1 1/16" STUD LINK CABLE		
75 "	5 1/2"	MANILLA	
90 "	3"	"	

L x D = 712
L x (B + D) = 2447.5
L/D = 11.12
d = 7.42

DRAFT = 7'-3"

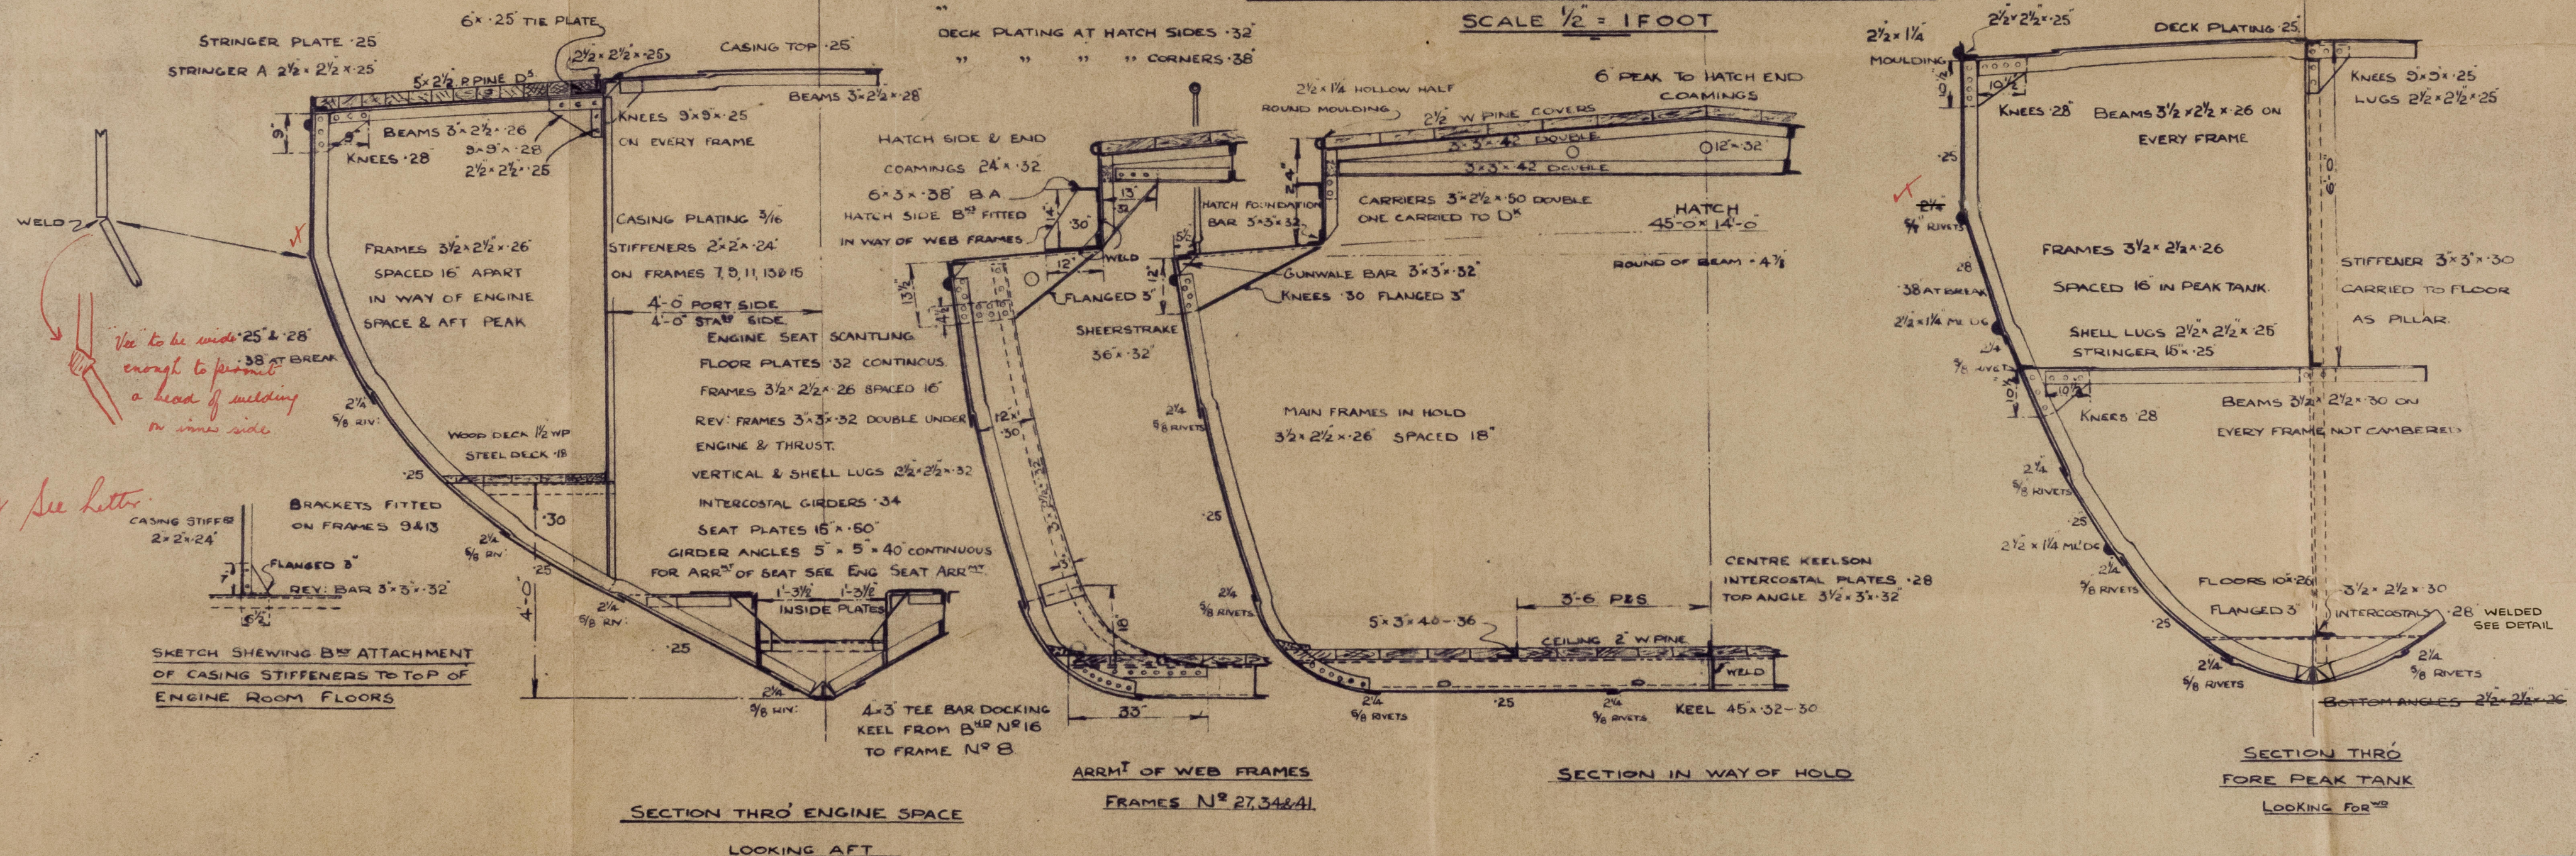

01877-011883-0104



Chas. Hill & Sons Ltd.

57²
5 Severn Industry

Midship section.

no. 215.



© 2021

Lloyd's Register
Foundation

011877-011883-0104