

PROFILE

N^o 410.

CARGO STEAMER.

LENGTH BETW PERPL 241'-0" 5-1-21

BREADTH MOULDED 37'-0"

DEPTH " 19'-0"

CLASSED DET NORSKE VERITAS 1A.1.

SCALE 1 A. 100.






ALL THICKNESSES 1/100 OF AN INCH

GEBR^s JONKER

SHIPBUILDERS

KINDERDÜK HOLLAND

ETABL 1810

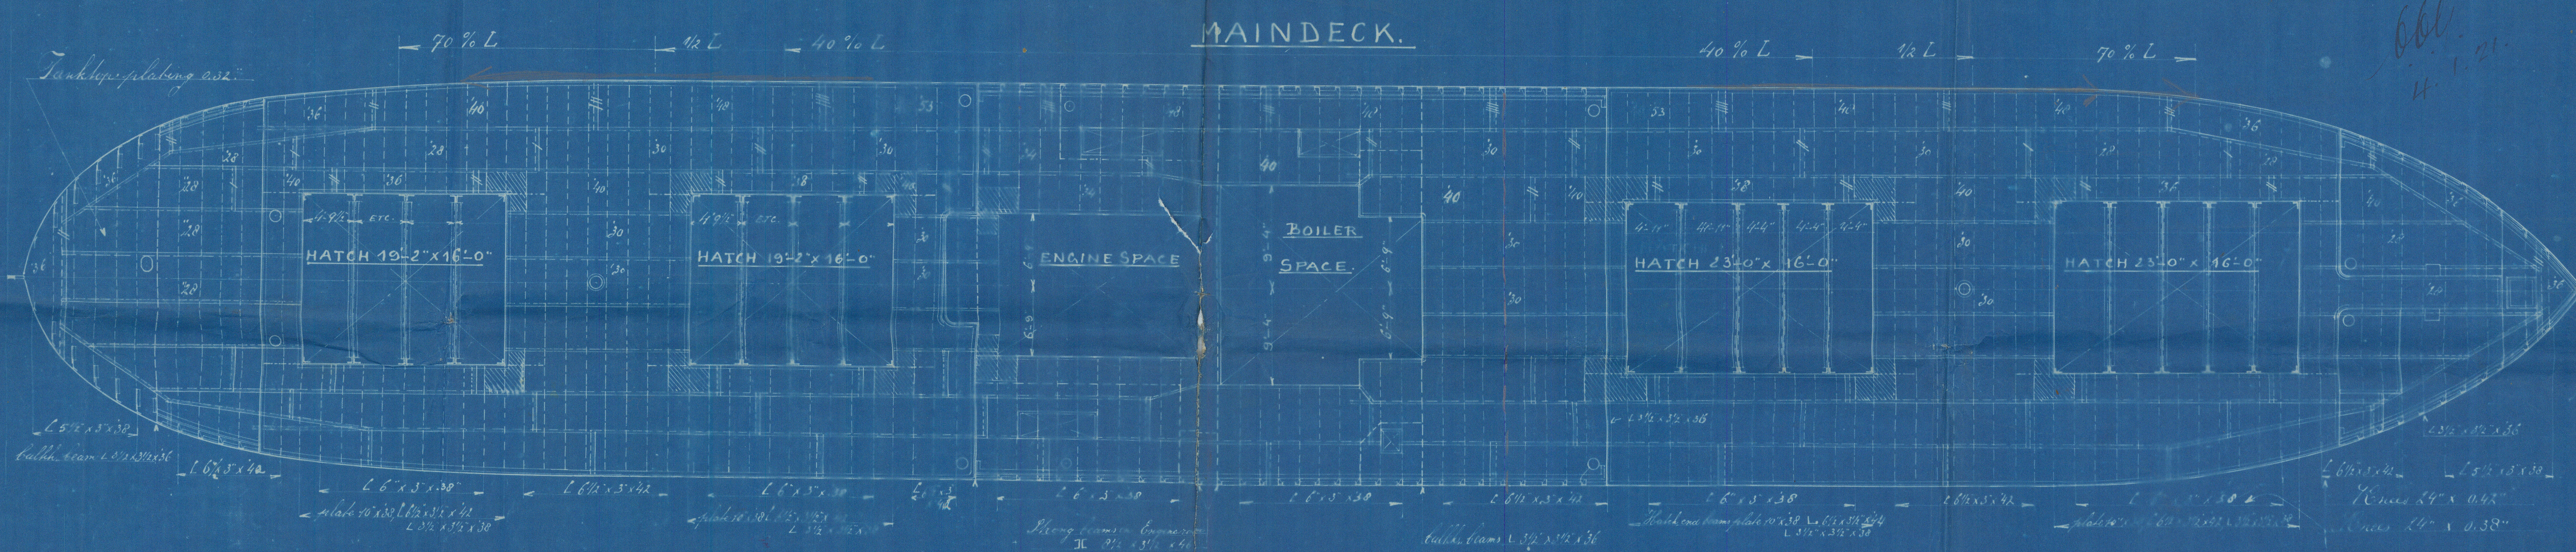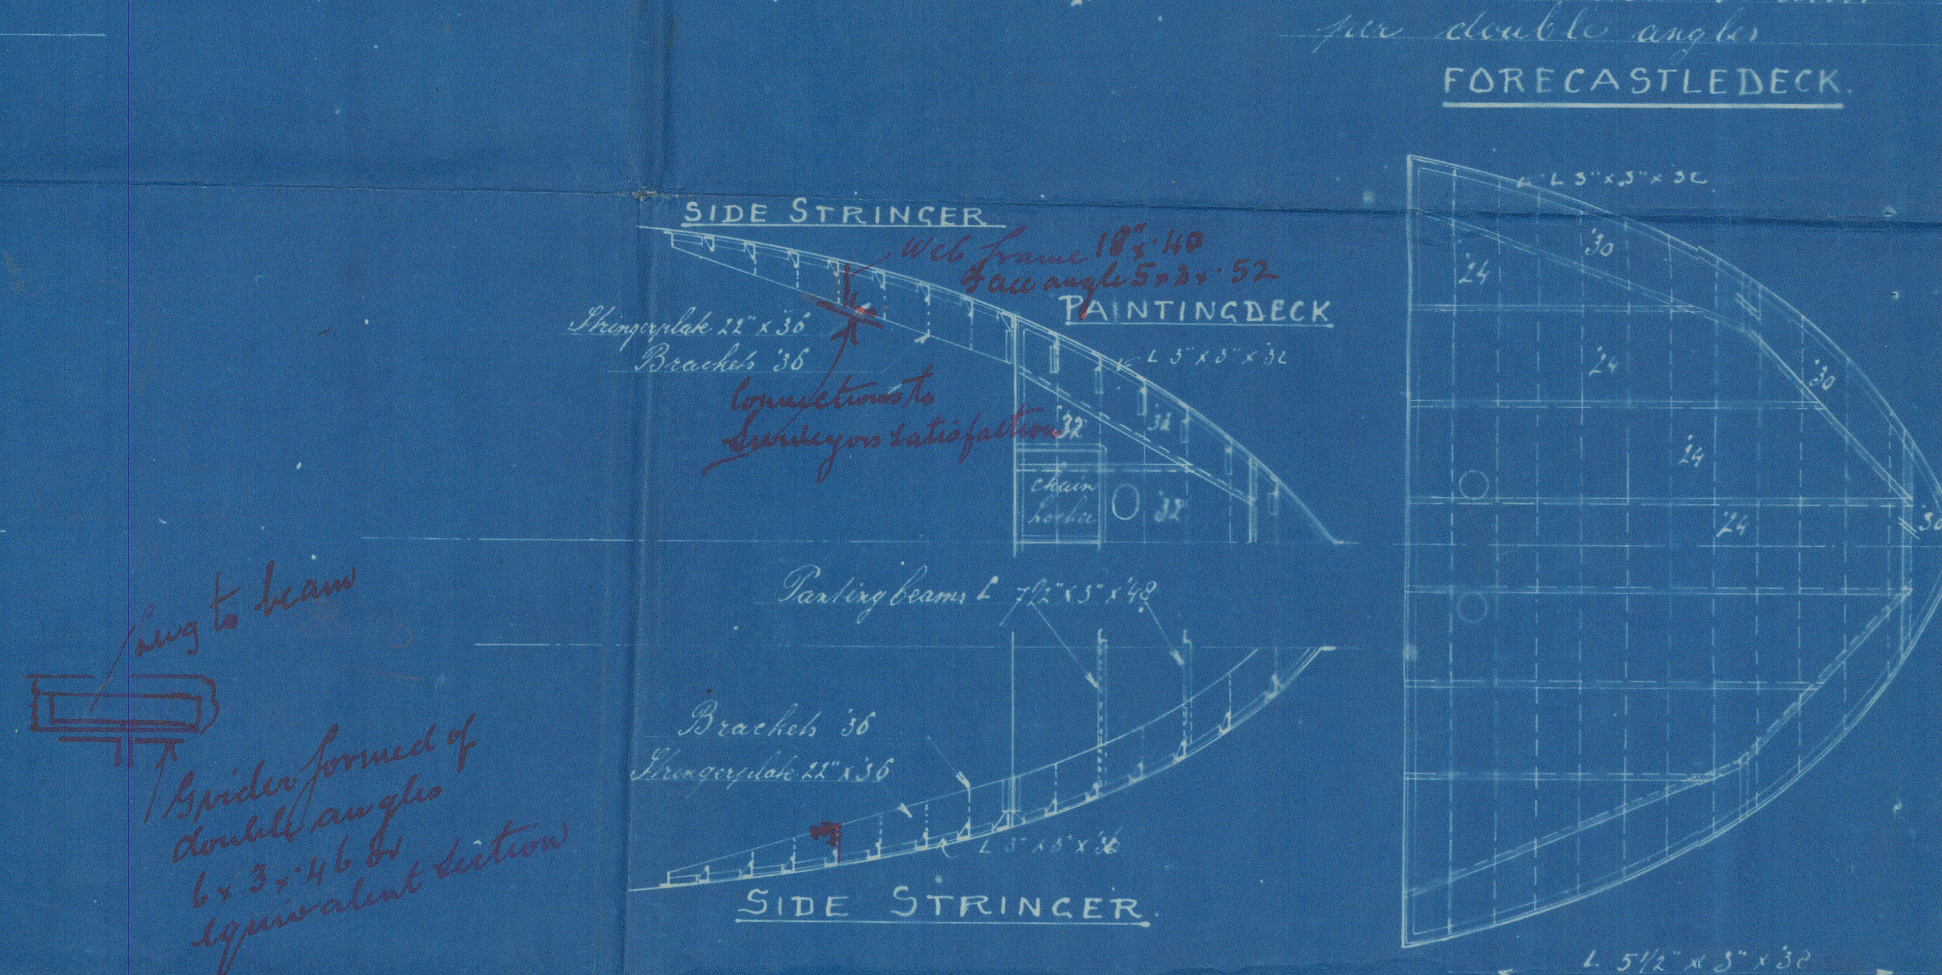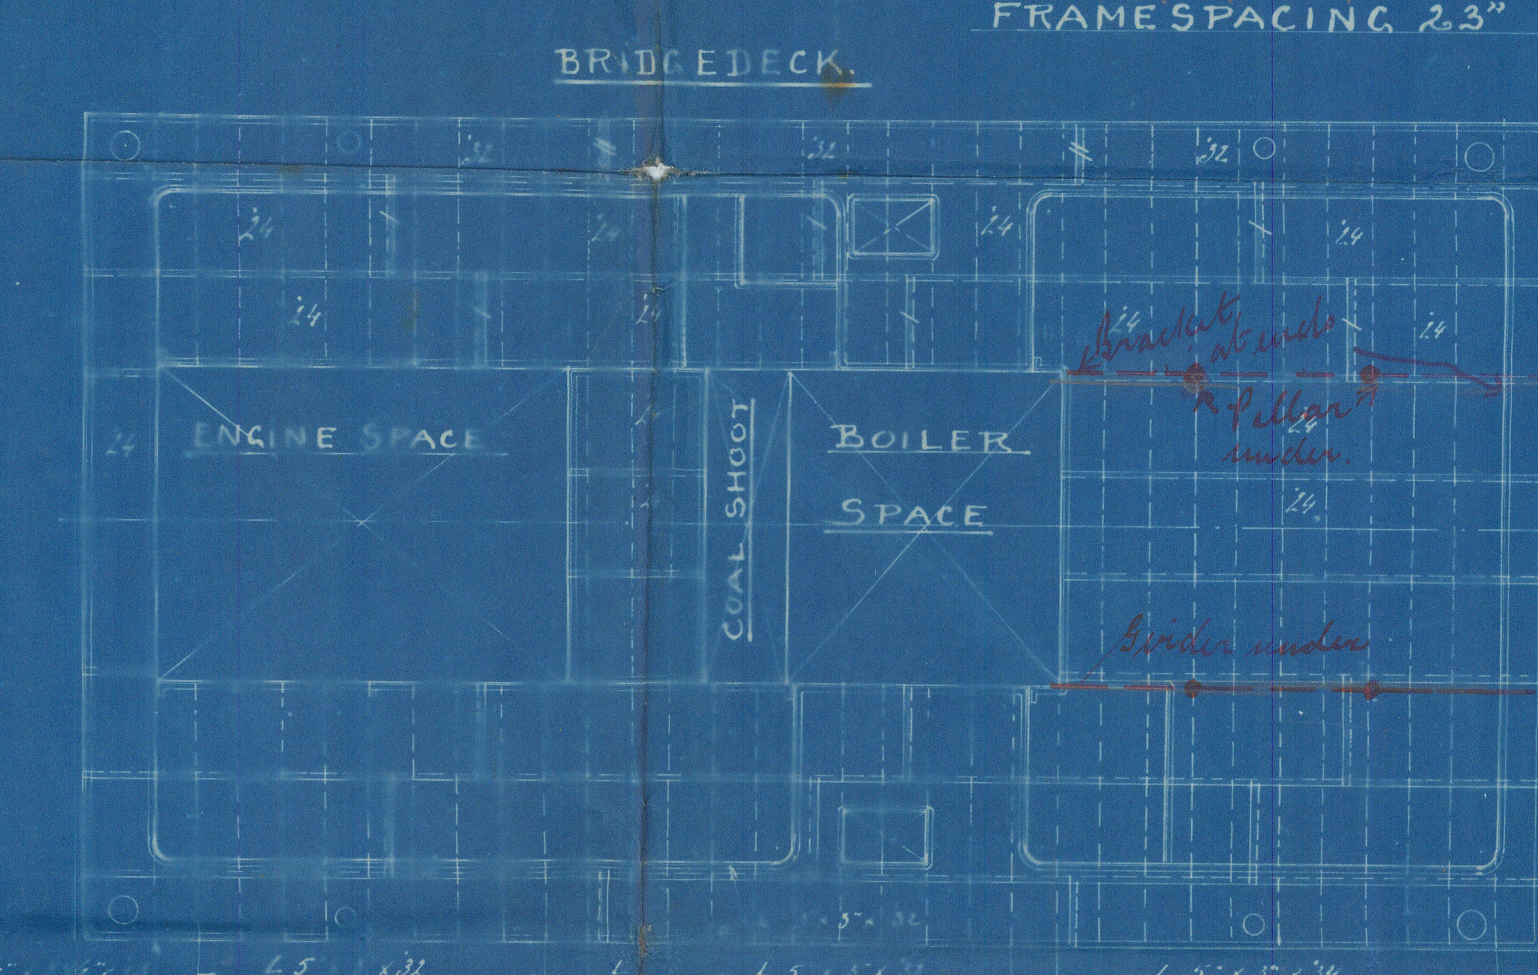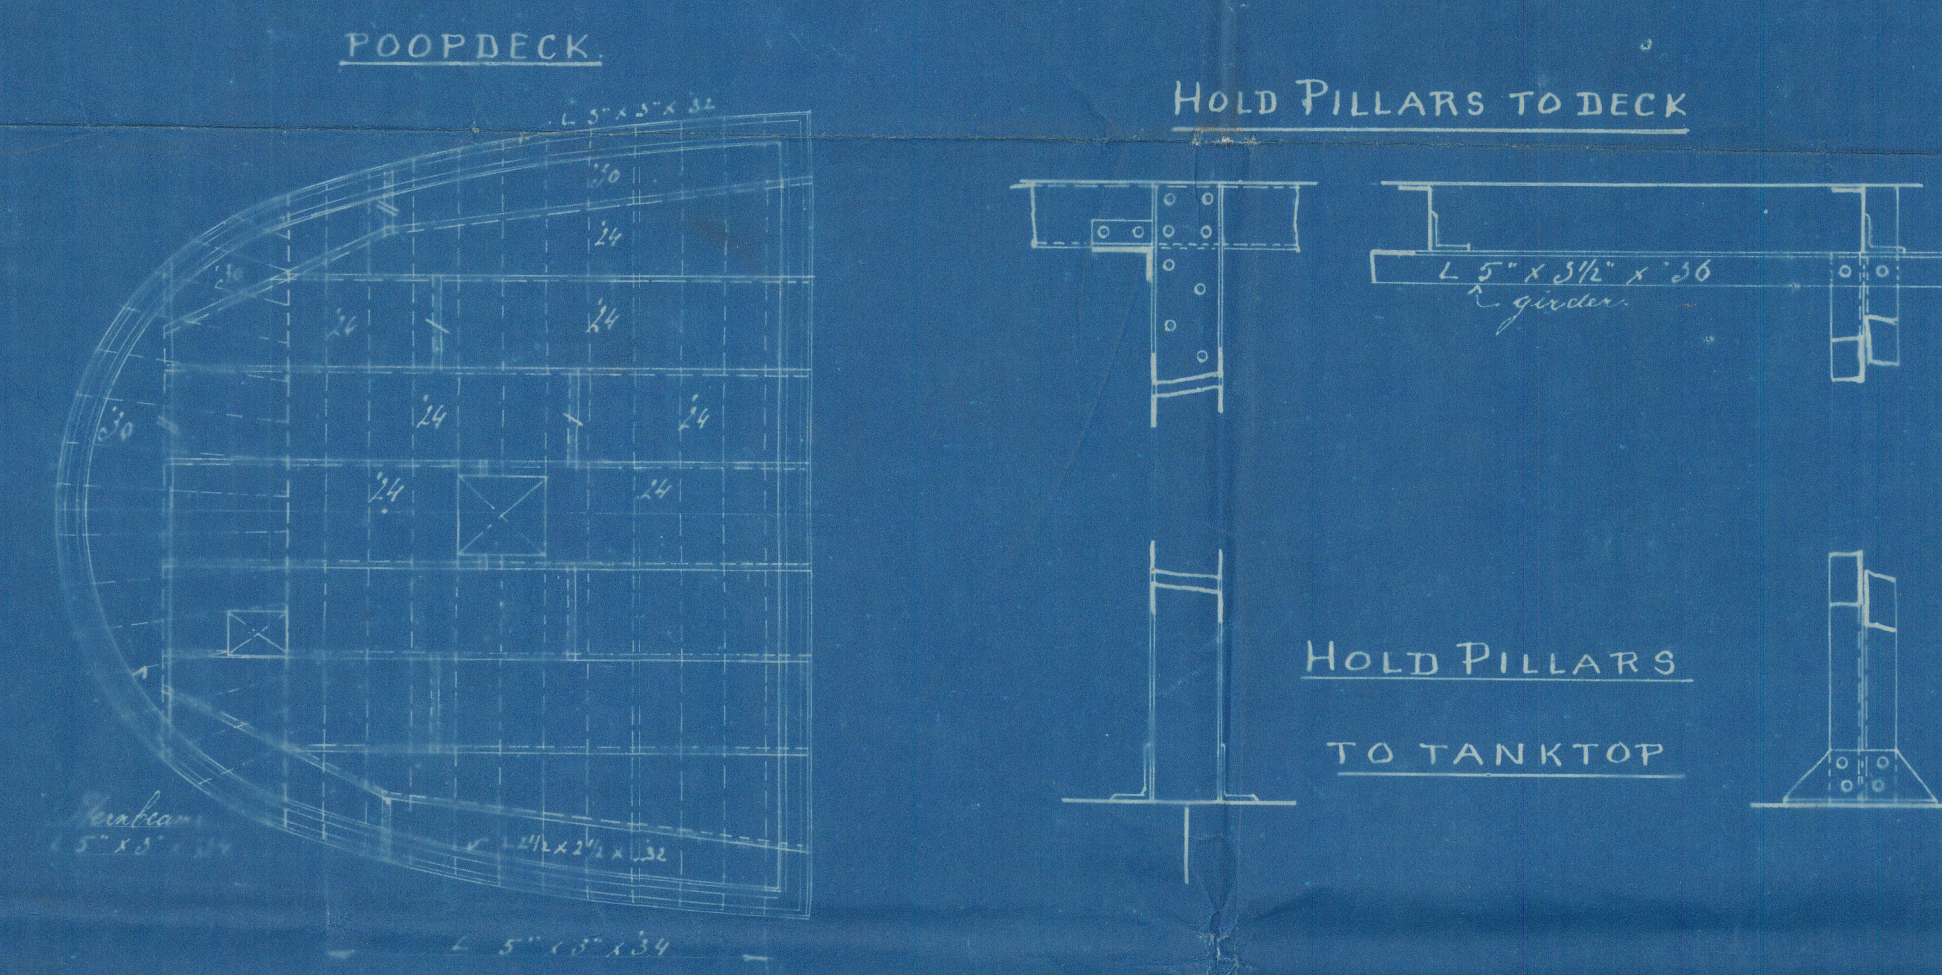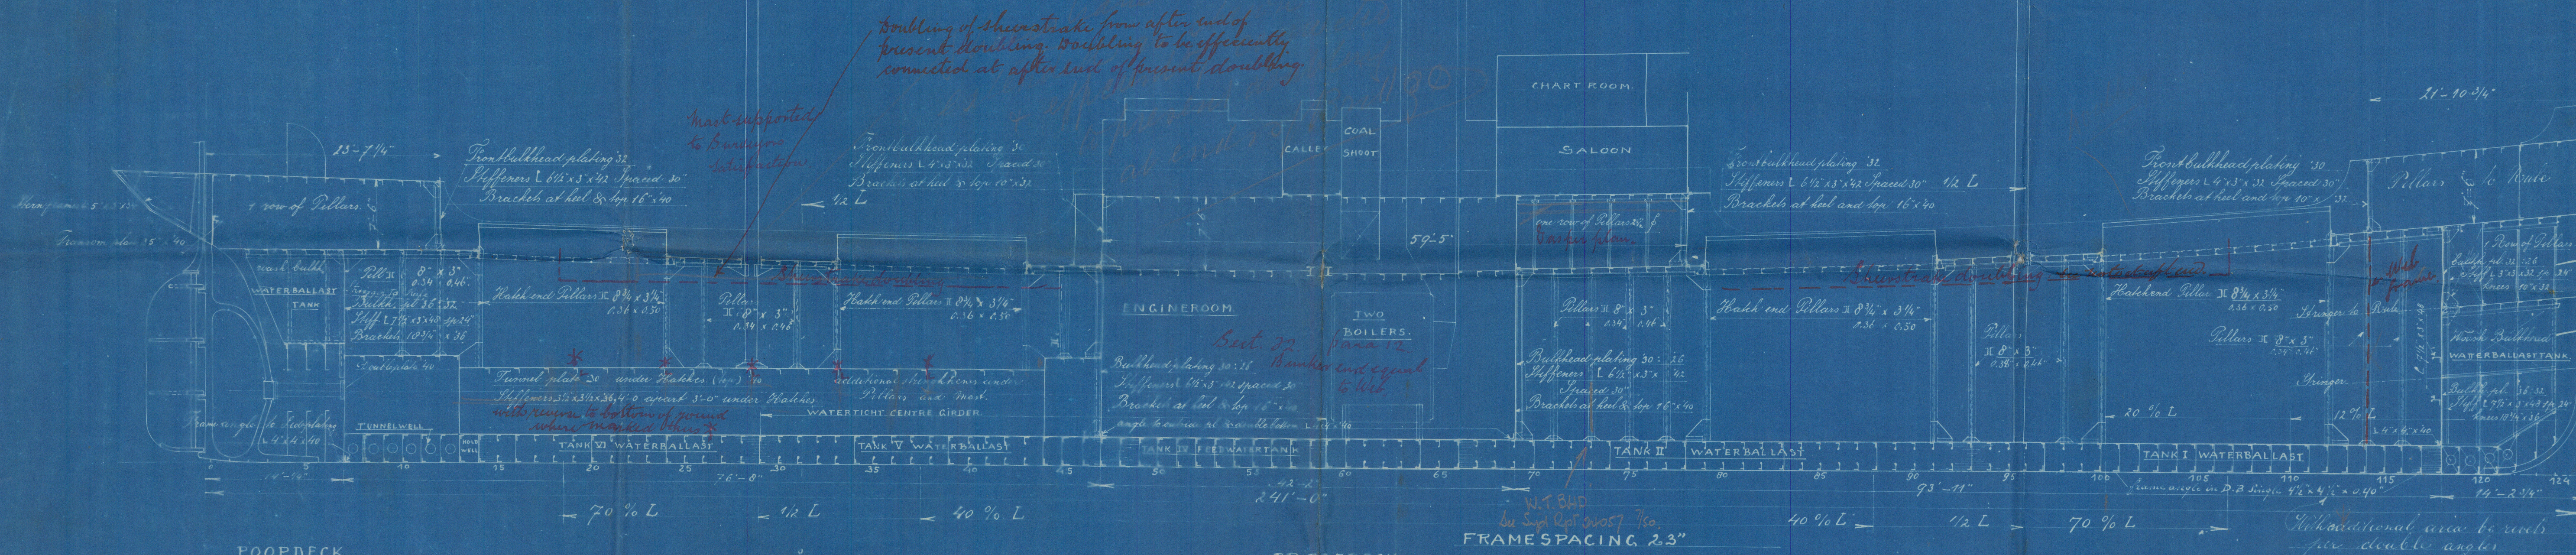

Kindred & Co. July 1921

"Lady Hobel"

Ex

Profile + Decks.

S/ " " "
S. Millewa.

Lot 11692



© 2021

Lloyd's Register
Foundation

012029-012025-0129