


FOR APPROVAL

NOTE:-

* MARK PART SHOW THE ALTERATION.

approved for No 3783,
90, 98 & 3801
8724-2-5

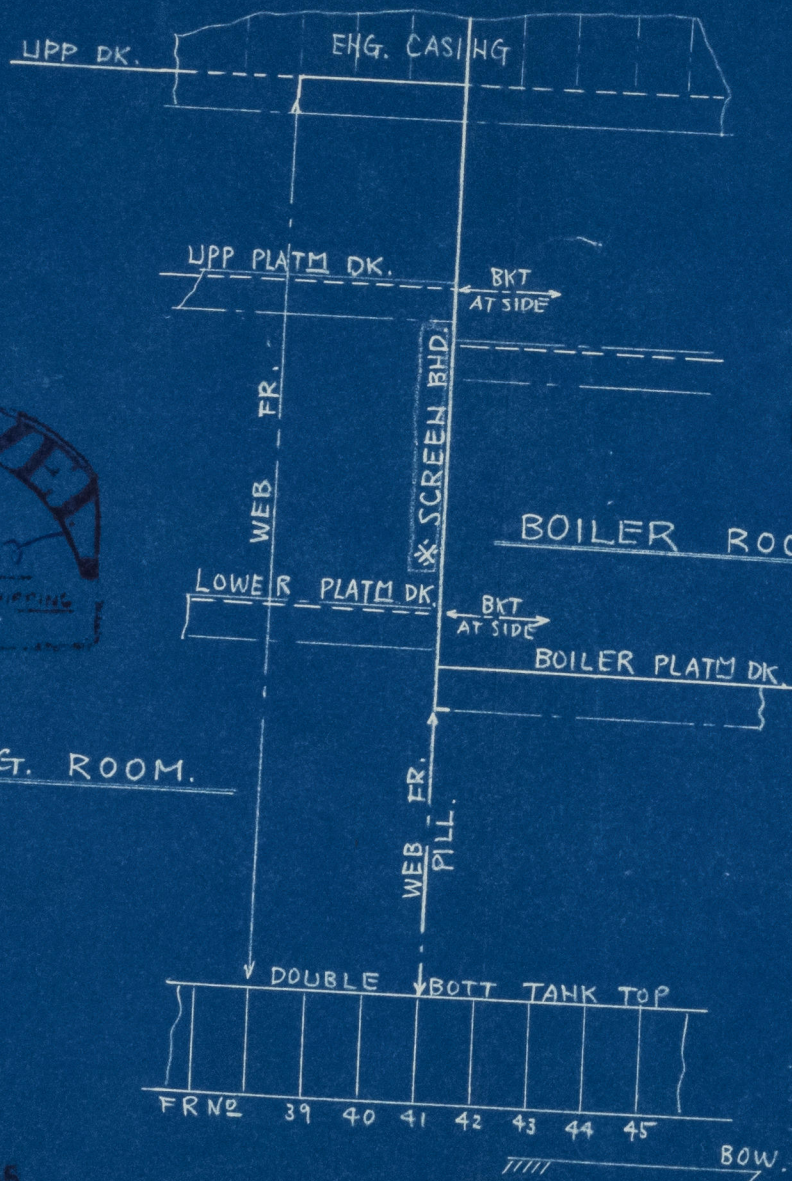

ENG. ROOM.

DESTINATION

OWNER	3
L.R.	5
1st	13
2nd	1
3rd	1
4th	1
5th	2
6th	1
計	27

SNO. 3777
INTERNATIONAL COMMERCIAL CO.,
D.W. 33,000LT.OIL TANKER.

CONSTRUCTION
PROFILE & DECKS.
(ALTERATION-1)

HITACHI
SHIP BUILDING & ENGINEERING CO., LTD.
SHIP DESIGNING DIVISION
SHIP DESIGN SECTION
OSAKA, JAPAN.

DATE 3-8-1955

DRAWN BY *Y. Yamashita*

CHECKED BY *Y. Yamashita*

REVIEWED BY *Y. Yamashita*

CHIEF OF SECT *T. T. T. T.*

CHIEF OF DIV *T. T. T. T.*

RELATED SECTION *J. Yamashita*

SHEET No H-02-1-1

DRWG No 526256

AUG - 8 1955

012124 - 0012128 - 00031