




W.T. BULKHEAD ON FR-0
OVERFLOW ABOVE POOP DECK

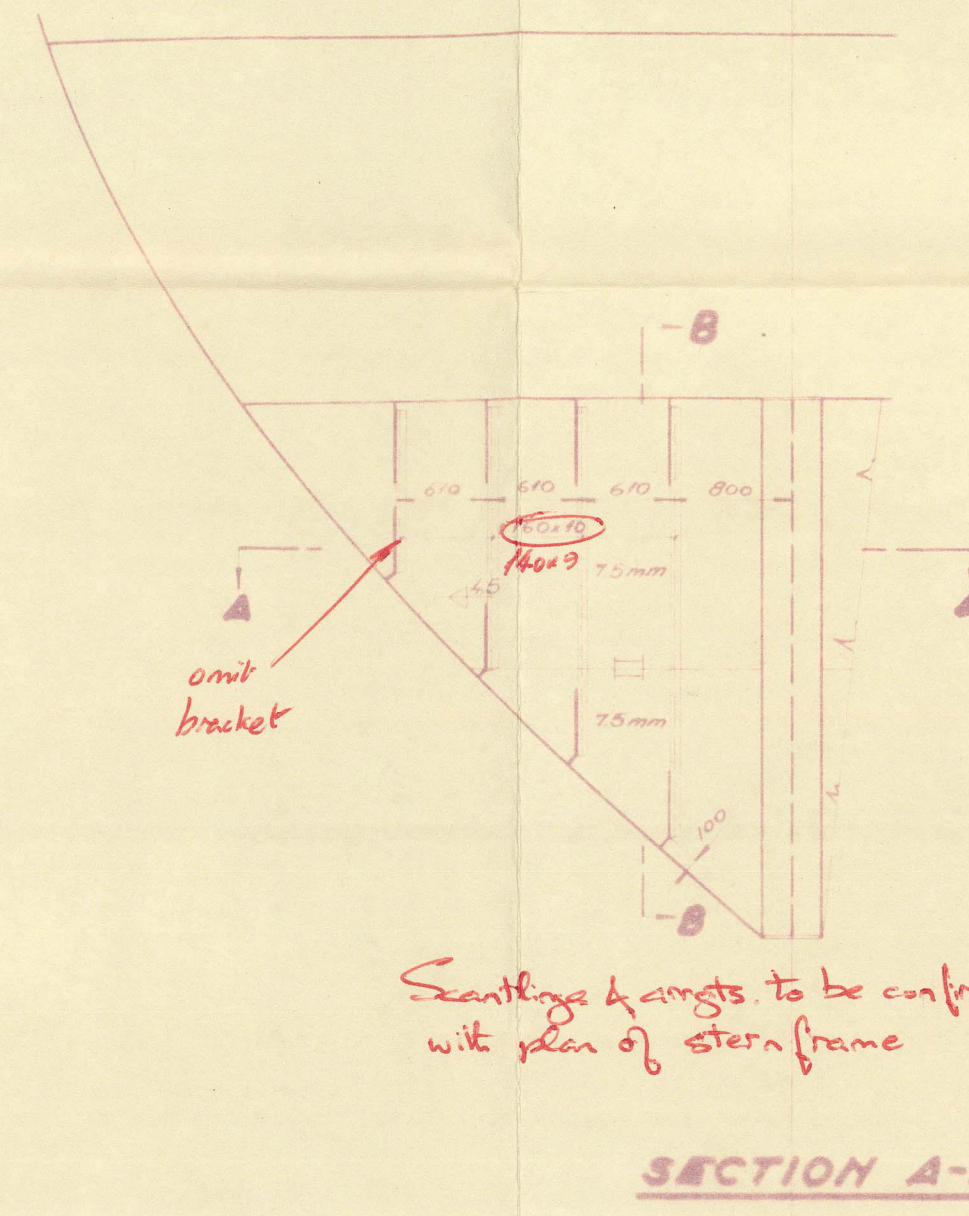


W.T. BULKHEAD ON FR-9
OVERFLOW ABOVE POOP DECK

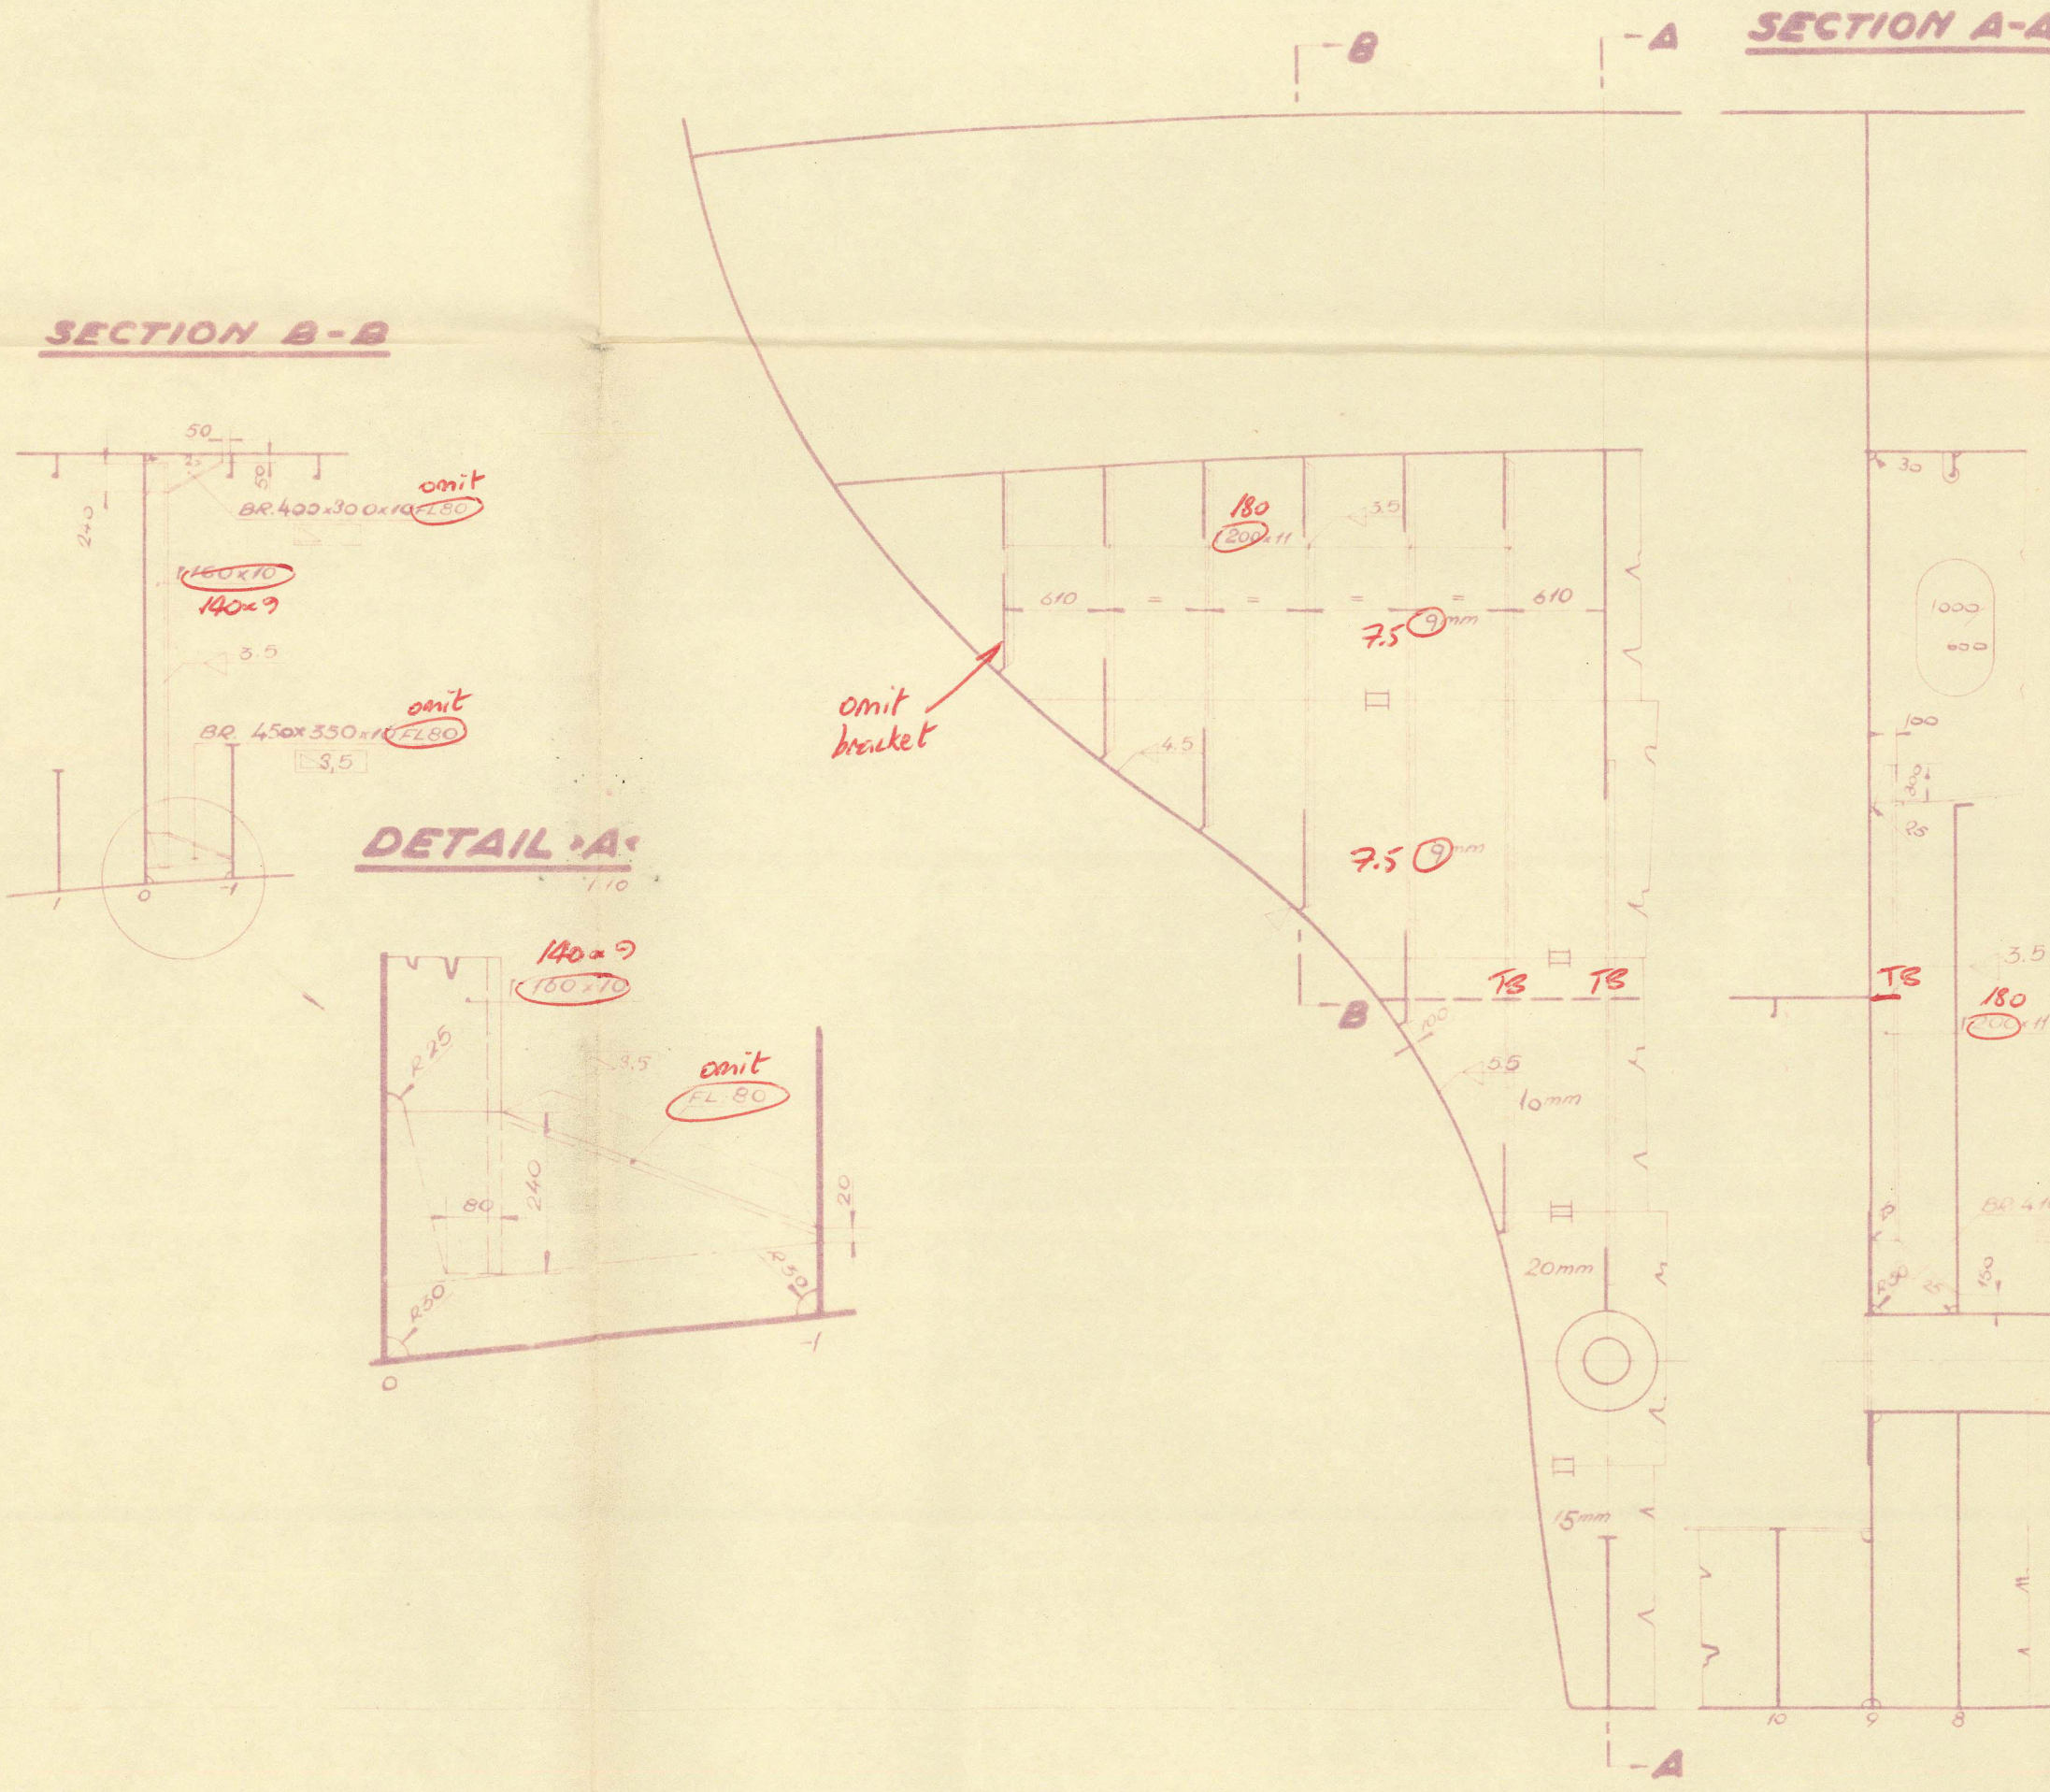


O.T. BULKHEAD ON FR-38 & 41
VIEW TO STEER AND OFFICE
OVERFLOW ABOVE POOP DECK

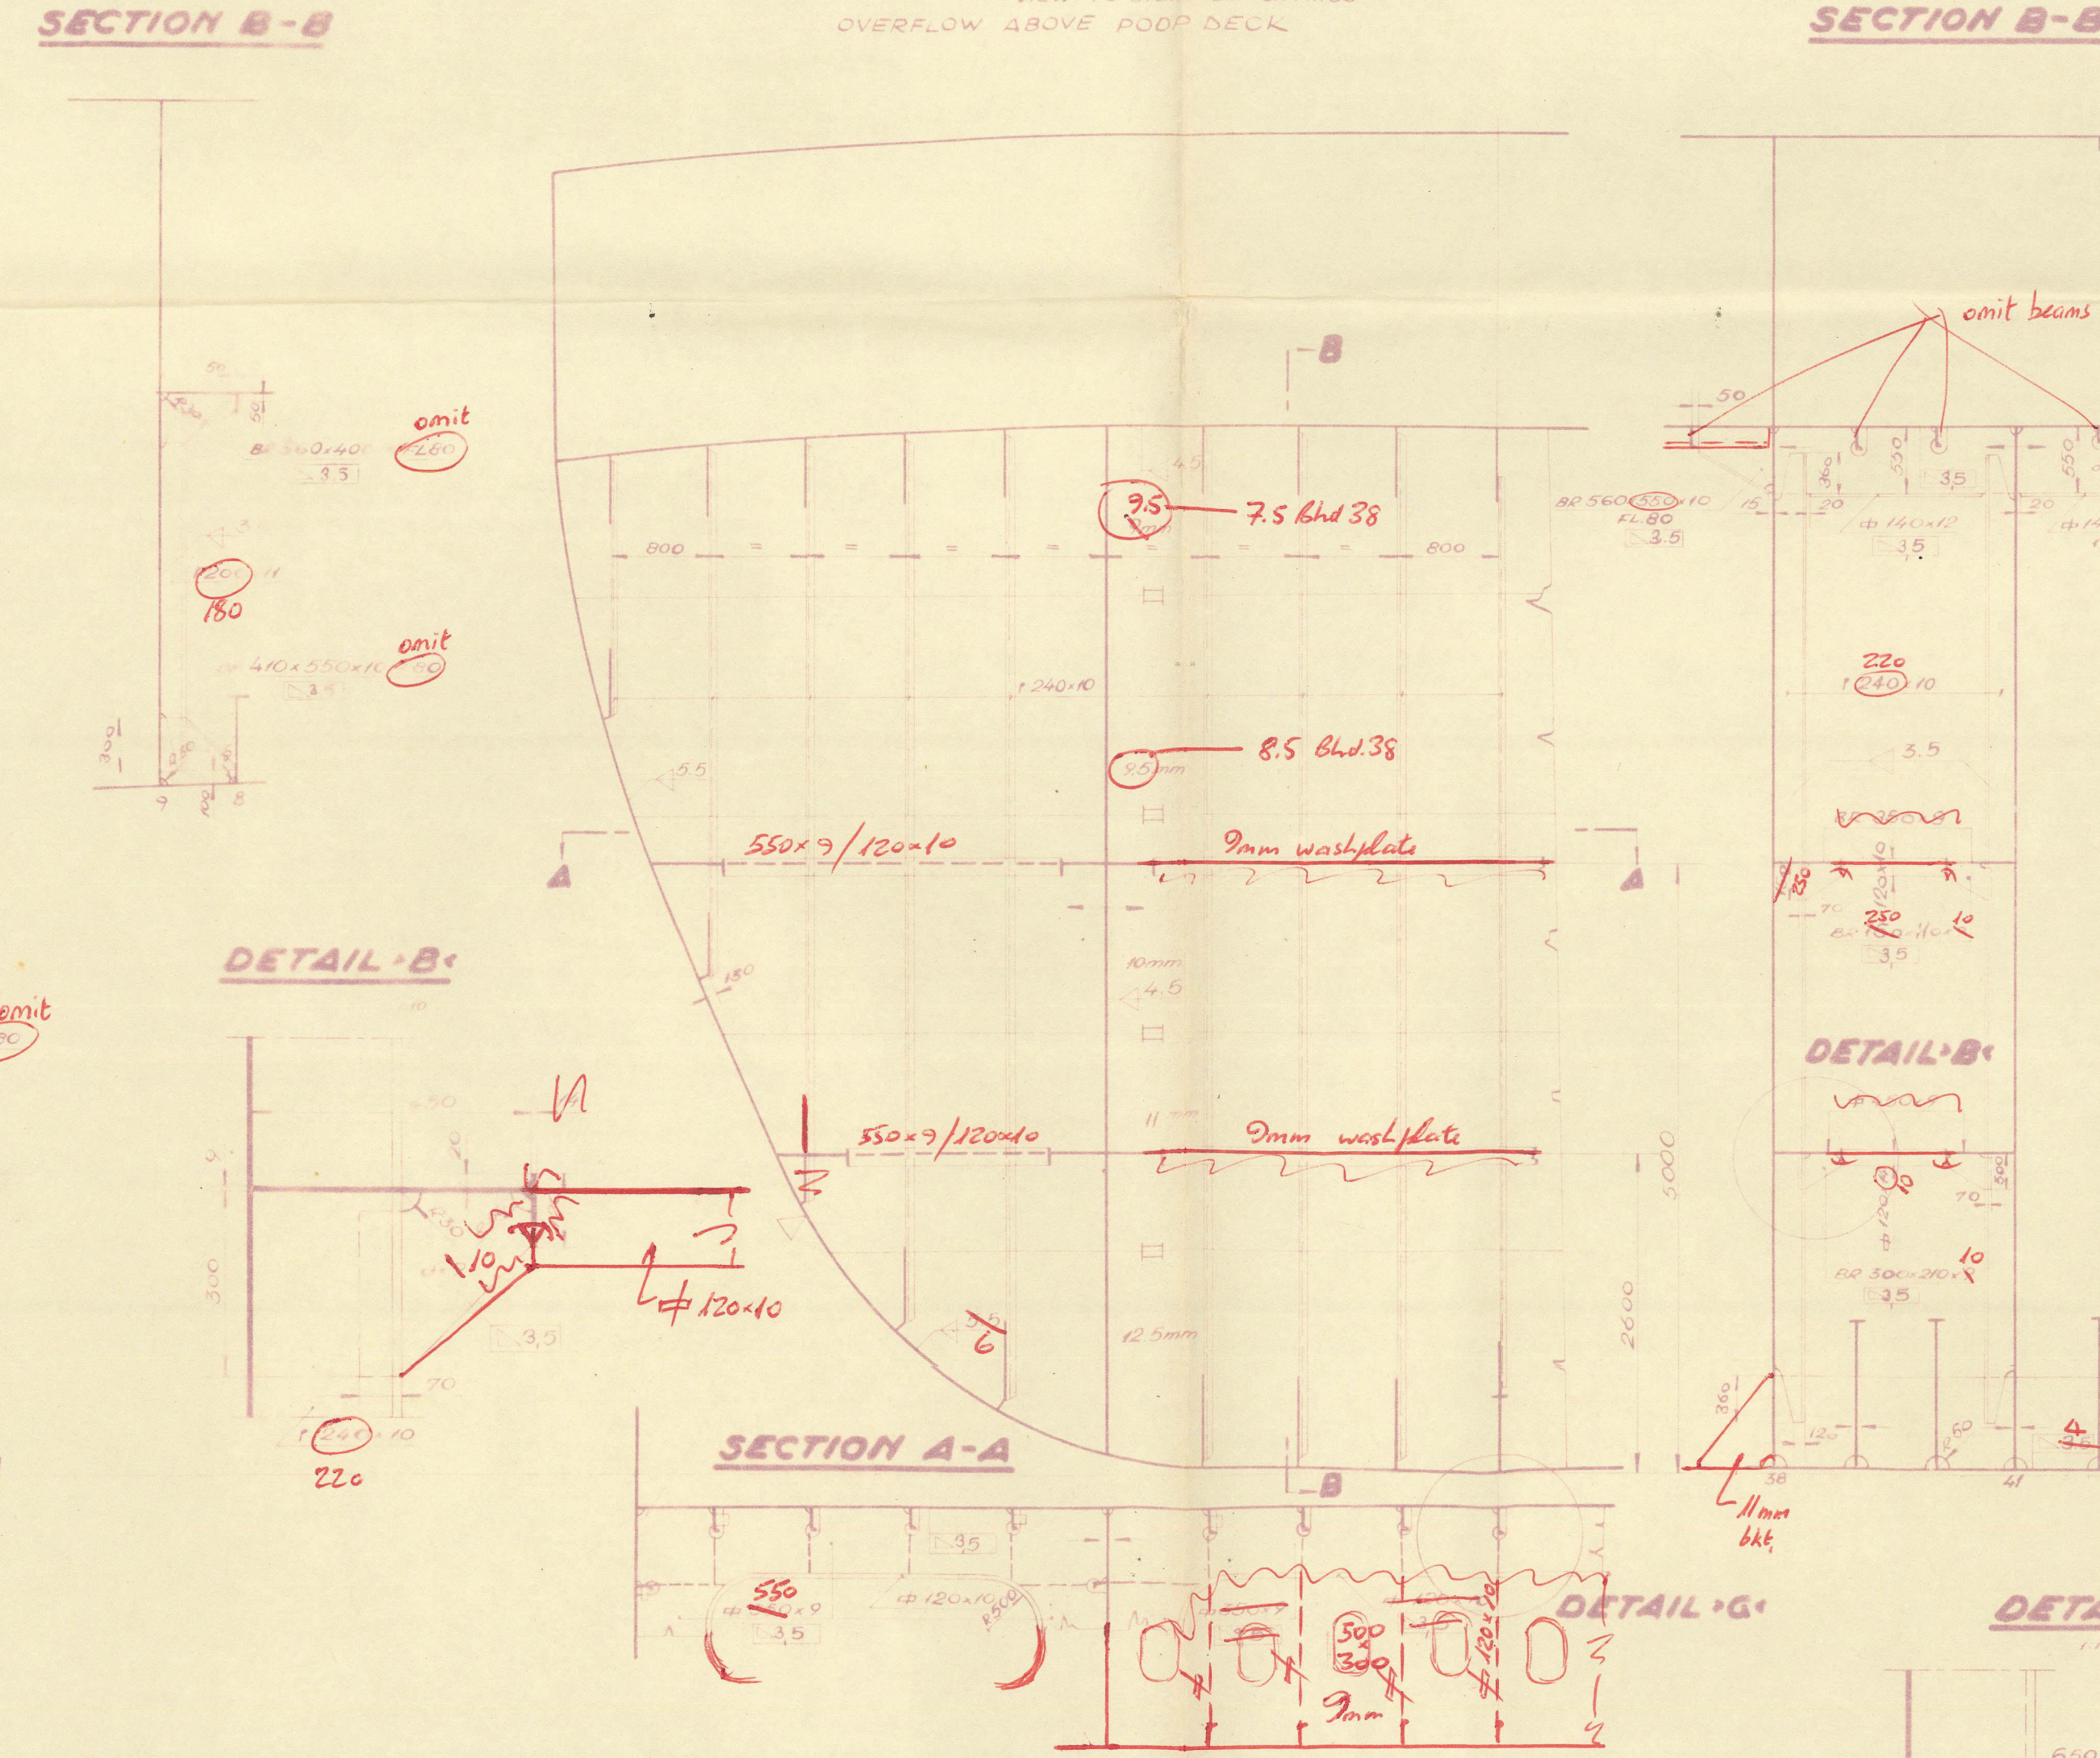


DETAIL C

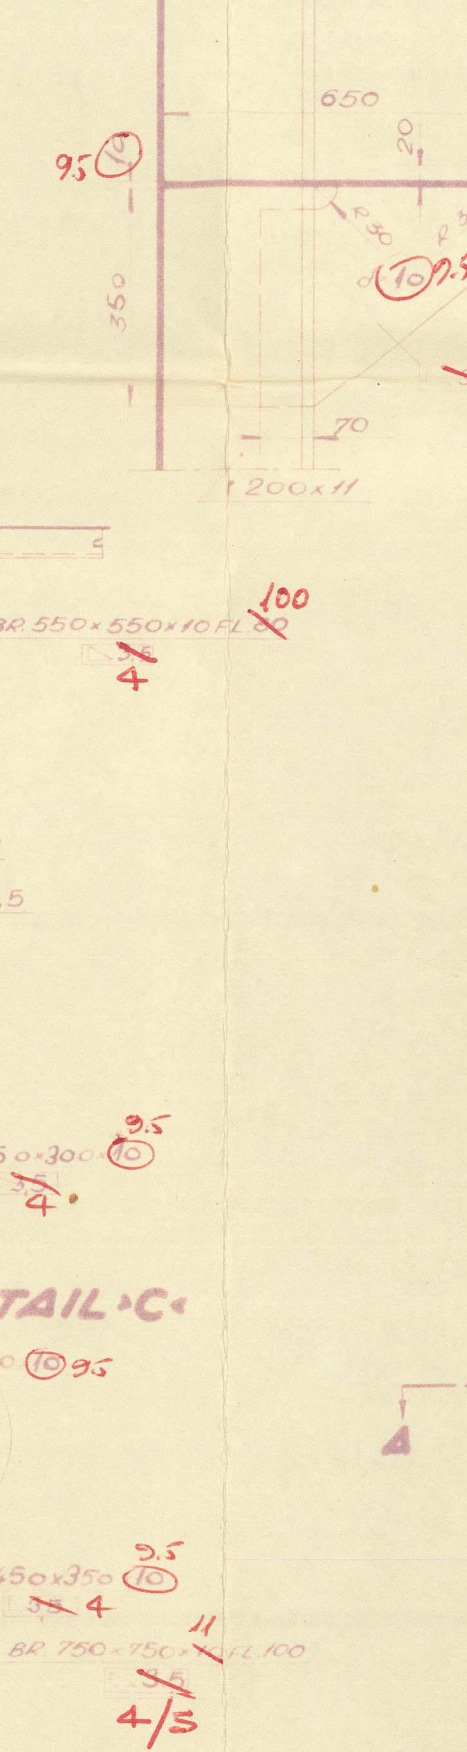


O.T. BULKHEAD ON FR-90
& BHD ON FR-43, 53, 75, 105, 122

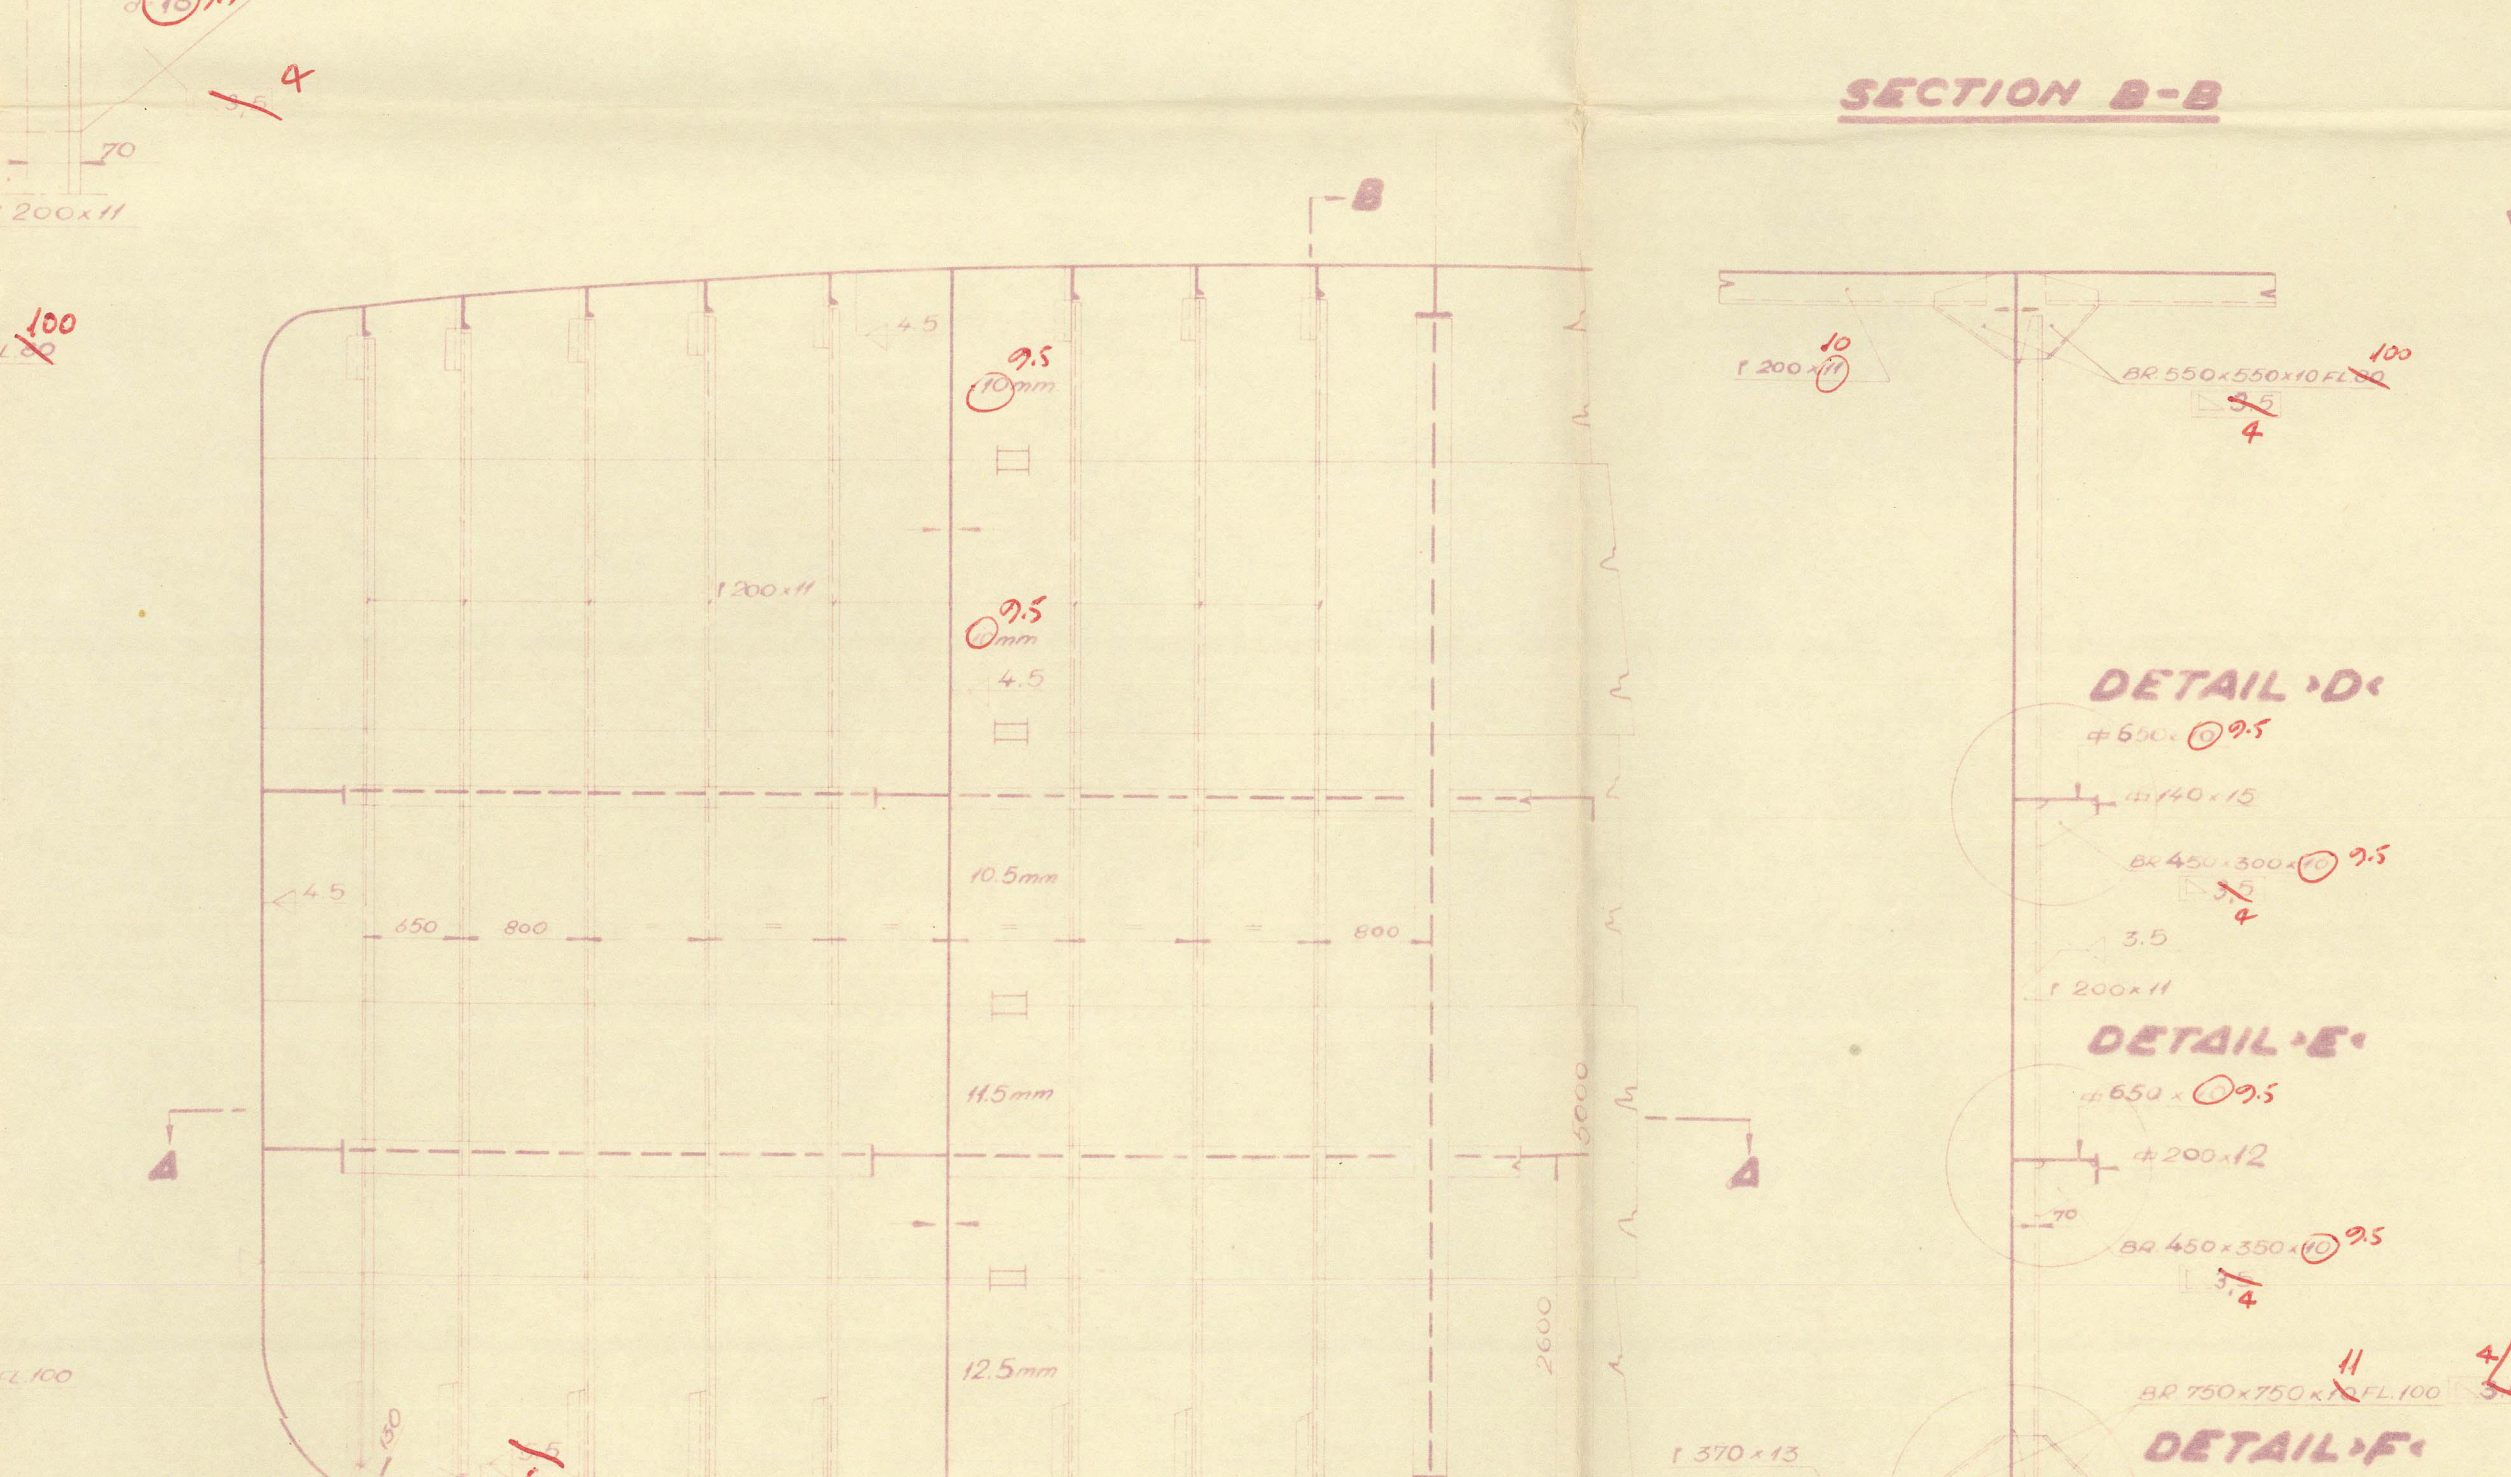


O.T. BULKHEAD ON FR-137

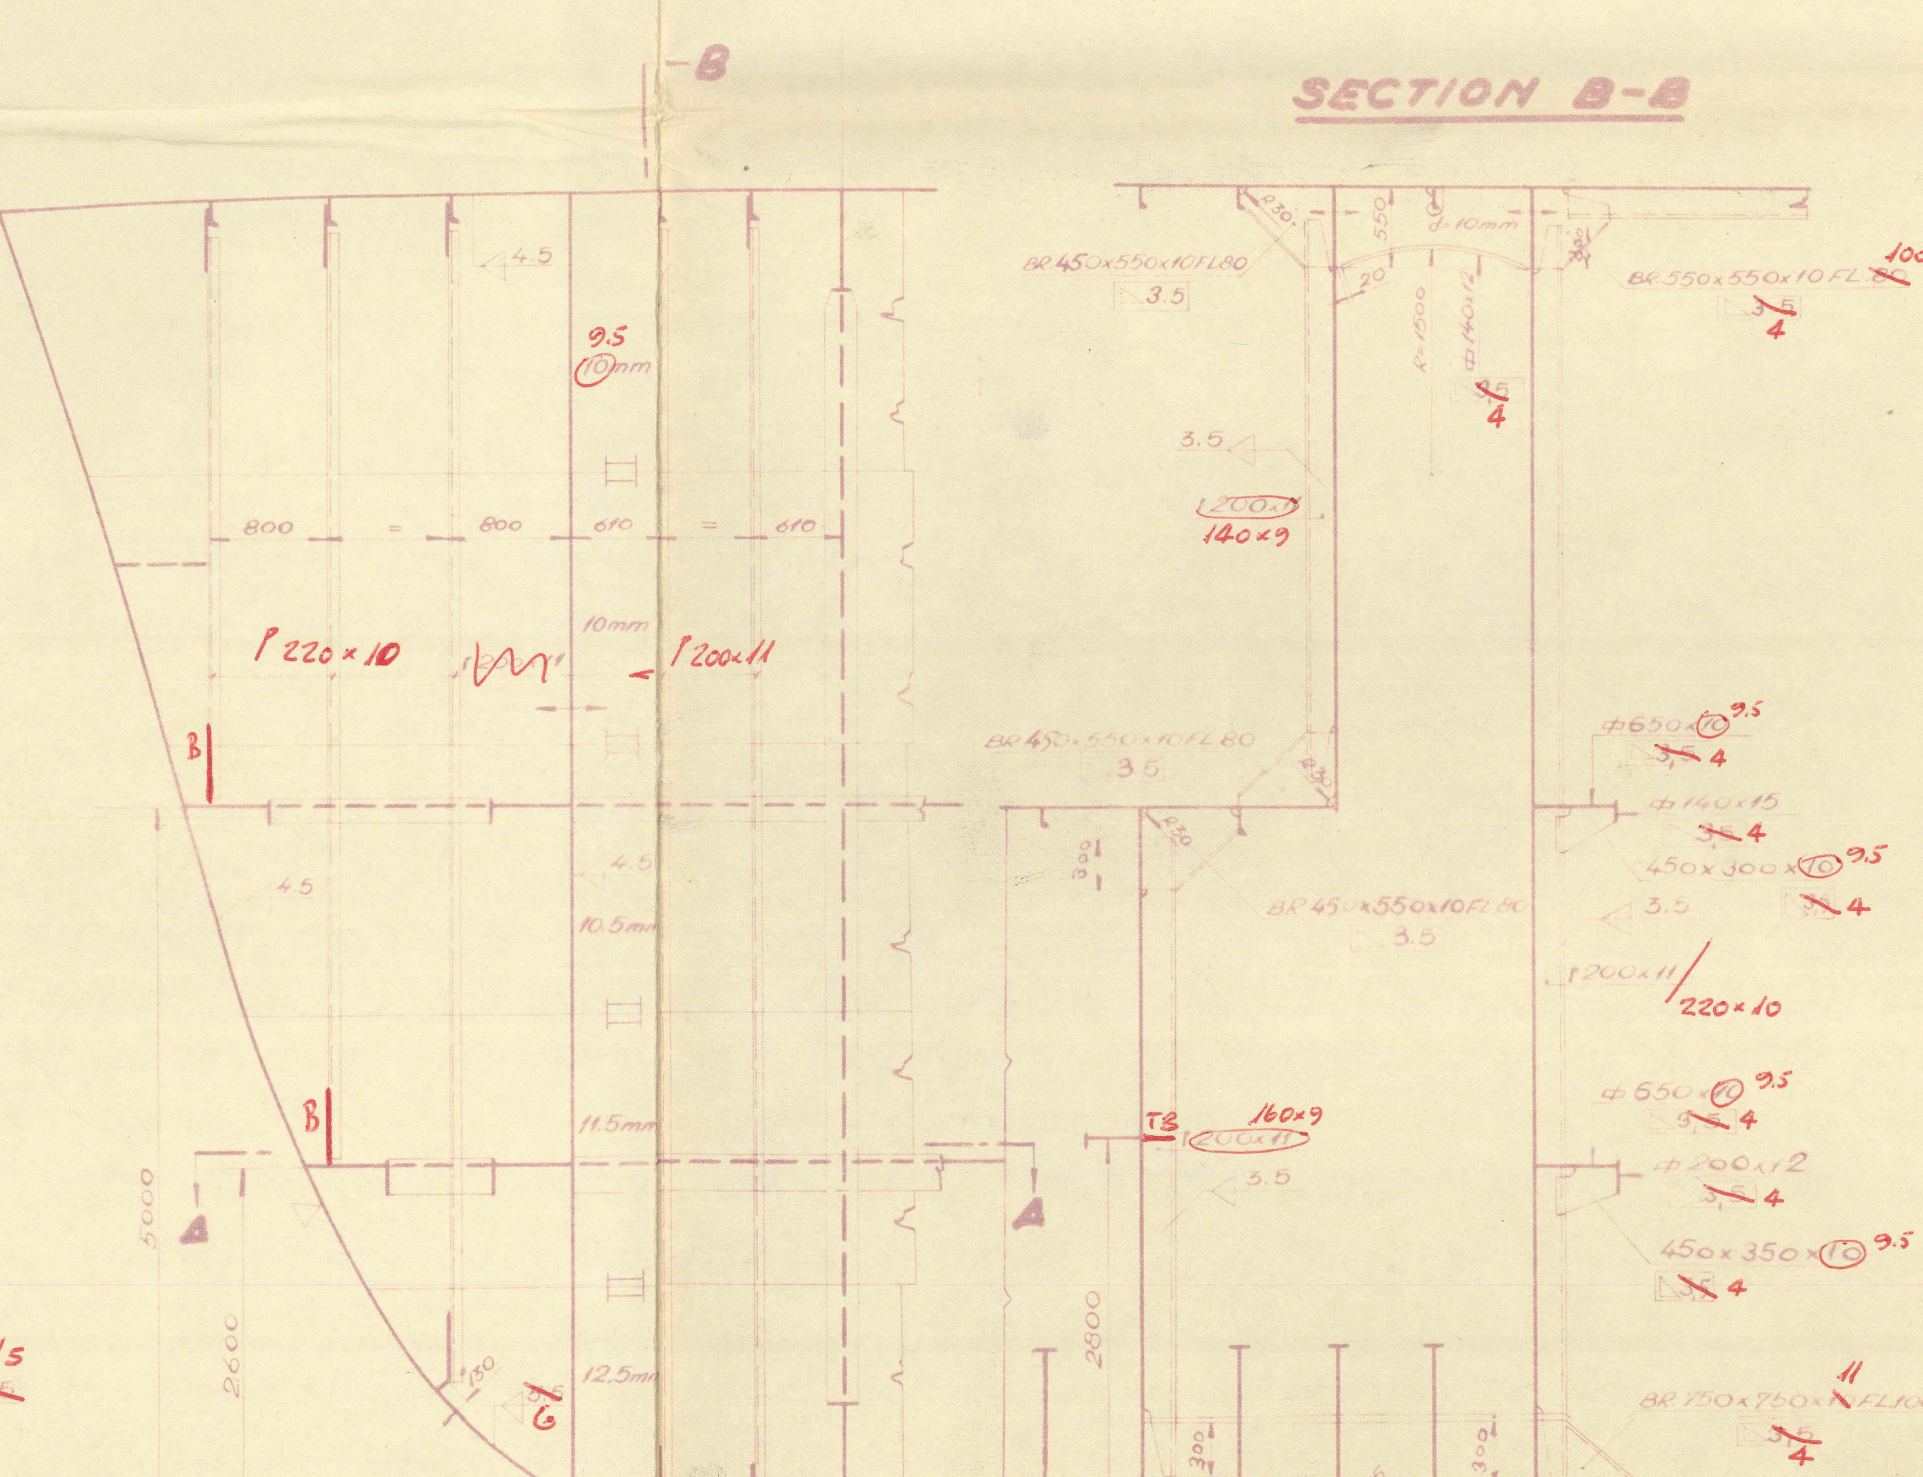


O.T. BULKHEAD ON FR-139
OVERFLOW ABOVE FORECASTLE DECK

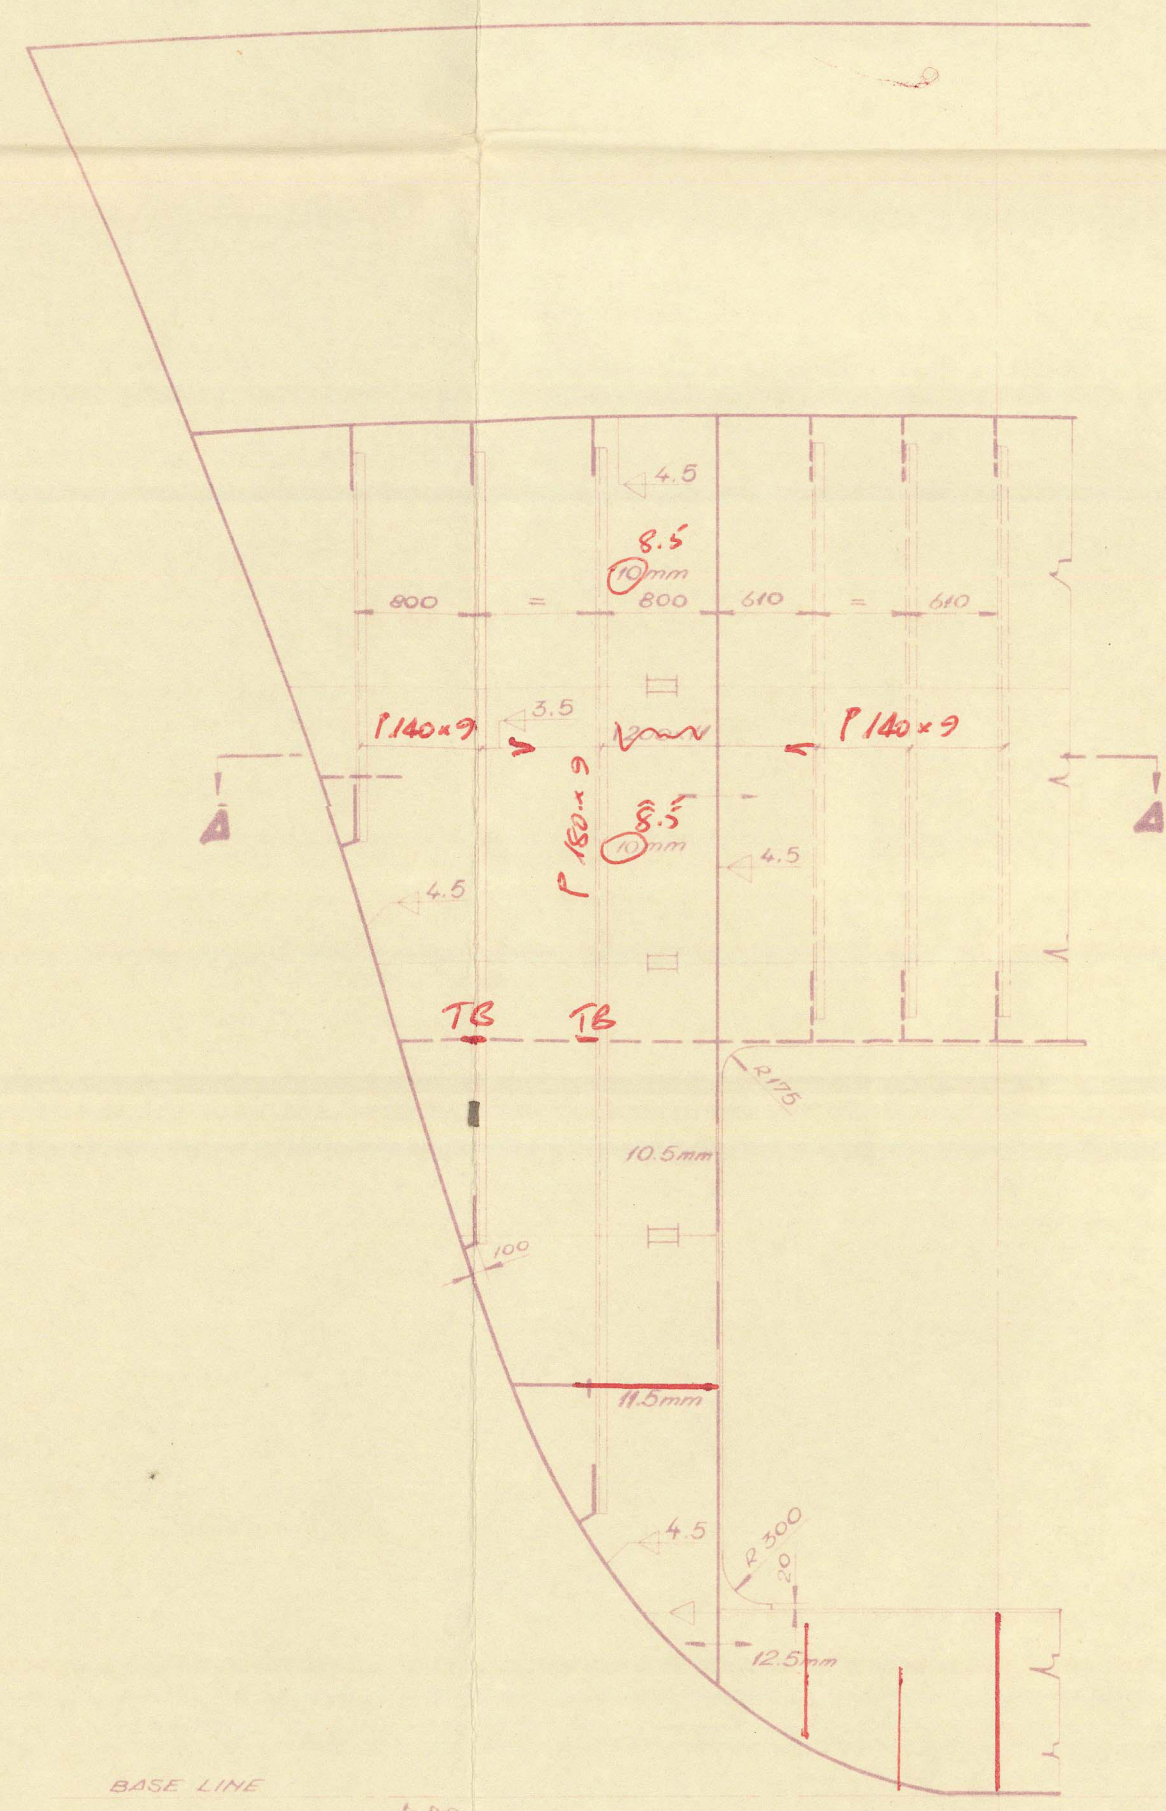


O.T. BULKHEAD ON FR-141
OVERFLOW ABOVE FORECASTLE DECK

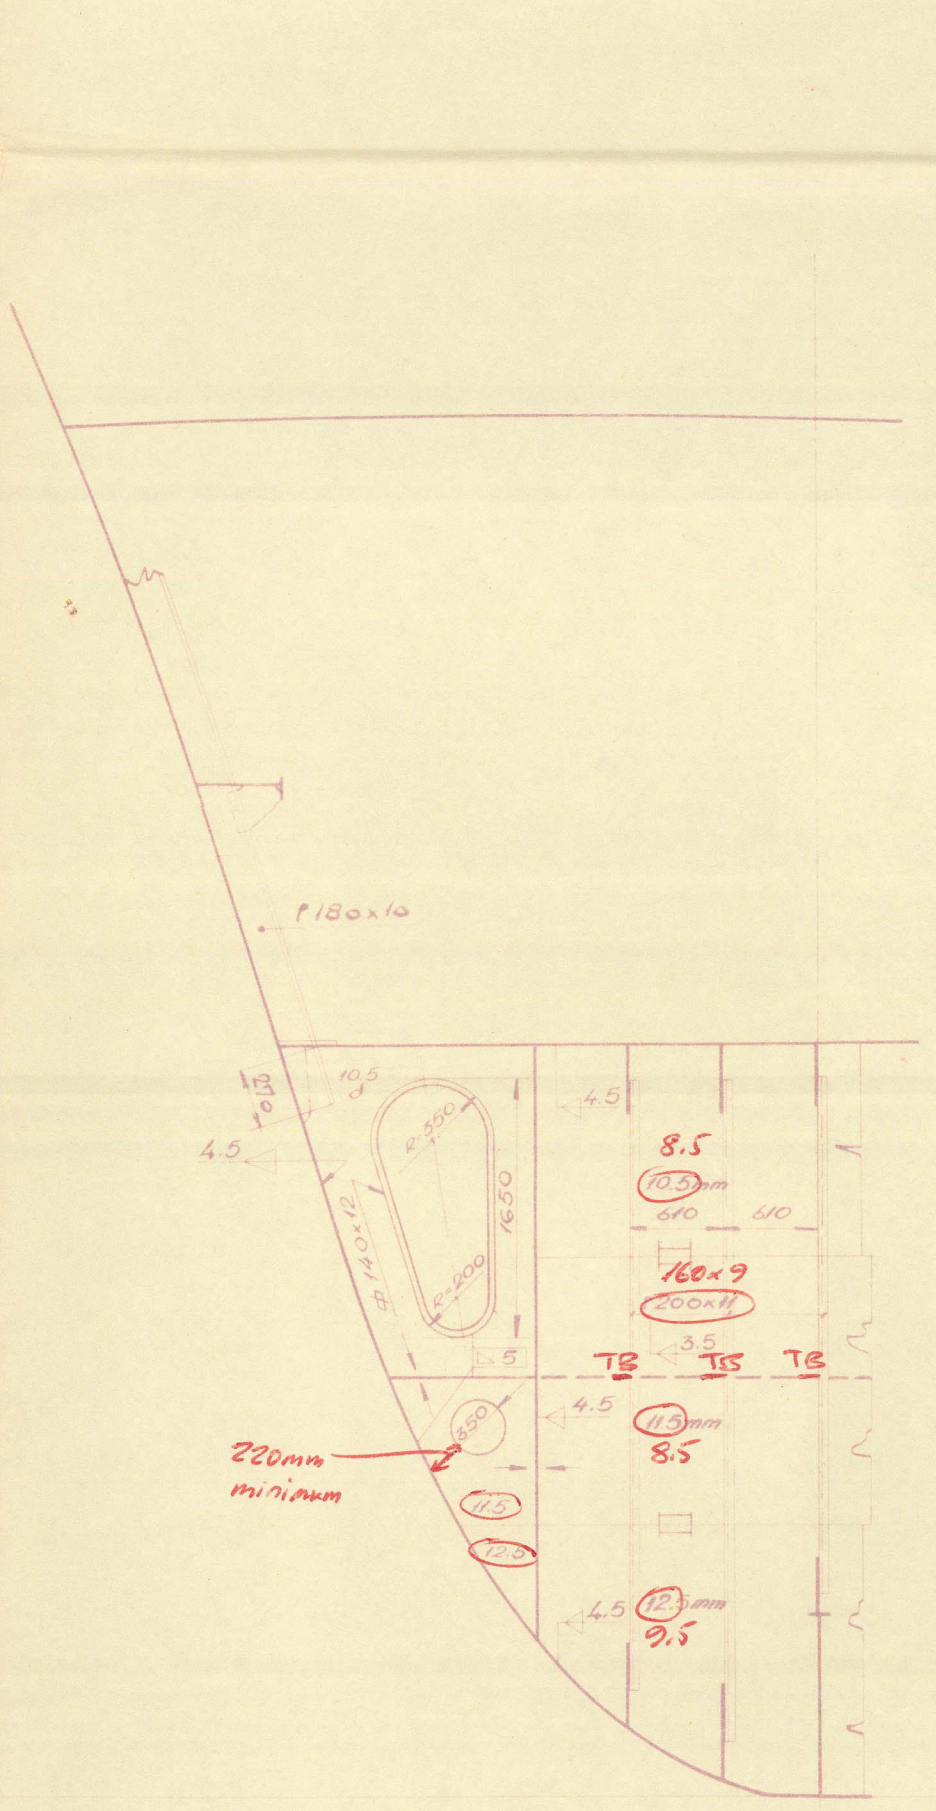


O.T. BULKHEAD ON FR-150
VIEW TO STEER
OVERFLOW ABOVE FORECASTLE DECK

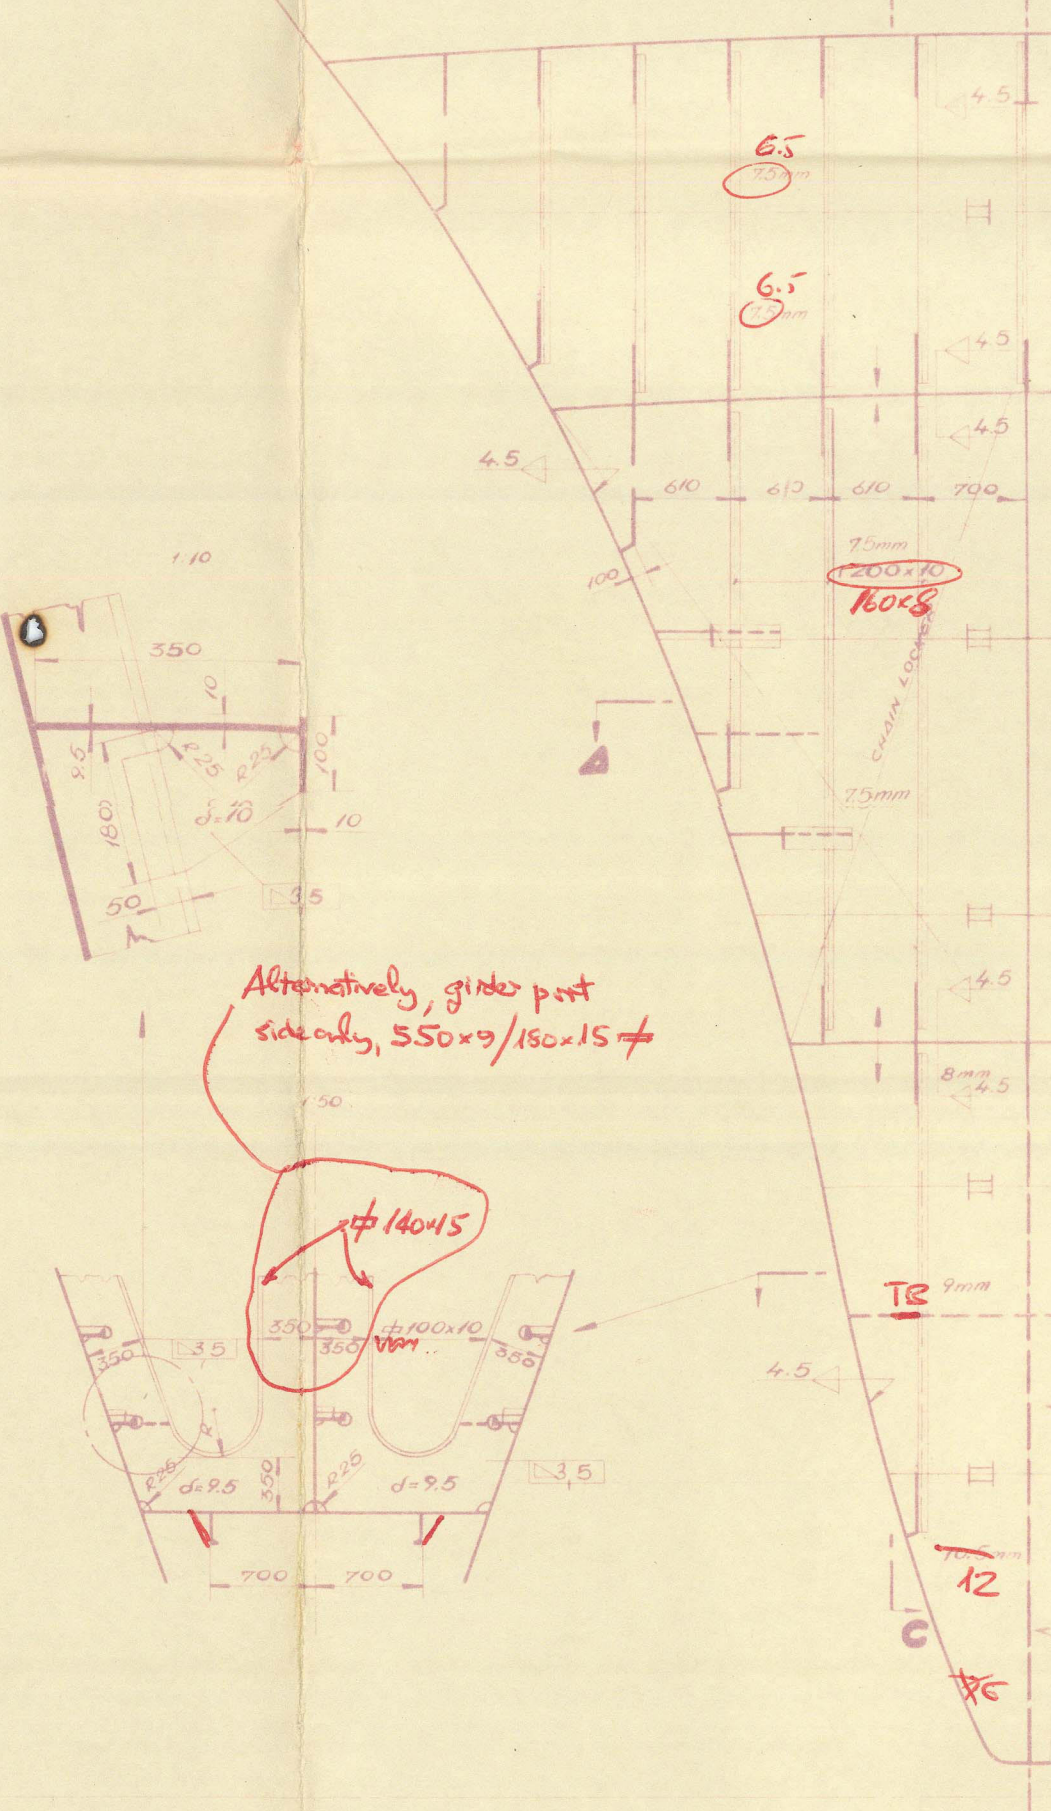


SECTION B-B

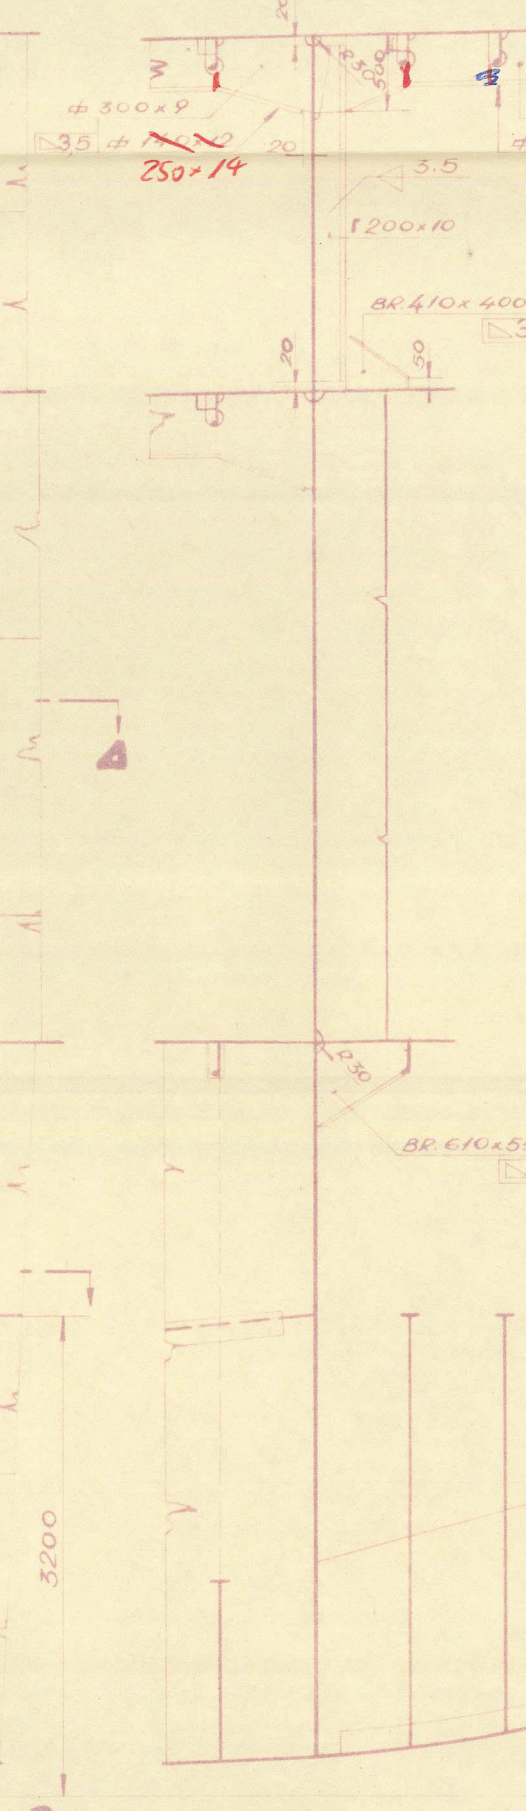


SECTION C-C

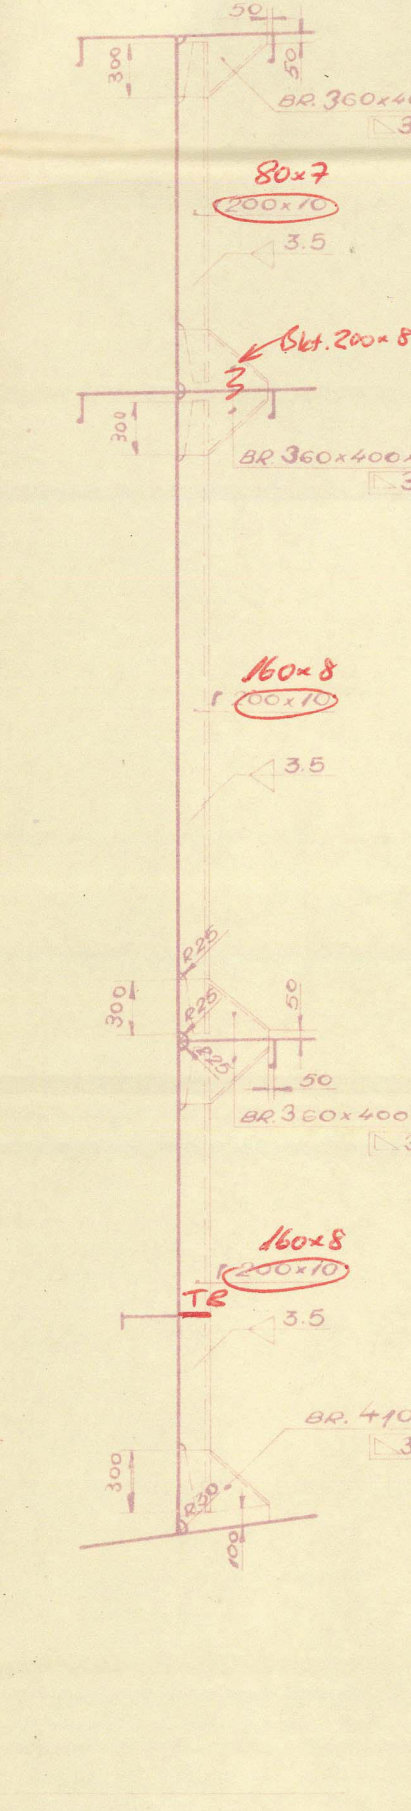

DETAIL D

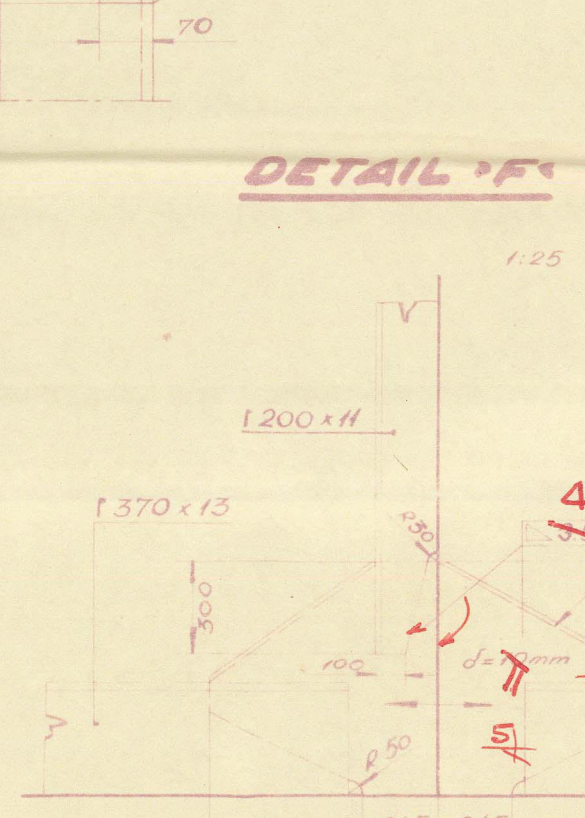

DETAIL G

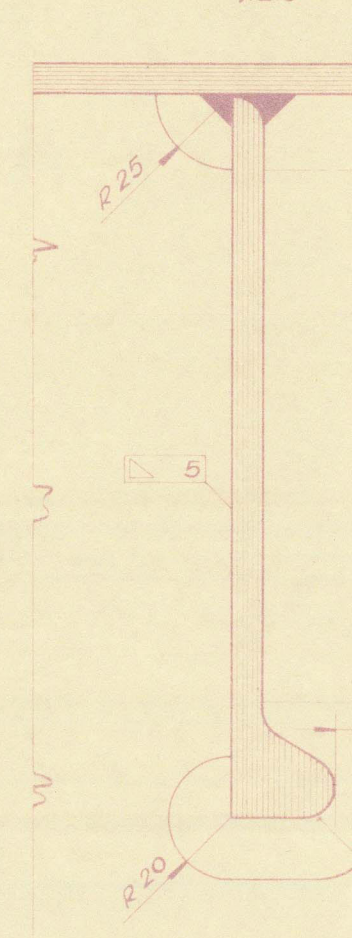

NOTE:

THE DRAWING SHOWS THE STERN VIEW
OF THE BULKHEAD.



Surveyors' Copy

KOMADA		PREDMET		POS. MATERIAL. OPASKA		JEDIN. UPOIN	
DAT. INDEK. POIS.		PRONJENE I DOPUNE		TJEZINA		TJEZINA	
LZ		LZ		LZ		LZ	

716

'J. L. MOSOR' - TROAR

YARD No 137


NAME OF SHIP	R. I. SORONG	★
TO ACCOMPANY	SPLIT	REPORT No. 2539/FE
DATED	17.4.65	

No 7711: O.T. & W.T. BULKHEADS

THIS PLAN HAS NOT BEEN
ANNOTATED
See accompanying »AS BUILT« plans

RECORDS DEPT.,
LONDON.

10

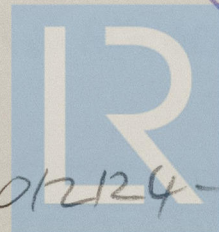

© 2020

Lloyd's Register
Foundation

012124-02128-0071