

19.12.33




— YARD NO 53. — **— MIDSHIP SECTION —** SCALE 1/25

DIMENSIONS		
LENGTH BETWEEN PP	455.0	41.225 MTR
BREADTH MOULDED	62.4	18.807
DEPTH MOULDED (TO UPPERDECK)	34.3	10.422
HEIGHT OF POOP	7.8	2.382
BRIDGE	7.0	2.134
FORECASTLE	7.0	2.140
CLASS: LLOYDS 100 A1 CARRYING PETROLEUM IN BULK		
LONGITUDINAL FRAMES IN CENTER TANKS AND TRANSVERSE FRAMES IN SIDETANKS		
DIMENSIONS OF BRIDGE AND FORECASTLE		

ALL BULL SECTIONS ARE BASED ON THE 1924 STANDARDS		

EQUIPMENT LETTERS C	
3 BOWER ANCHORS STOCKLESS 2 AT 27 CENT (COLLECTIVE WEIGHT 215 ACFT)	
1 STEAM	22
2 STEAM	22
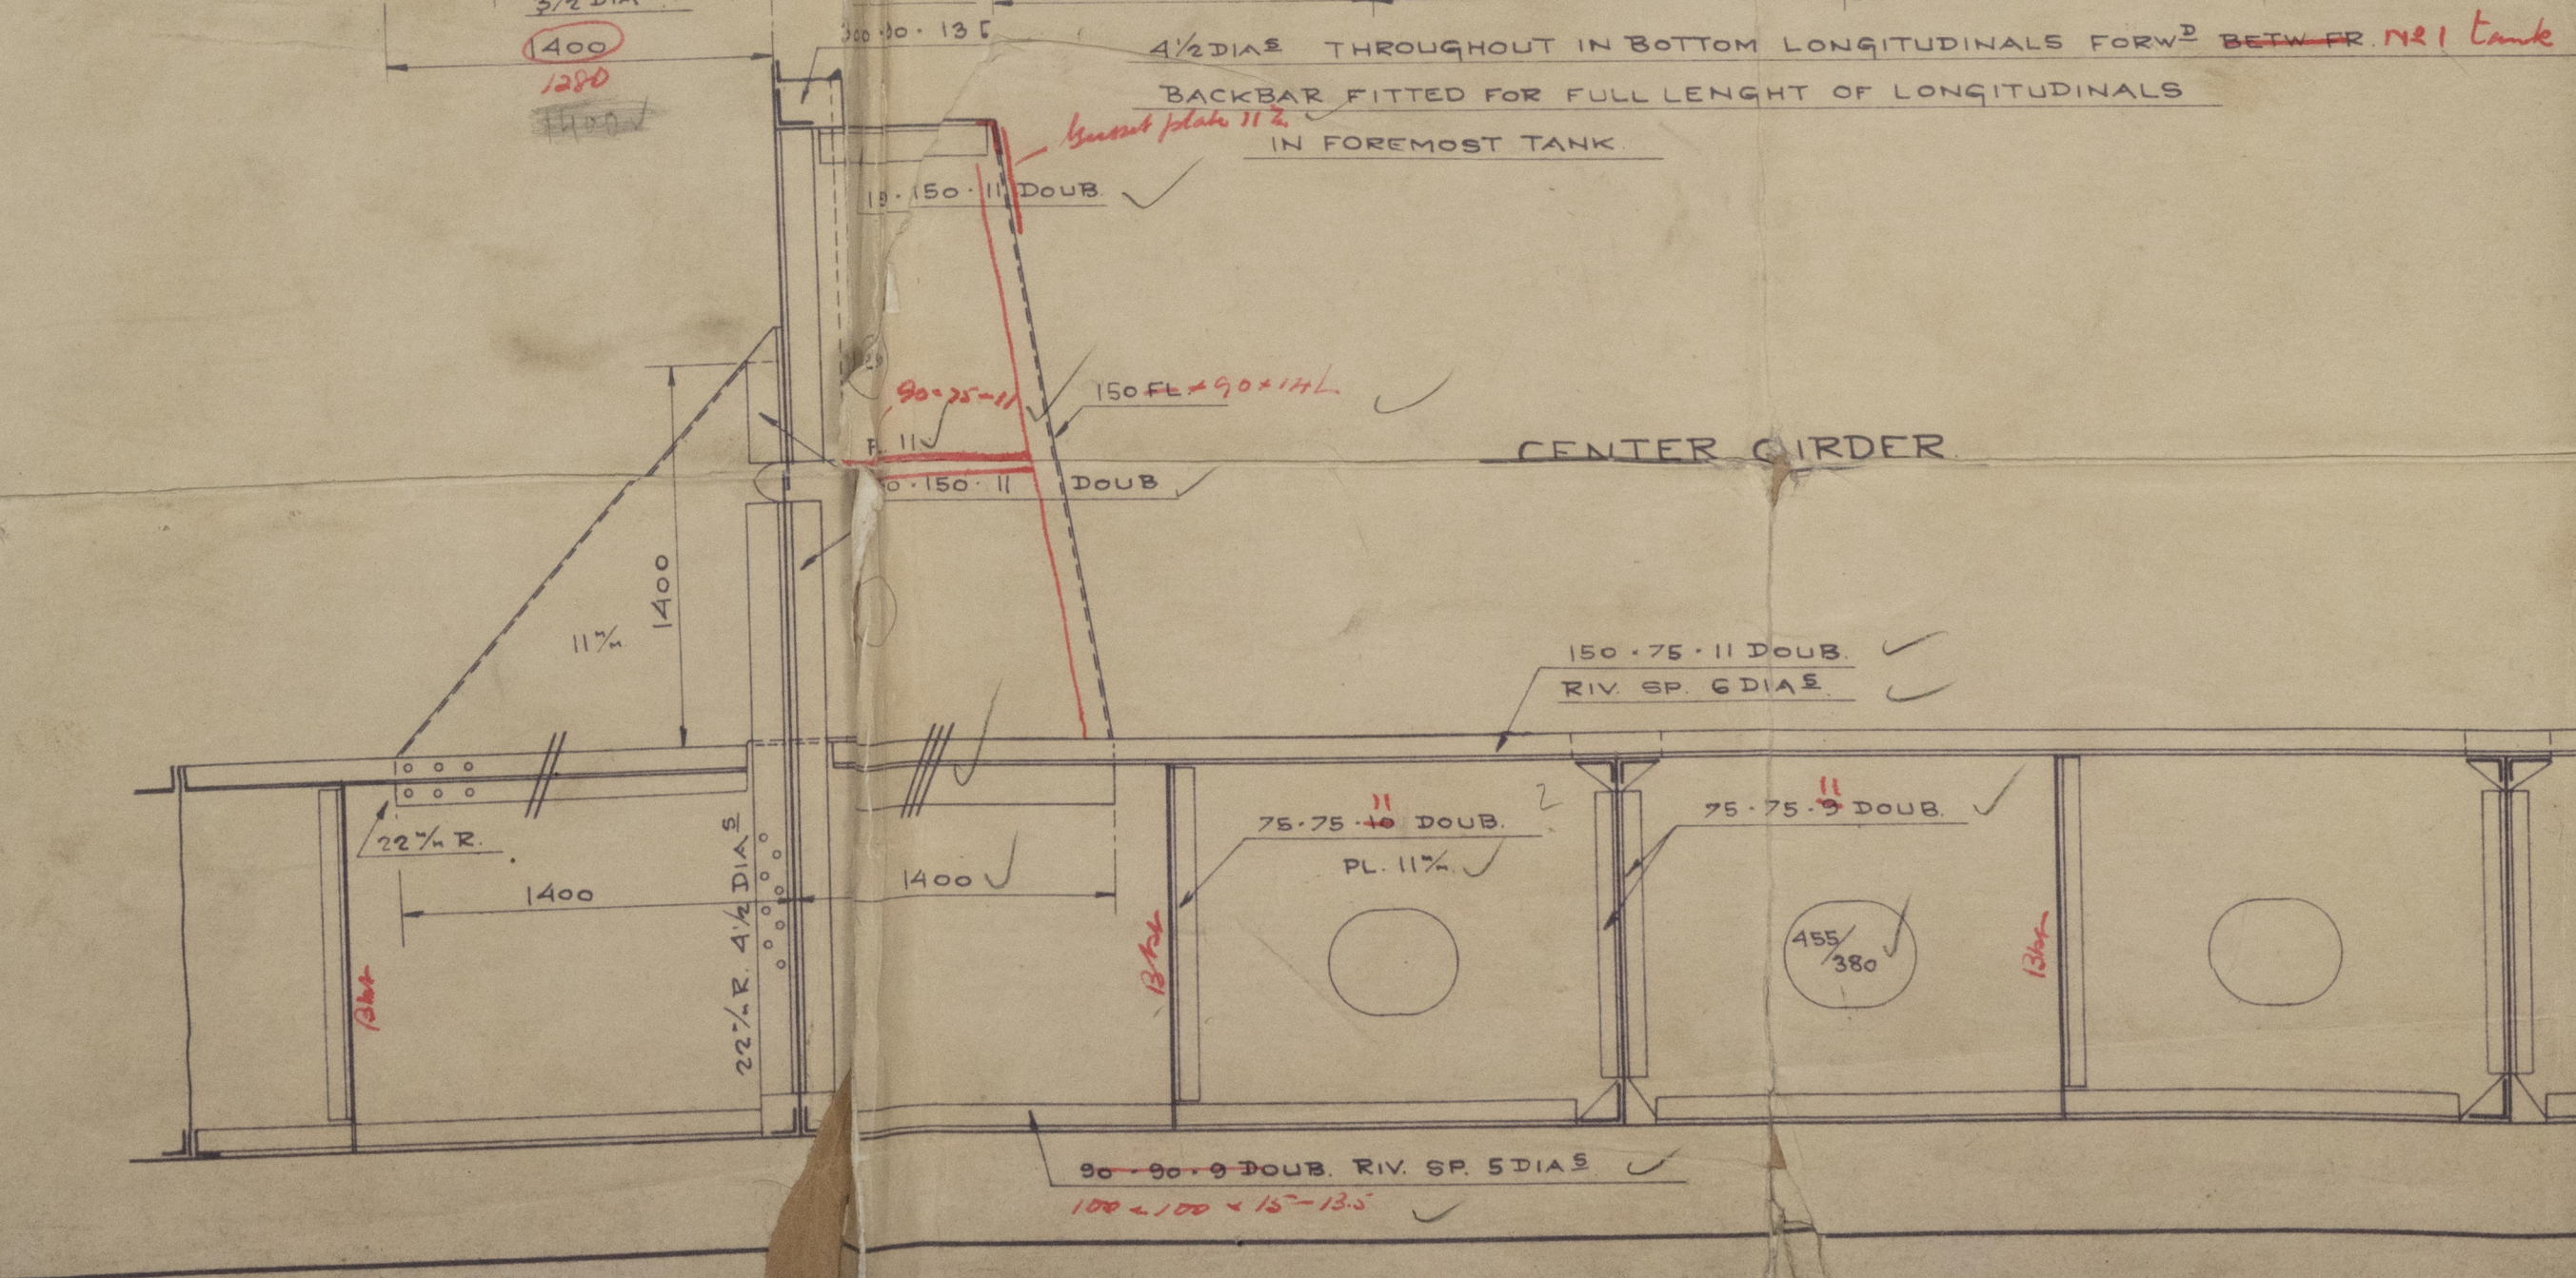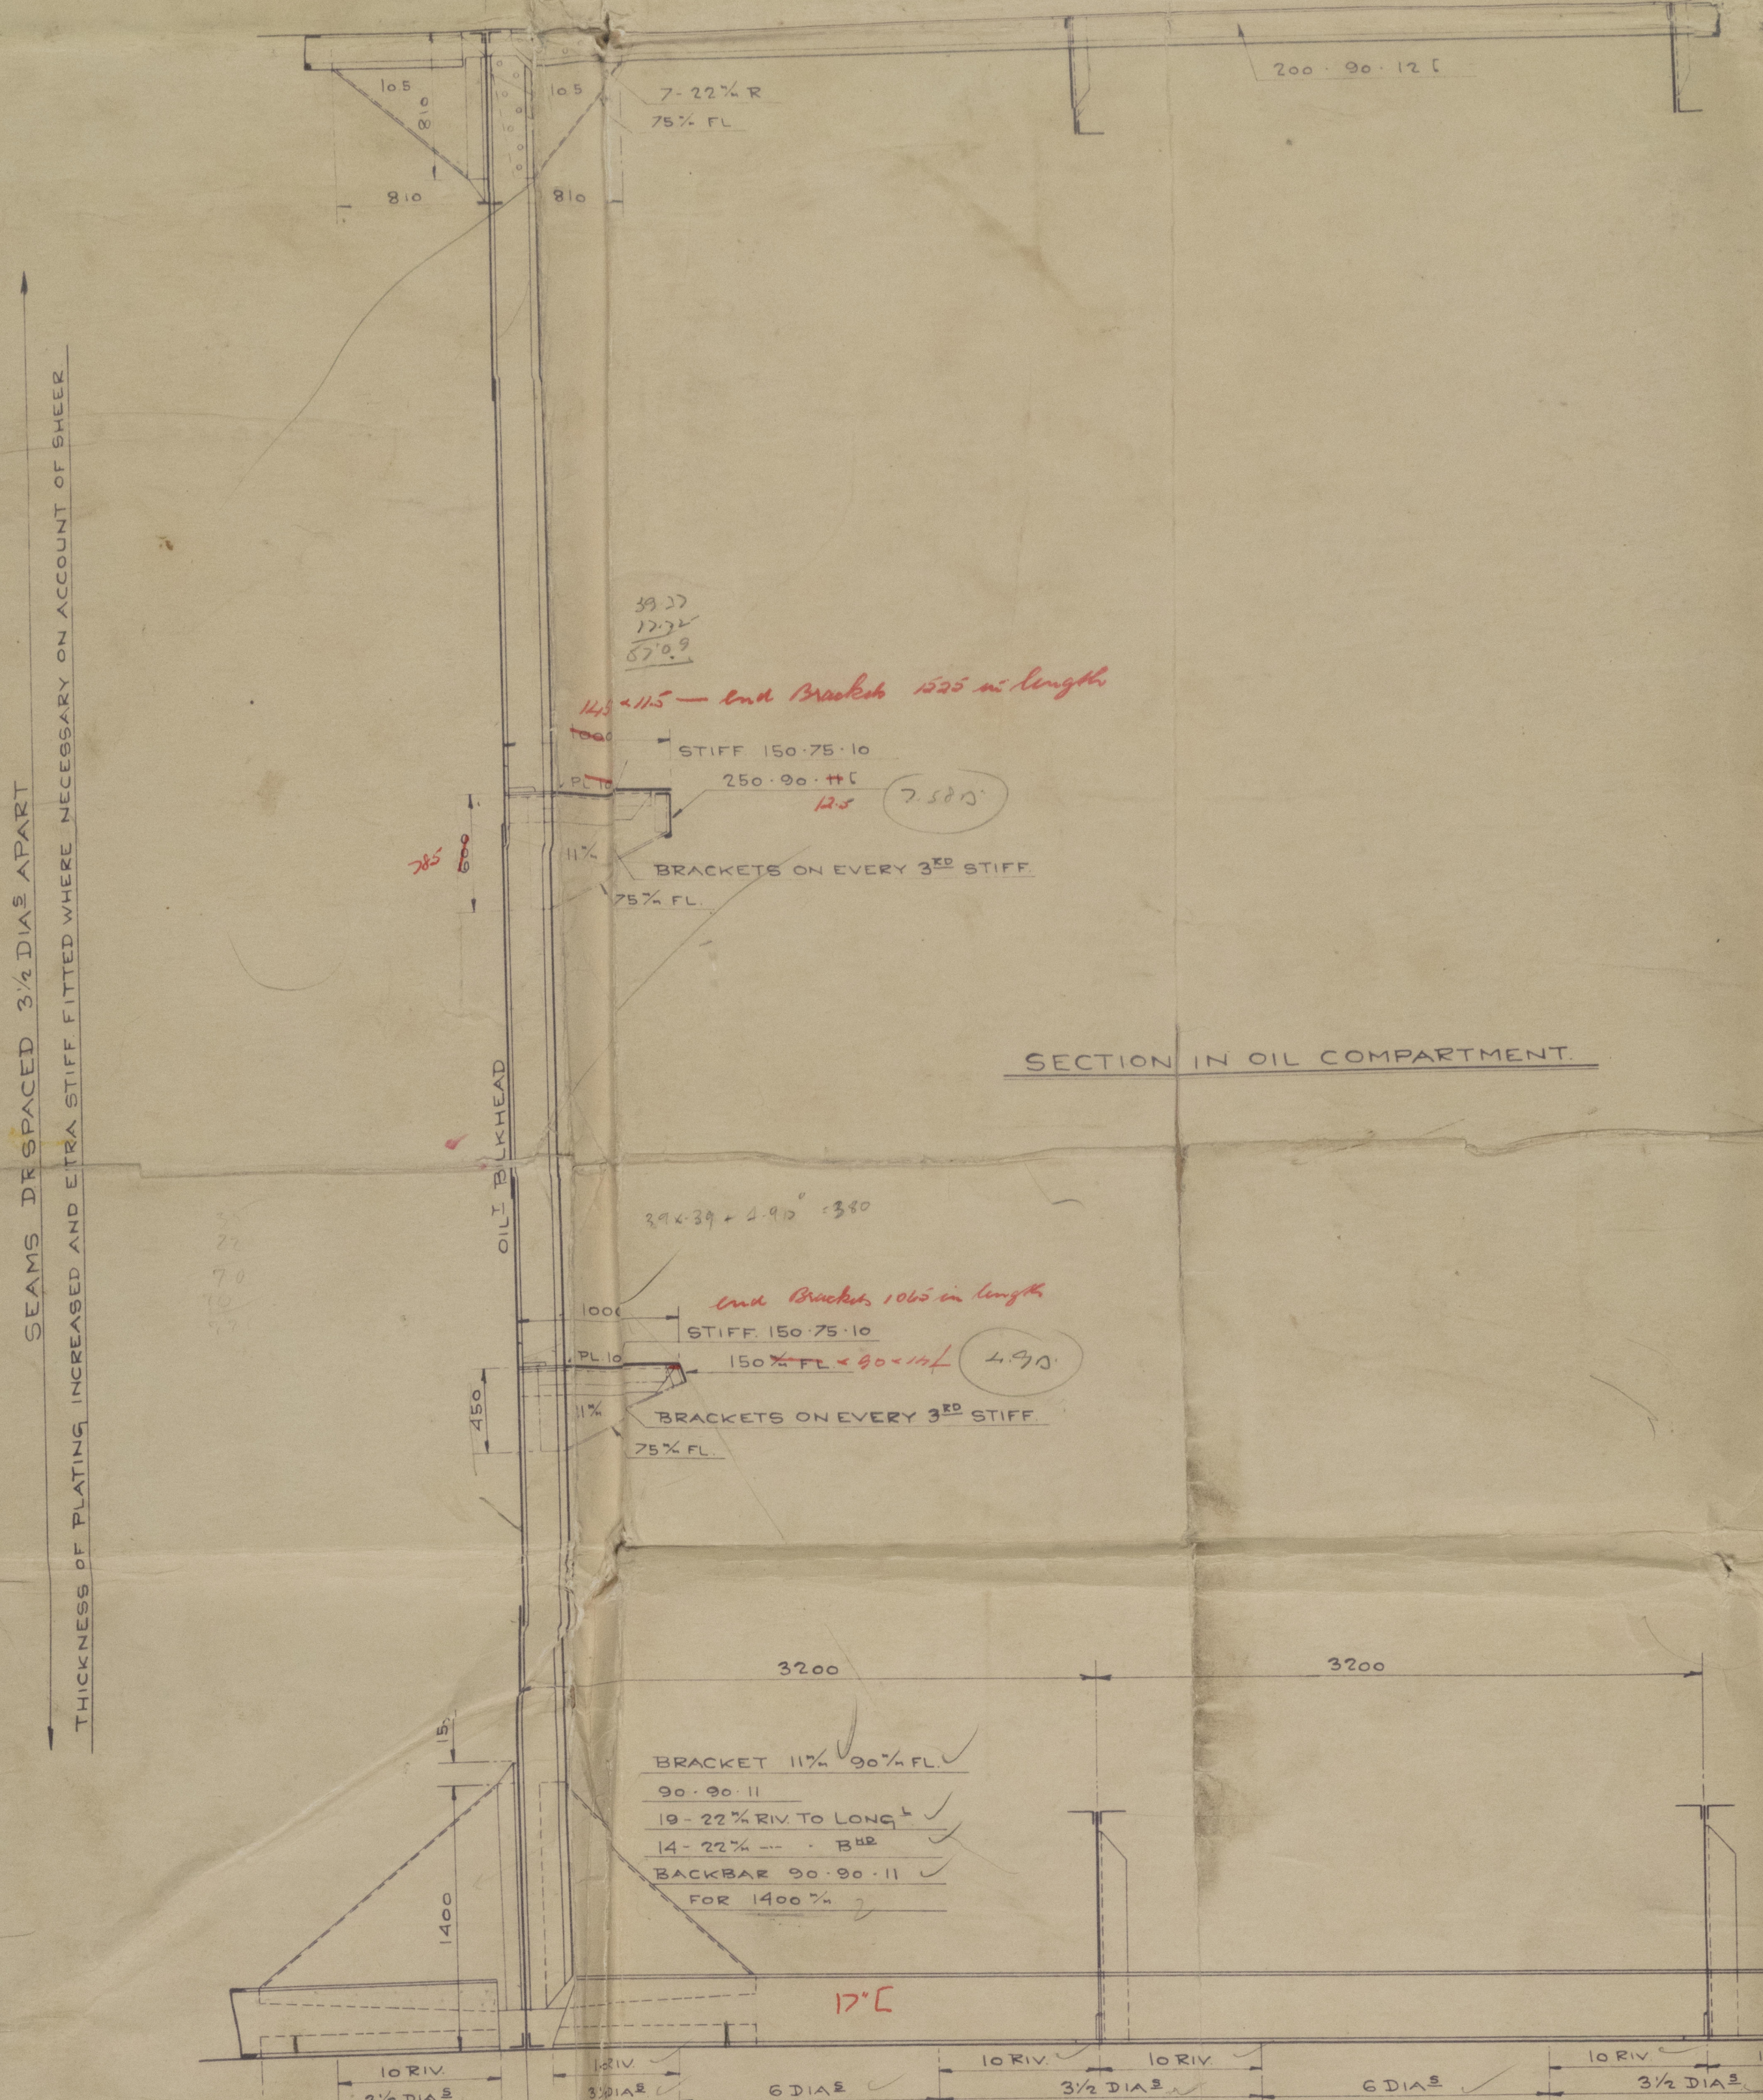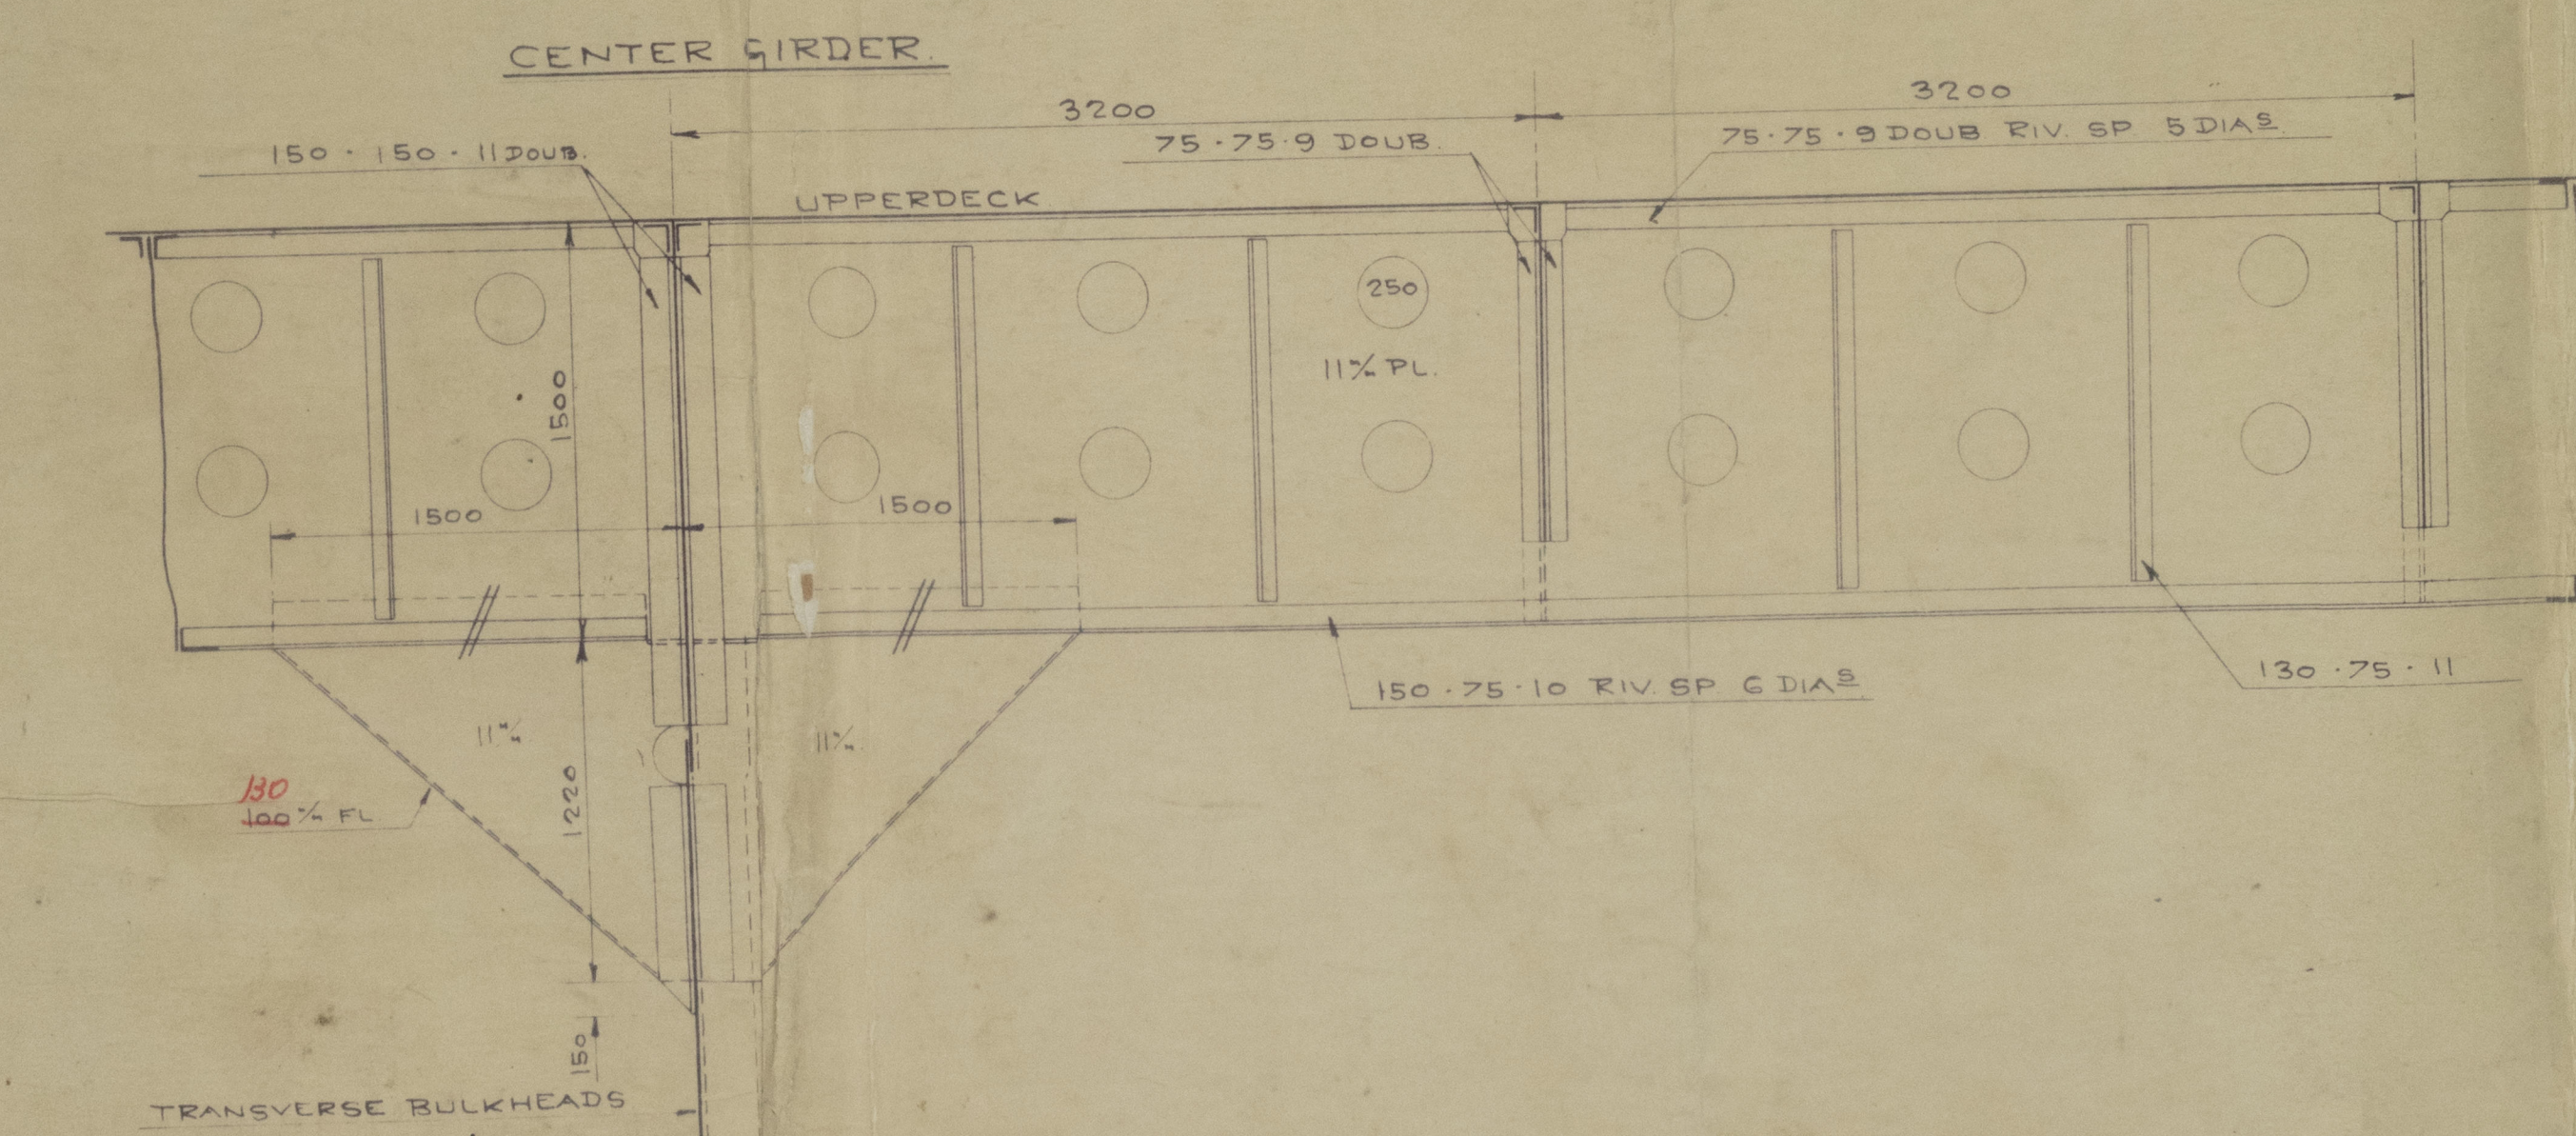

53

2

1-25

8-12-33

MIDSHIP SECTION

010103-010104-010105

© 2021

Lloyd's Register

Foundation

Odense Staalskibsværft,
Yard No. 53.

Adour

Ex MS Europa
to

Chassis No.
9502

Midship section.



© 2021

Lloyd's Register
Foundation

012142-012143-012144