

INUI KISEN K.K.

SNo 31

L.R.
N.K.

INUISAN MARU

RUDDER



AS BUILT

SCALE $\frac{1}{25}$ $\frac{1}{10}$

FUJINAGATA
SHIPBUILDING CO. LTD.
OSAKA JAPAN
ENGINEERING DEPARTMENT
SHIP DESIGN SECTION

CHIEF OF DEPT. *M. Inagawa*
CHIEF DESIGNER

CHECKED BY *I. Kobayakawa*

DRAWN BY

TRACED BY *J. Morikawa*

DATE: SEP. 16, 1953.

DRAWING NO. H-28

012165-012171-0128

TO

LLOYD'S REGISTER OF SHIPPING


KODE RPT. NO. *2170*

DATED.

INUISAN MARU

CERTIFIED COPY OF "APPROVED PLAN"

RECORDS DEPT.
LONDON

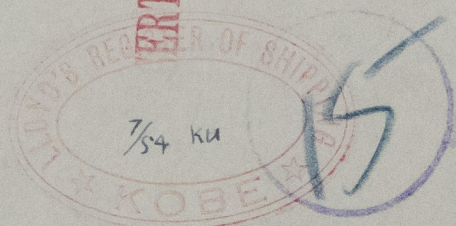

Rudder

