

SCALE : $1/200$

INUI KISEN KK

S - 31

LR
NK

INUISAN MARU

GENERAL
ARRANGEMENT

一般配置

AS BUILT

SCALE

FUJINAGATA
SHIPBUILDING CO. LTD.
OSAKA JAPAN
ENGINEERING DEPARTMENT
SHIP DESIGN SECTION

CHIEF OF DEPT. *M. Miyajima*
CHIEF DESIGNER

CHECKED BY *N. Kobayashi*

DRAWN BY *J. Nakano*

TRACED BY

DATE: 5TH JUNE 1954

DRAWING NO.


012165-012171-0124

KOBE RPT. NO. 2170


DATED. _____

Gen. Arr.

CERTIFIED
RECORDS DEPT.
COAST GUARD
JAPAN

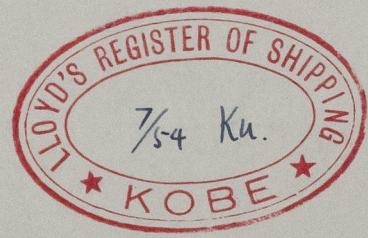

INUISAN MARU

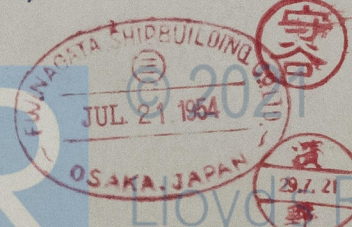

Lloyd Register
Foundation

012165-012171-0124