


PRINCIPAL DIMENSIONS

P.P. (L) 134,000 ✓
 TH MLD (B) 18,400 ✓
 (D) 10,417.5 ✓
 DRAUGHT (d) 8,267.5 ✓

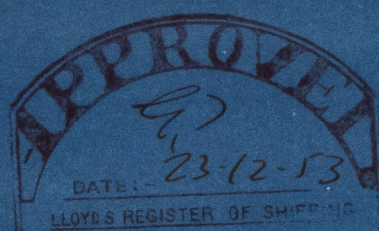

INUT KISEN KK

S No 31

L.R.
N.K

G.T. 7,200T
MOTOR CARGO BOAT

CONSTRUCTION
PROFILE & BOTTOM

鋼材配置

1/2

REVISED No.

SCALE 1/100

FUJINAGATA
 SHIPBUILDING CO. LTD.
 OSAKA JAPAN
 ENGINEERING DEPARTMENT
 SHIP DESIGN SECTION

CHIEF OF DEPT. *M. Moriguchi*
 CHIEF DESIGNER
 CHECKED BY *J. Katsuyama*
 DRAWN BY *J. Kono*
 TRACED BY
 DATE: SEP 12 1953
 DRAWING NO. H-2

012165-012171-0131

31
FOR APPROVAL

TO
 LLOYD'S REGISTER OF SHIPPING
 INUISAN MARU

Officer

RECORDS DEPT.

KOBE RPT. No. 2170

DATED.

U

Construction Profile

28.12.53

FUJINAGATA SHIPBUILDING CO. LTD.
 DEC. - 6 1953
 OSAKA JAPAN

Lloyd's Register
 Foundation

DEC. 16 1953