

N<sup>os</sup> 131 & 132.

# MIDSHIP SECTION.


STEEL SCREW MOTOR VESSELS.

## DIMENSIONS.


LENGTH B.P. 130'-3"  
BREADTH M.P. 25'-0"  
DEPTH M.P. TO UPPER D<sup>k</sup>. 9'-6"

SCALE 1/2" = 1 FOOT.

CLASS LLOYDS 100 A.I.

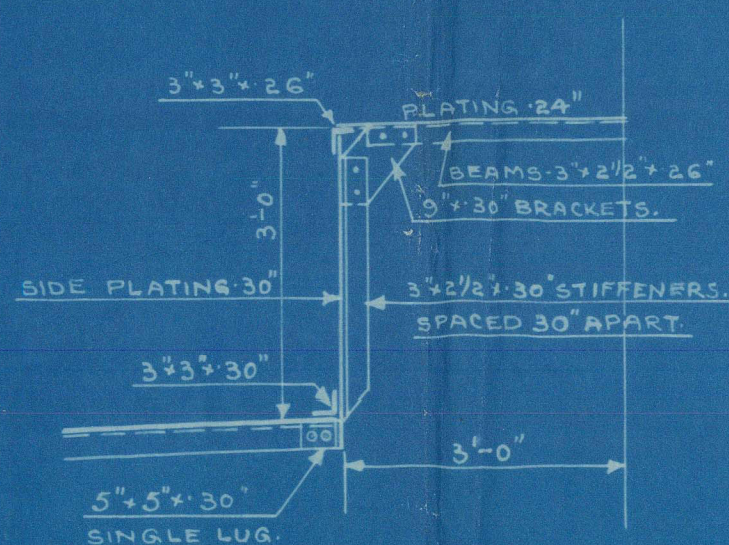

SECTION THRO' CASING.

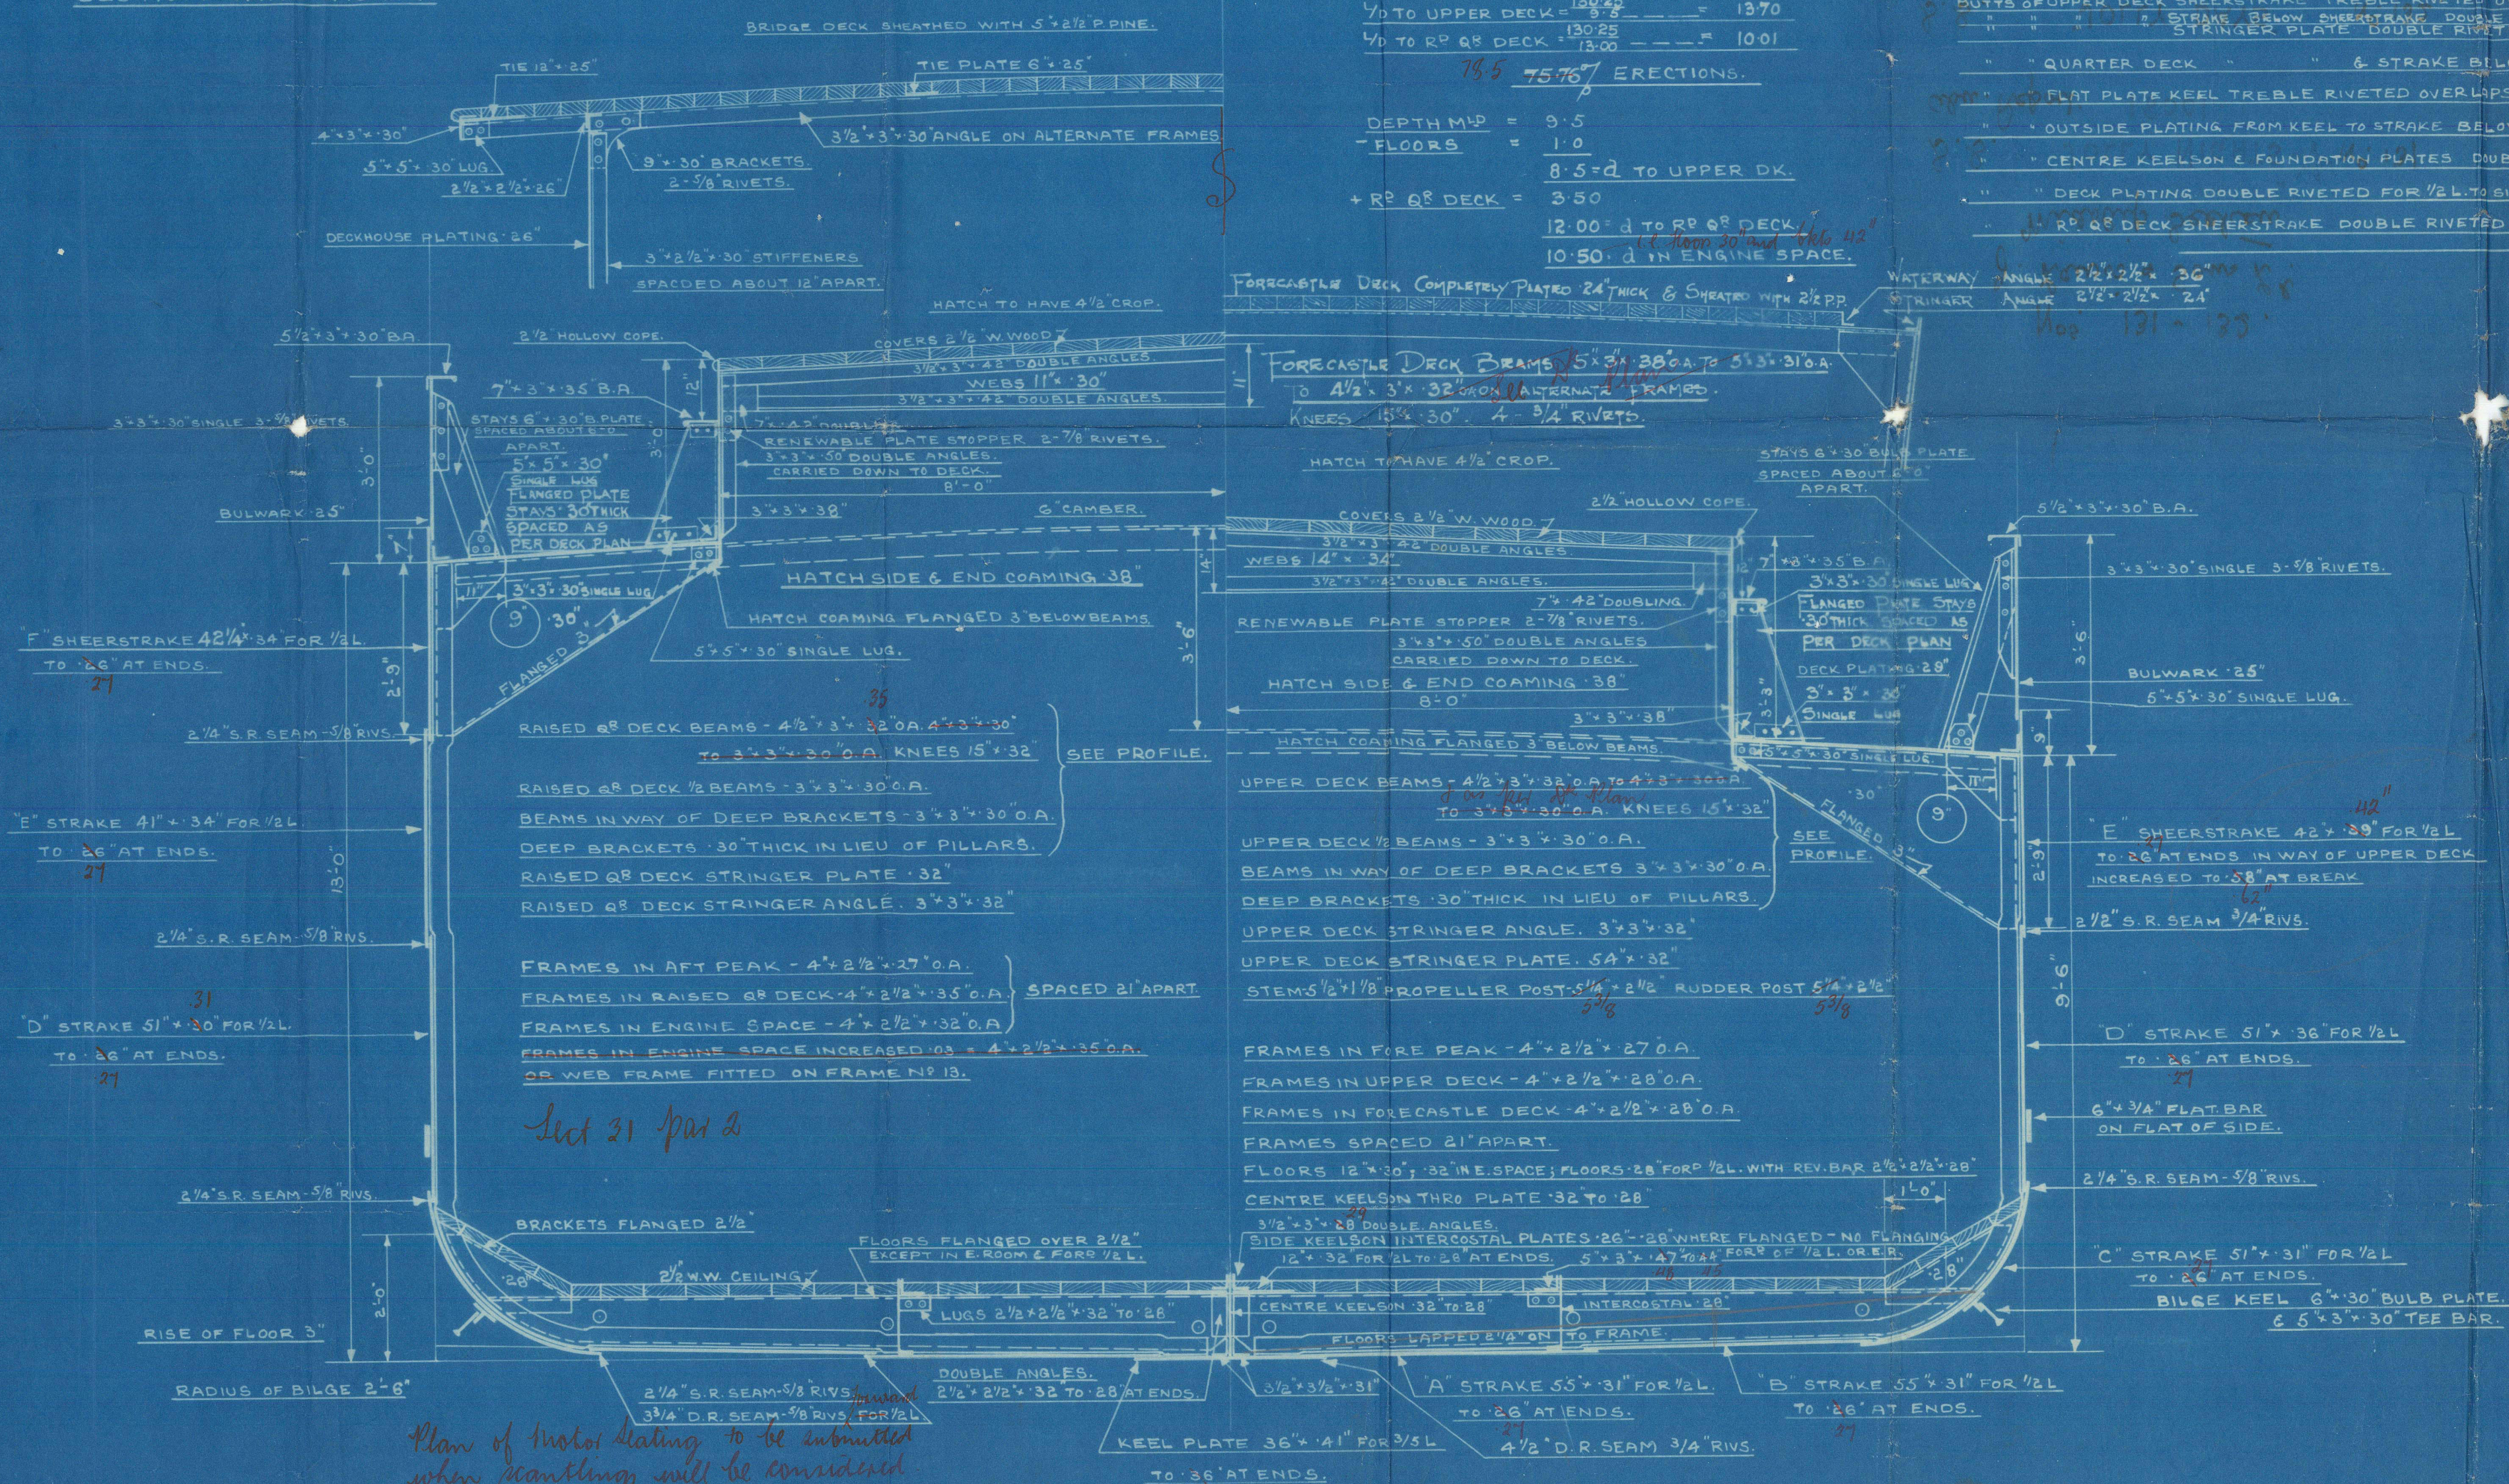

## EQUIPMENT NUMERALS.

LY(B+D) = 130.25(25+9.5)	4493.62
RP QUARTER DECK = 82.69 x 3.50	289.41
BRIDGE DECK = 8.75 x 7.50	30.62
FORECASTLE DECK = 15 x 6.75 x .75	31.00
CASING ETC = 17.5 x 3 x .5	26.25
CASING = 7 x 7 x .5	24.50
	4945.40

## EQUIPMENT

1 BOWER ANCHOR STOCKLESS	7 1/4 CWT	8 1/4
1	7	8
1 STREAM	EX-STOCK	2 1/4
165 FATHOMS	3/8" DIA. STUD LINE CABLE	2 1/4
45	2 1/4" FLEX. STEEL WIRE	2 1/4
60	1 1/2" x 2 1/2" TOWLINE	6 x 12
15	6" COIR ROPE	
90	1 1/2" FLEX. STEEL WIRE HAWSER	6 x 12

TO OWNERS' REQUIREMENTS.

## NUMERALS.

L+D = 130.25 + 9.5	= 139.75
L+(B+D) = 130.25(25+9.5)	= 443.625
7/10 TO UPPER DECK = 130.25	= 1370
4/10 TO RP Q <sup>R</sup> DECK = 130.25	= 1001

## ERECTOR'S.

DEPTH M.P.	= 9.5
FLOORS	= 1.0
8.5 d TO UPPER D <sup>k</sup> .	
12.00 d TO RP Q <sup>R</sup> DECK.	
10.50 d IN ENGINE SPACE.	

## RIVETING.

- BUTTS OF UPPER DECK SHEERSTRAKE TREBLE RIVETED OVERLAPS FOR 1/2 L. TO DOUBLE AT ENDS.
- STRAKE BELOW SHEERSTRAKE DOUBLE RIVETED OVERLAPS ALL FORE & AFT.
- QUARTER DECK " " & STRAKE BELOW SHEERSTRAKE DOUBLE RIVETED OVERLAPS.
- FLAT PLATE KEEL TREBLE RIVETED OVERLAPS FOR 1/2 L. TO DOUBLE AT ENDS.
- OUTSIDE PLATING FROM KEEL TO STRAKE BELOW SHEERSTRAKE DOUBLE RIVETED OVERLAPS.
- CENTRE KEELSON & FOUNDATION PLATES DOUBLE RIVETED OVERLAPS.
- DECK PLATING DOUBLE RIVETED FOR 1/2 L. TO SINGLE AT ENDS.
- RP Q<sup>R</sup> DECK SHEERSTRAKE DOUBLE RIVETED OVERLAPS ALL FORE & AFT.

See letter dated 18/9/34  
of London sent 27/9/34

APPROVED


LLOYDS REGISTER OF SHIPPING

H. Dickinson per Mr

24 8 34



of 11/3 1316 132  
Drawings No 1.  
22nd August 1934

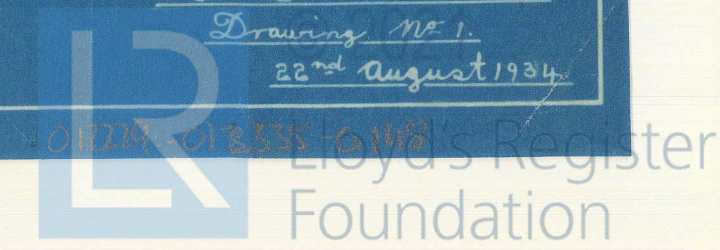



Nos. 131 - 132.

J. Lewis & Son L<sup>d</sup>.

Midship Section

"CRANBOURNE"

S.S. \* "JOLLY NIGHTS" \* N<sup>o</sup>. 131

abu. Report. 18001.

S.S. "JOLLY DAYS" N<sup>o</sup>. 132.

abu. Report. 18037.


*Cranbourne*

M.N. "SEABANK"

PLANS TRANSFERRED  
TO SISTER VESSEL

RECORDS DEPT.  
LONDON.

*Inene*

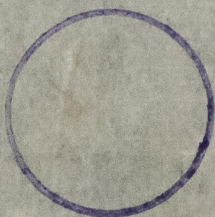

© 2021

Lloyd's Register  
Foundation

012229-012235-0148