


No 1115.

PROPOSED ARRANGEMENT OF
FORWARD STRINGER.

SCALE 1/4" = 1 FOOT.

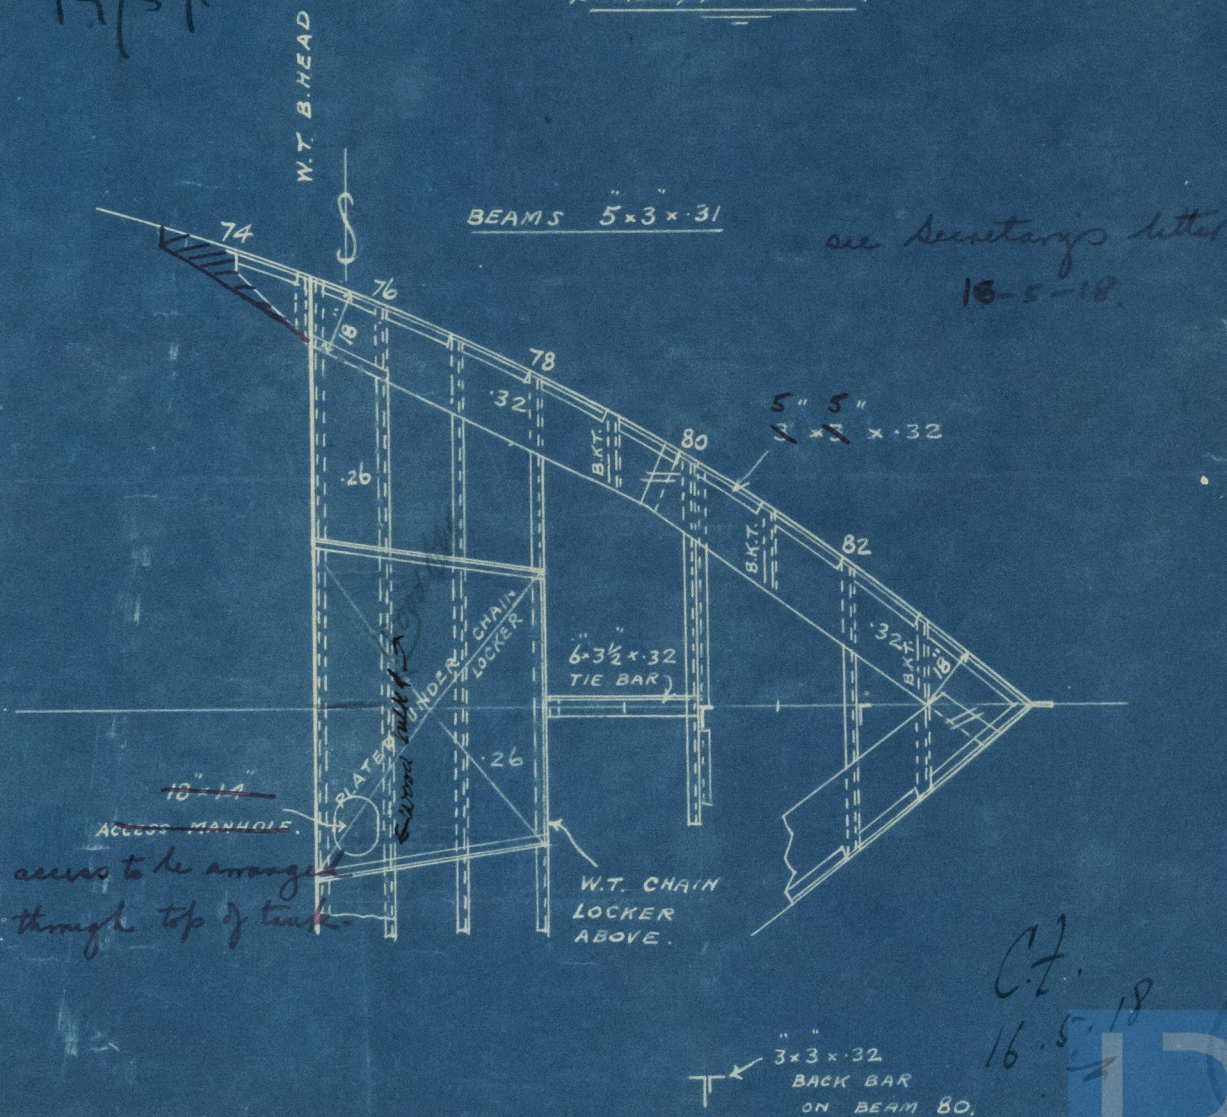

C.F.
16-5-18



Foundation

No 6
C. S. TYPE
SWAN HUNTER & WIGHAM
RICHARDSON'S

No 1115.

PLAN OF FOR^d STRINGER.

7/11 "Yung Sing"

S. S. "WAR TAMAR"
NEWCASTLE ON TYNE.

Report No. 71840.



© 2021

Lloyd's Register
Foundation