


15/4/18.

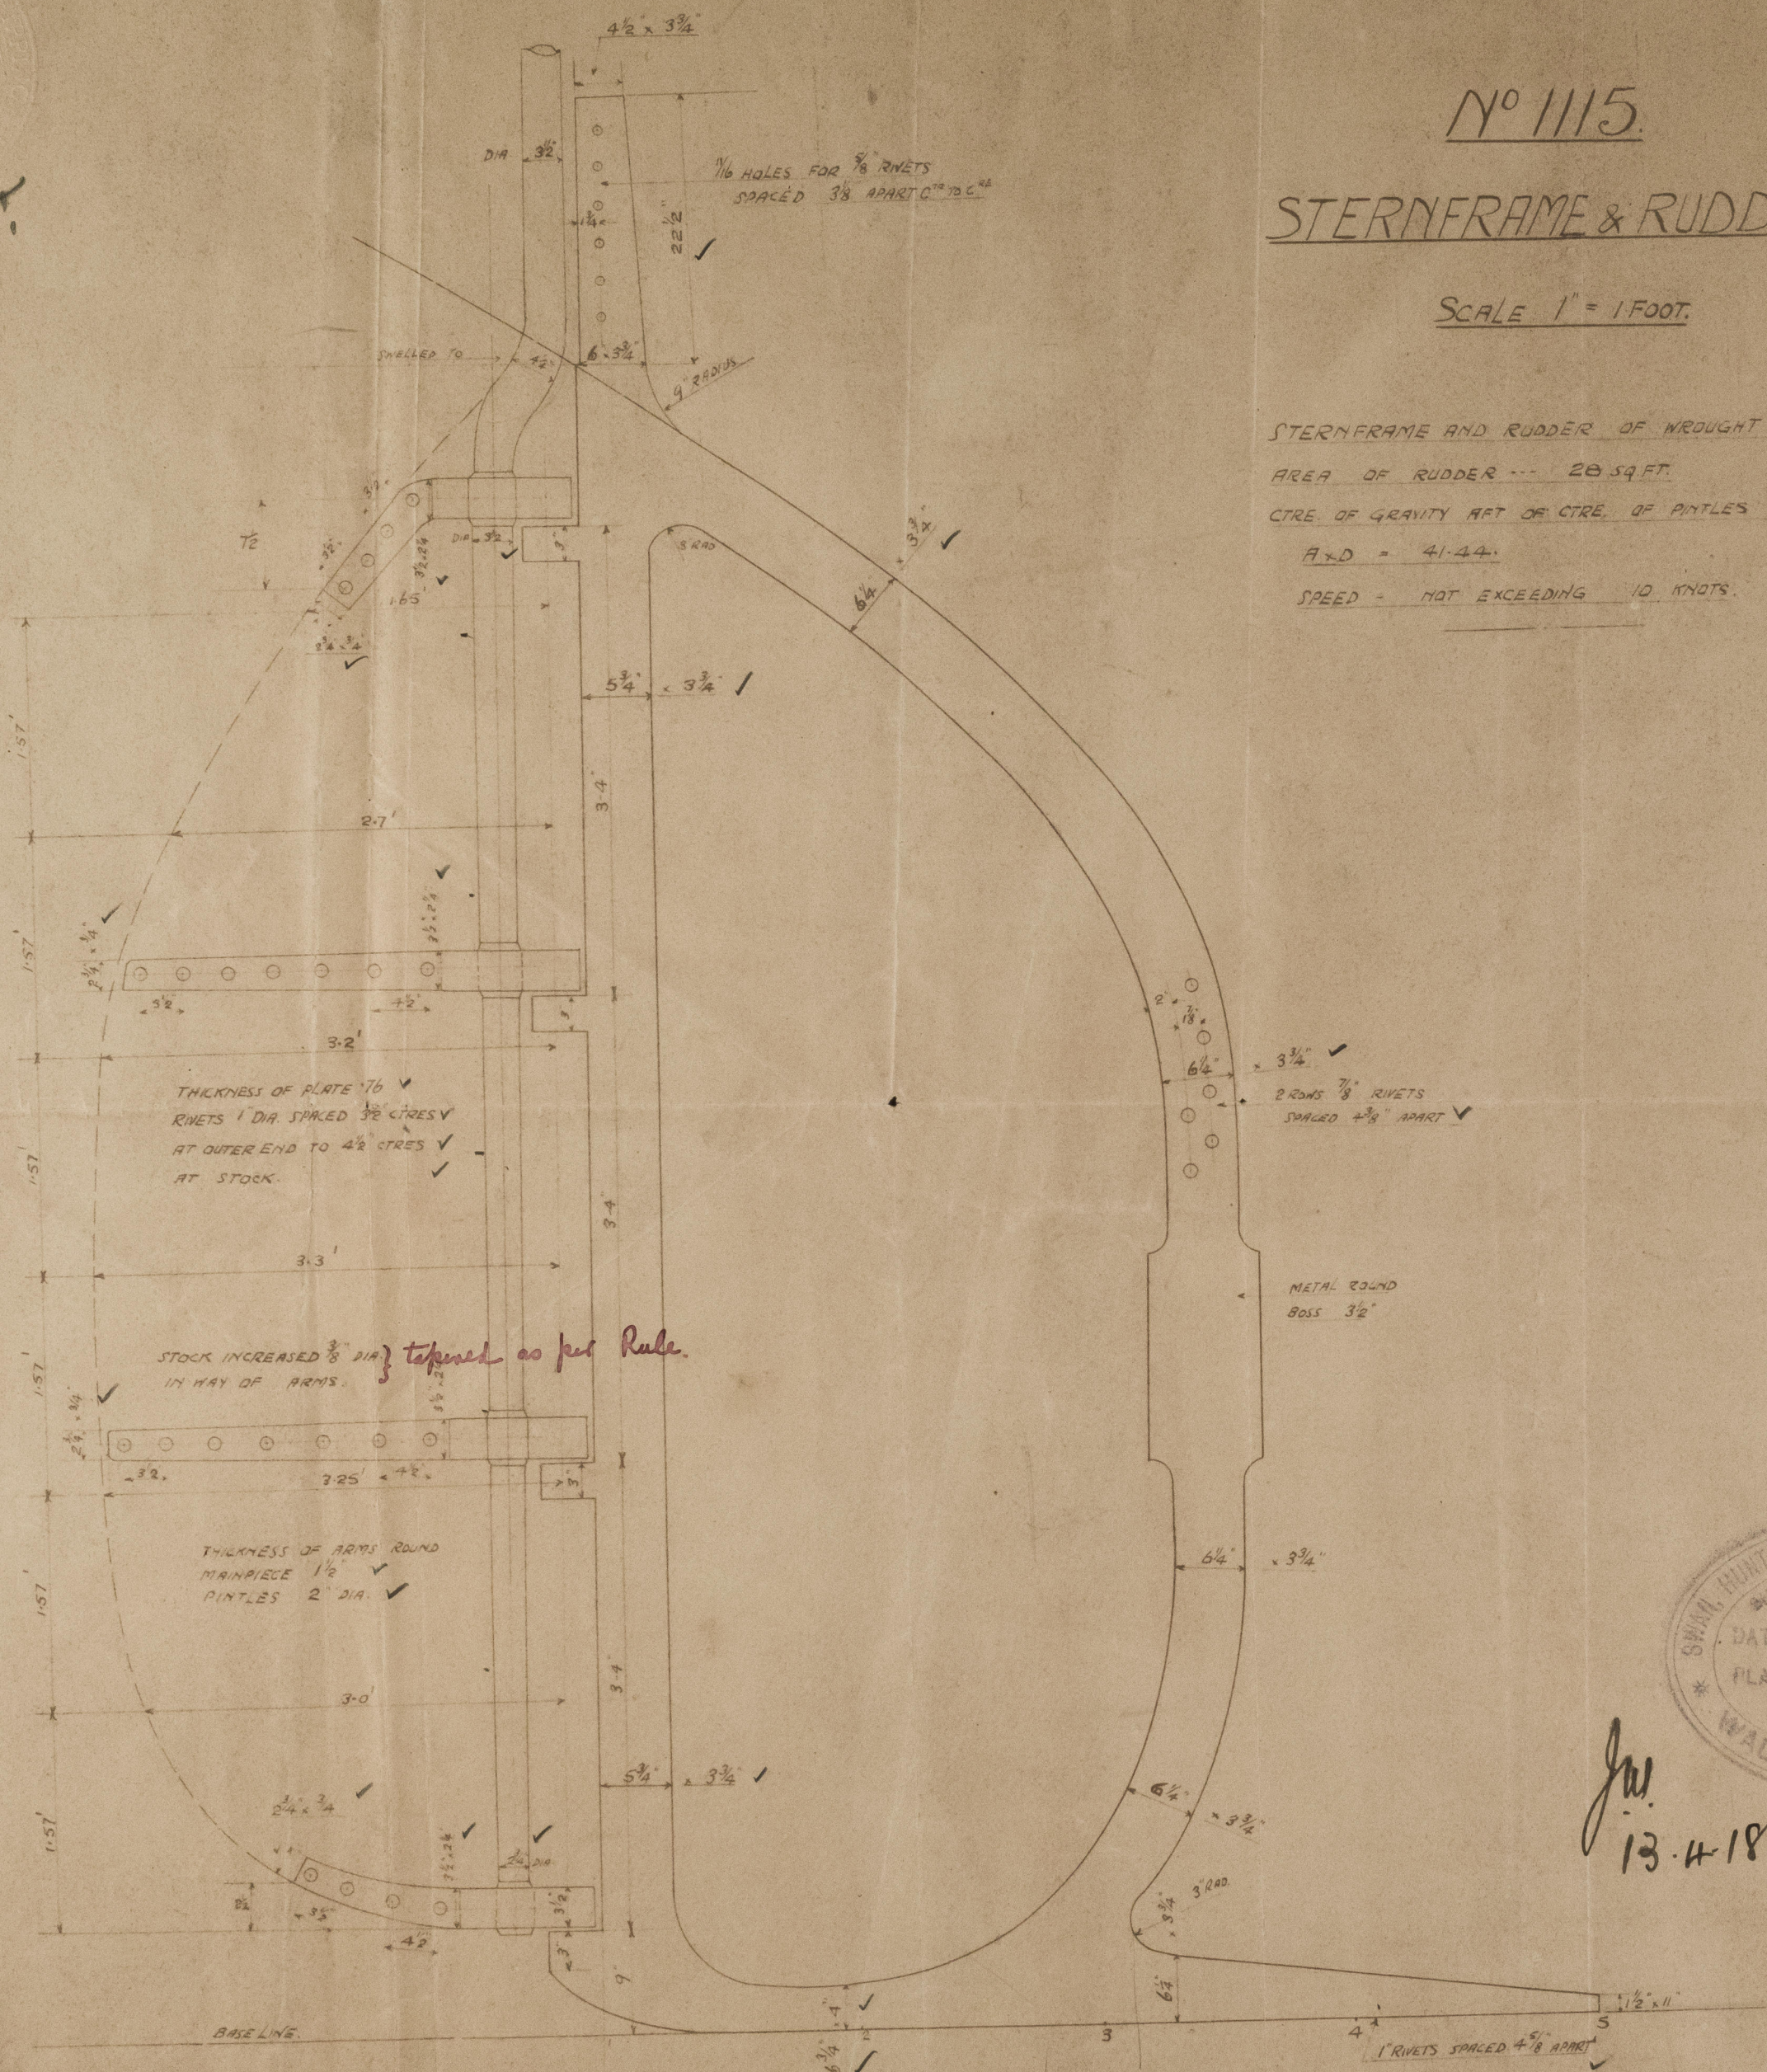

Nº 1115.

STERNFRAME & RUDDER

SCALE 1" = 1 FOOT.


STERNFRAME AND RUDDER OF WROUGHT IRON OR CAST STEEL

AREA OF RUDDER --- 20 SQ. FT.

CTRE OF GRAVITY AFT OF CTRE. OF PINTLES 1.40 FT.

A x D = 41.44.

SPEED - NOT EXCEEDING 10 KNOTS.

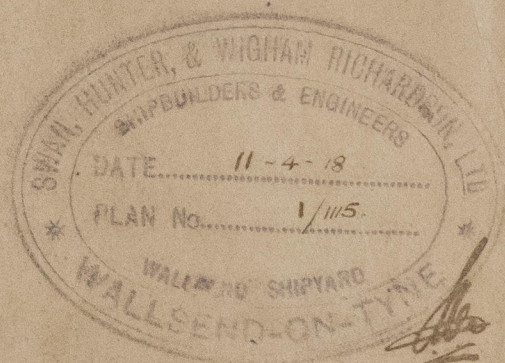

J.W.
13.4.18



© 2021

Lloyd's Register
Foundation

012236 012245 0020

No. 3

SWAN HUNTER & WIGHAM
RICHARDS ON LTD

S.S. No. 1115

STANDARD C.S. TYPE

Stem frame and Rudder

S. S. WAR TAMAR
NEWCASTLE ON TYNE.

Report No. 41840.

n/n "Hong Sing"

