

Lloyd's

Lloyd's

SHIP No. 703 PIPING ARRANGEMENT.

SCALE 1/4" = 1 FOOT.

DRC No. 30




NOTE: WOOD PLUGS & CANVAS COVERS TO BE SUPPLIED FOR AIR PIPE OPENINGS.

PUMPS AVAILABLE FOR BILGE DUTY.			
Nº.	PURPOSE.	CAPACITY TONS / HR.	TYPE.
ONE	GENERAL SERVICE PUMP.	20	SELF PRIMING.
ONE	MAIN ENGINE (BILGE INJECTION) SW PUMP ONLY.	4	SINGLE ACTING PLUNGER.
ONE	FIRE & BILGE PUMP.	10	SELF PRIMING.



COLOUR SCHEME	
SERVICE	COLOUR.
AIR, SOUND & FILLING PIPES.	BLACK.
SCUPPERS, DISCHARGES & VOICE PIPES.	BLACK.
SUCTION.	BLUE.
COLD FRESH WATER.	BURNT SIENNA.
HOT FRESH WATER.	YELLOW.
SALT WATER.	GREEN.
RADIATORS.	PURPLE.
CALOR GAS PIPES.	RED.

FIRE FIGHTING APPLIANCES
1-OFF PORTABLE FIRE EXTINGUISHER - SODA ACID TYPE.
THE FOLLOWING PORTABLE FIRE EXTINGUISHERS FOR ENGINE ROOM ARE TO BE SITED BY ENGINEERS.
3-OFF FOAM TYPE AND 1-OFF C.T.C. TYPE.
2-OFF FIRE HOSE CONNECTIONS.
4-OFF FIRE BUCKET.
1-OFF FIREMAN'S AXE.
LIST OF HOSES
1-OFF 60FT LENGTH WITH DIRECTOR.
1-OFF 30FT LENGTH WITH DIRECTOR.
FIRE HYDRANTS OF 2" INSTANTANEOUS TYPE


CAPACITY OF PUMPS CONNECTED TO FIREMAIN
ONE GENERAL SERVICE PUMP, CAPACITY 20 TONS / HR. TOTAL HEAD 40FT.
ONE FIRE & BILGE PUMP, CAPACITY 10 TONS / HR. TOTAL HEAD 40FT.

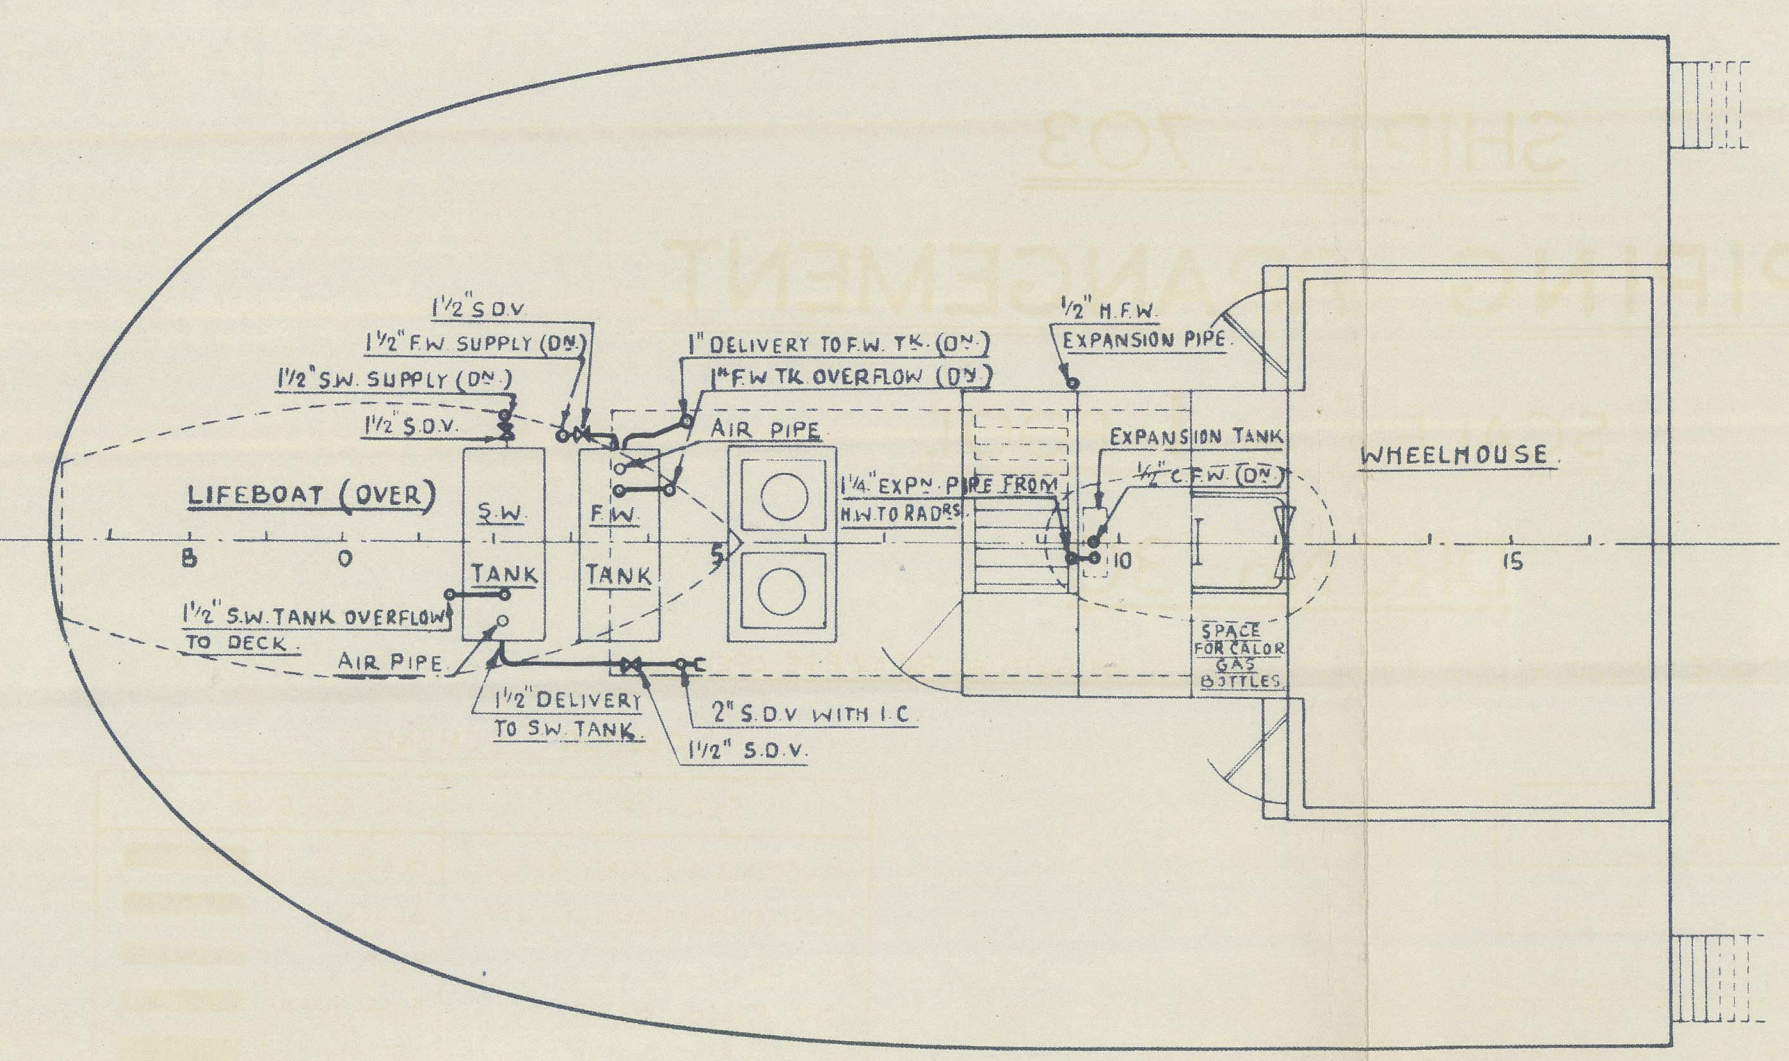

POOP DECK.

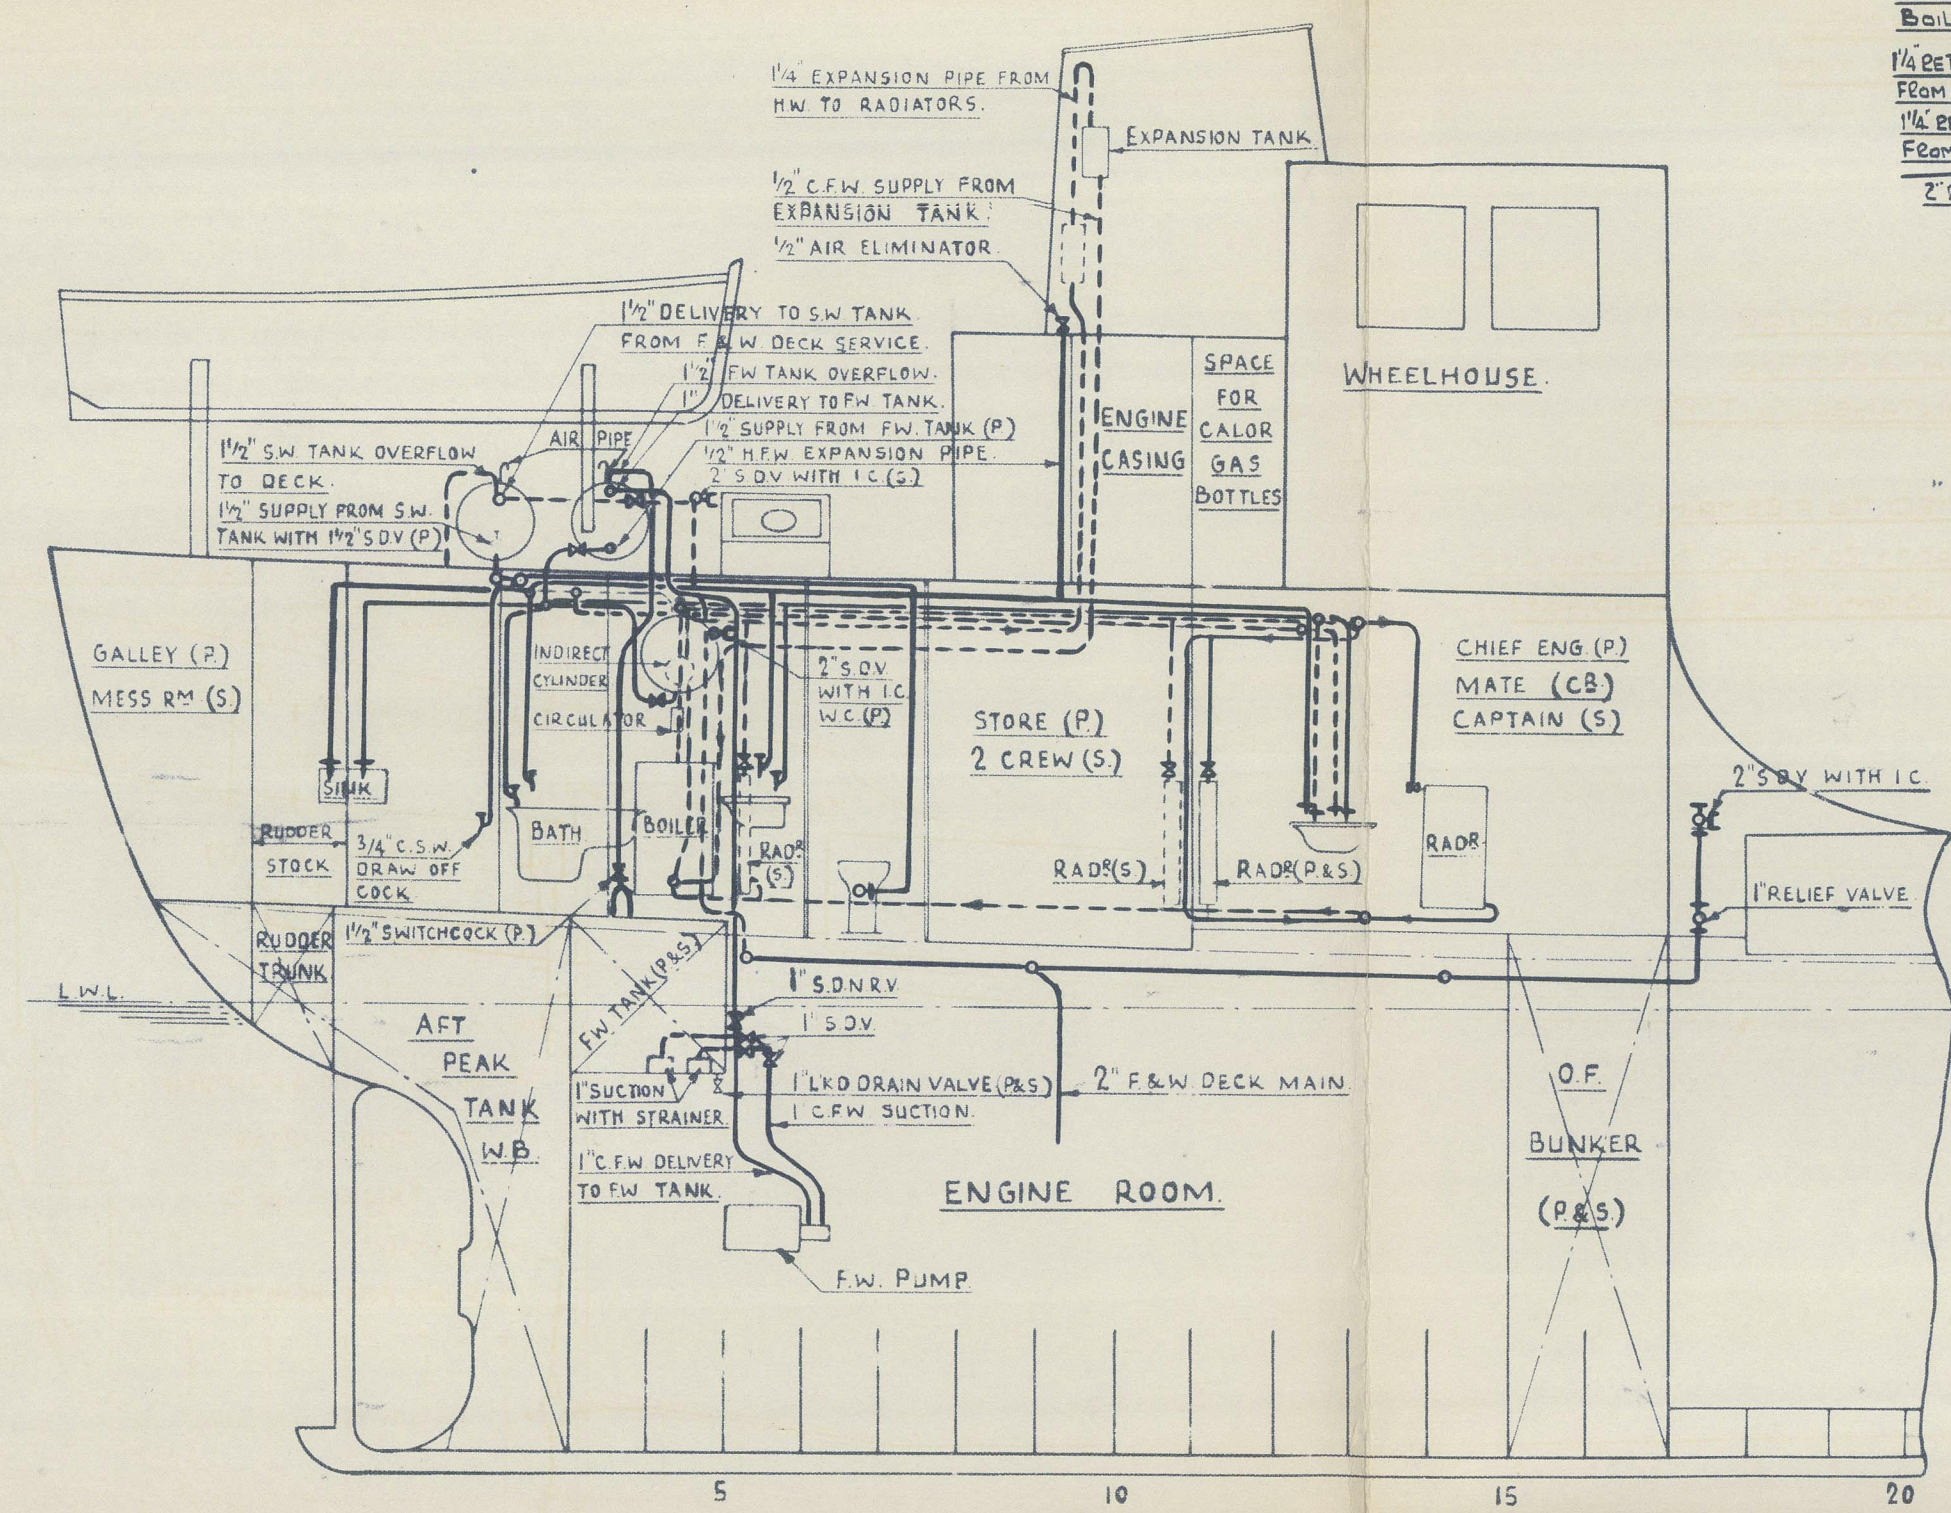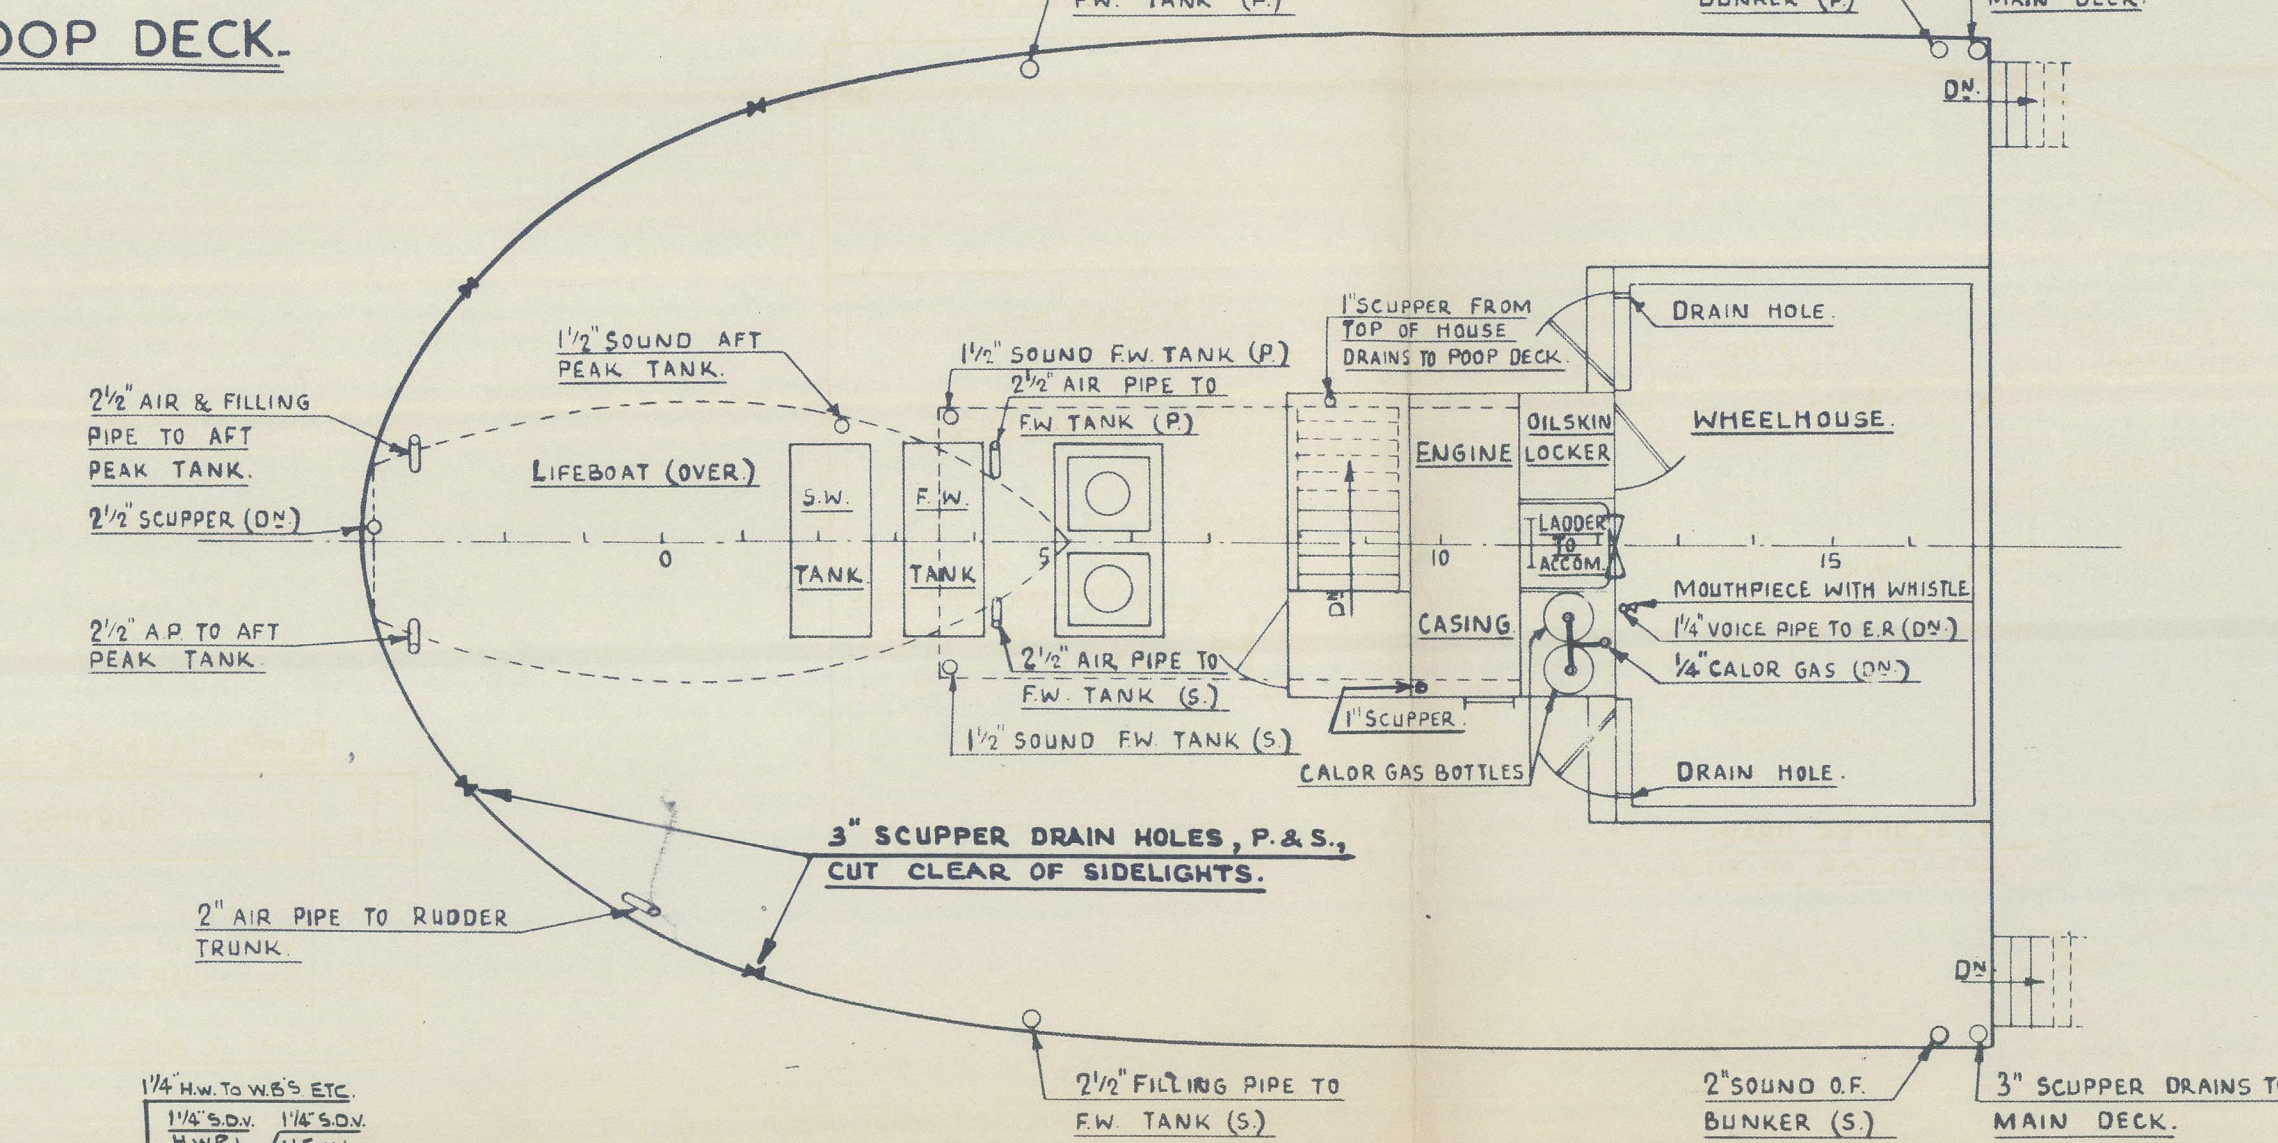

MAIN DECK.

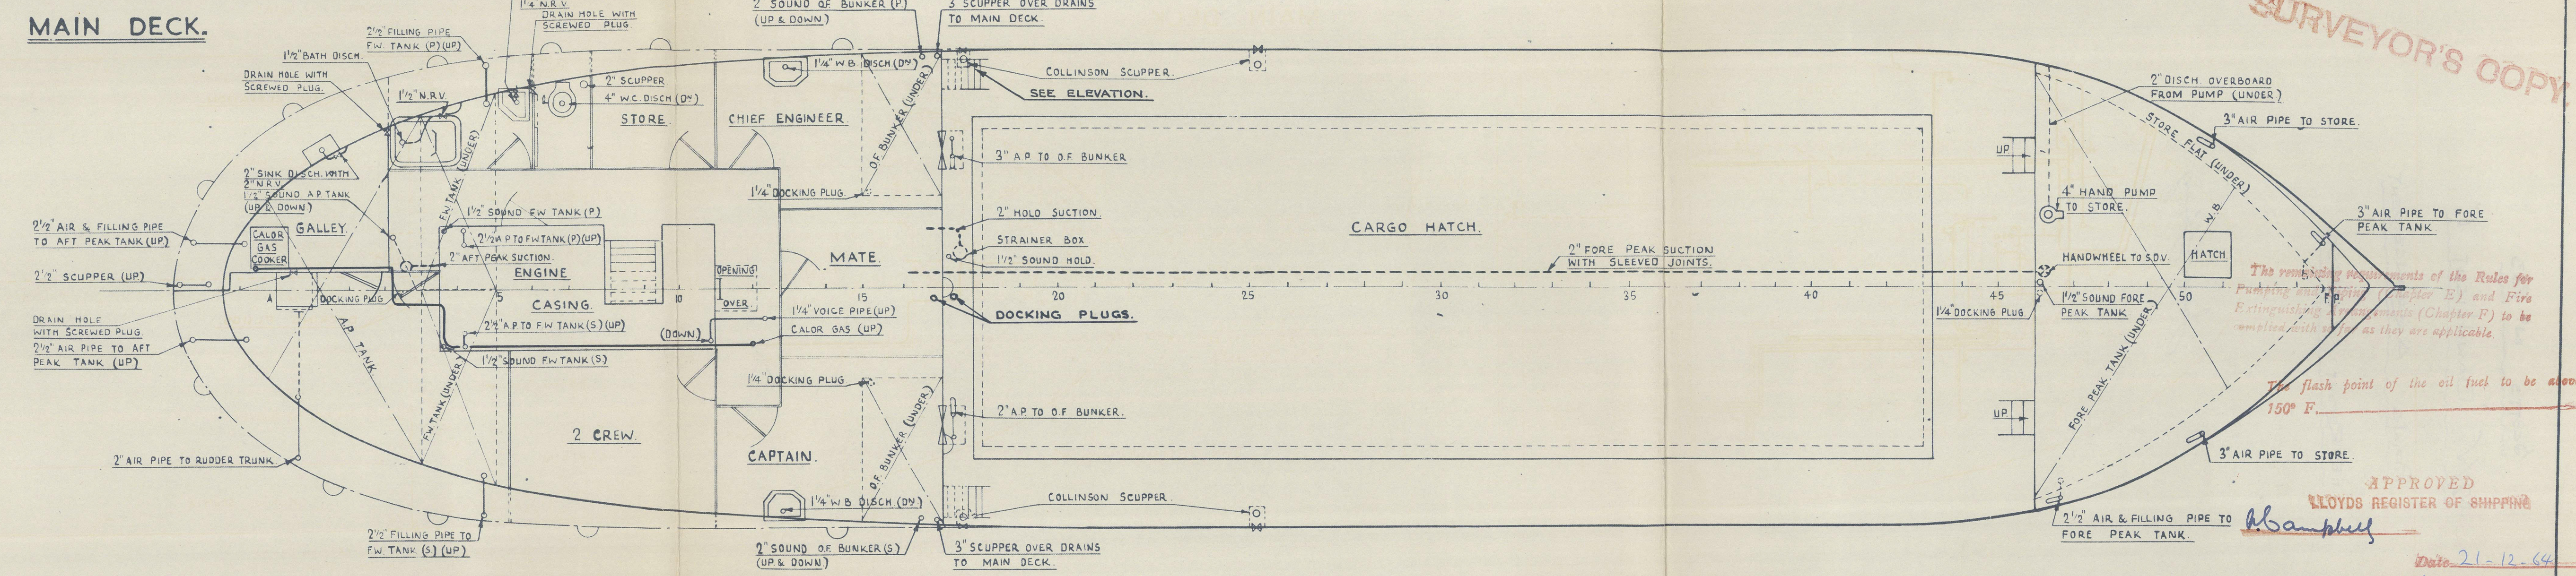

SURVEYOR'S COPY

The undersigned hereby certifies that the Rules for the Construction and Equipment of Ships (Chapter F) have been complied with as far as they are applicable.


APPROVED
LLOYD'S REGISTER OF SHIPPING

Date 21-12-64
2021

"DAWNLIGHT I" ★

PIPING ARRANGEMENT.

RECORDS DEPT.,
LONDON.

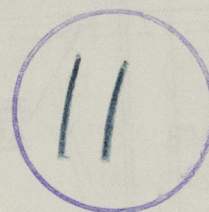

© 2021

Lloyd's Register

012246-012255-0227 Foundation

④

SCOTTS NO 703

M/V. "DAWNLIGHT I"

PIPING ARRANGEMENT

F.E. REPORT NO 27750

James S. Young



© 2021

Lloyd's Register
Foundation