



S.S. EMPIRE ELCAR **GENERAL ARRANGEMENT**

SCALE 1/8" = 1 FOOT


DIMENSIONS: L. 310' 0" x B. 46' 4" x D. 25' 2" TO UPPER DECK 25' 2"

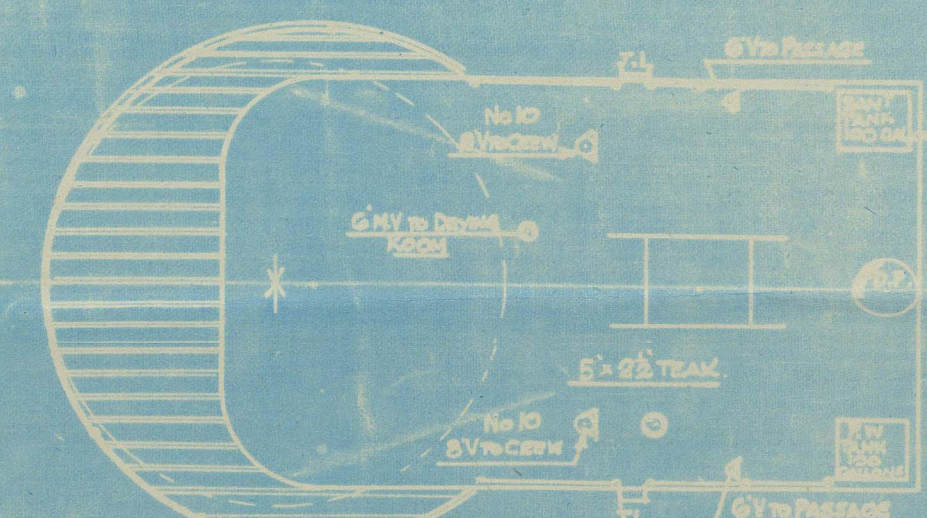

POOP DECKHOUSE TOP

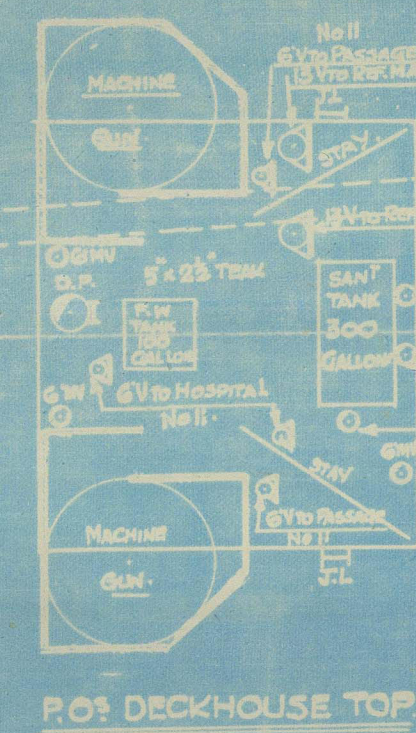

POOP DECKHOUSE TOP


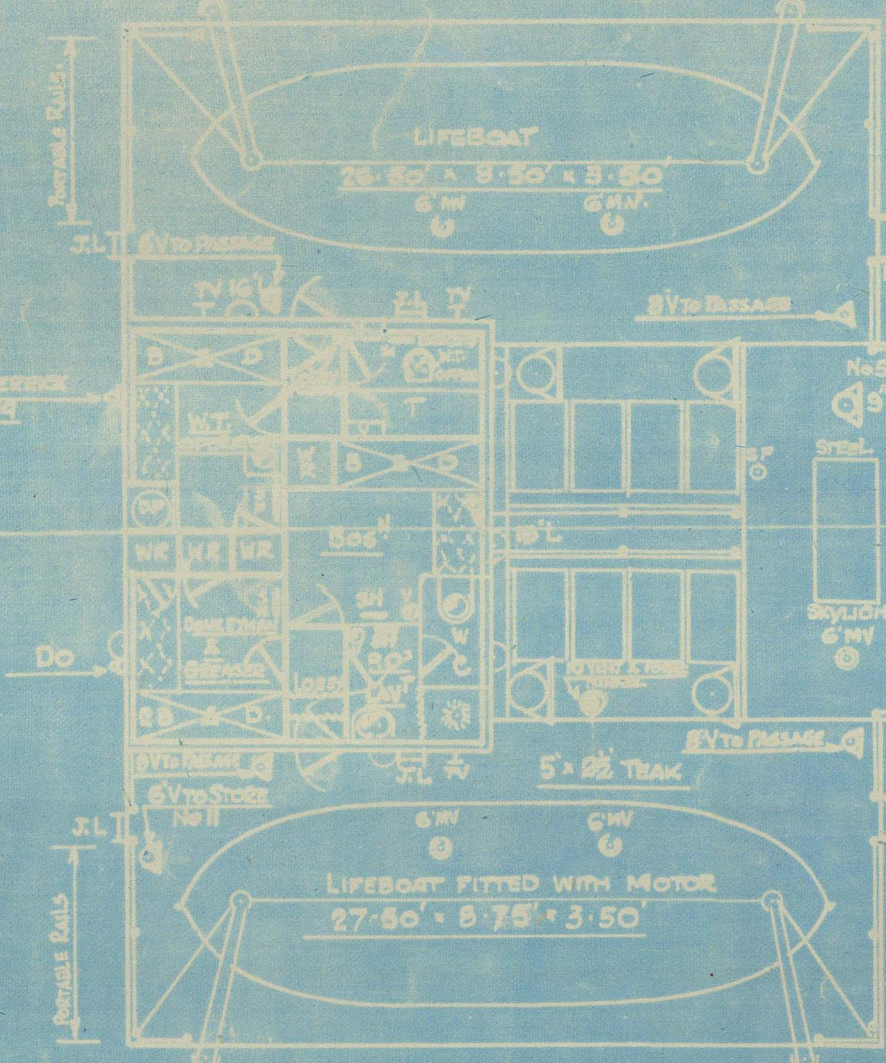


BOAT DECK


SALOON HOUSE TOP

NAVIGATING BRIDGE


WHEELHOUSE TOP

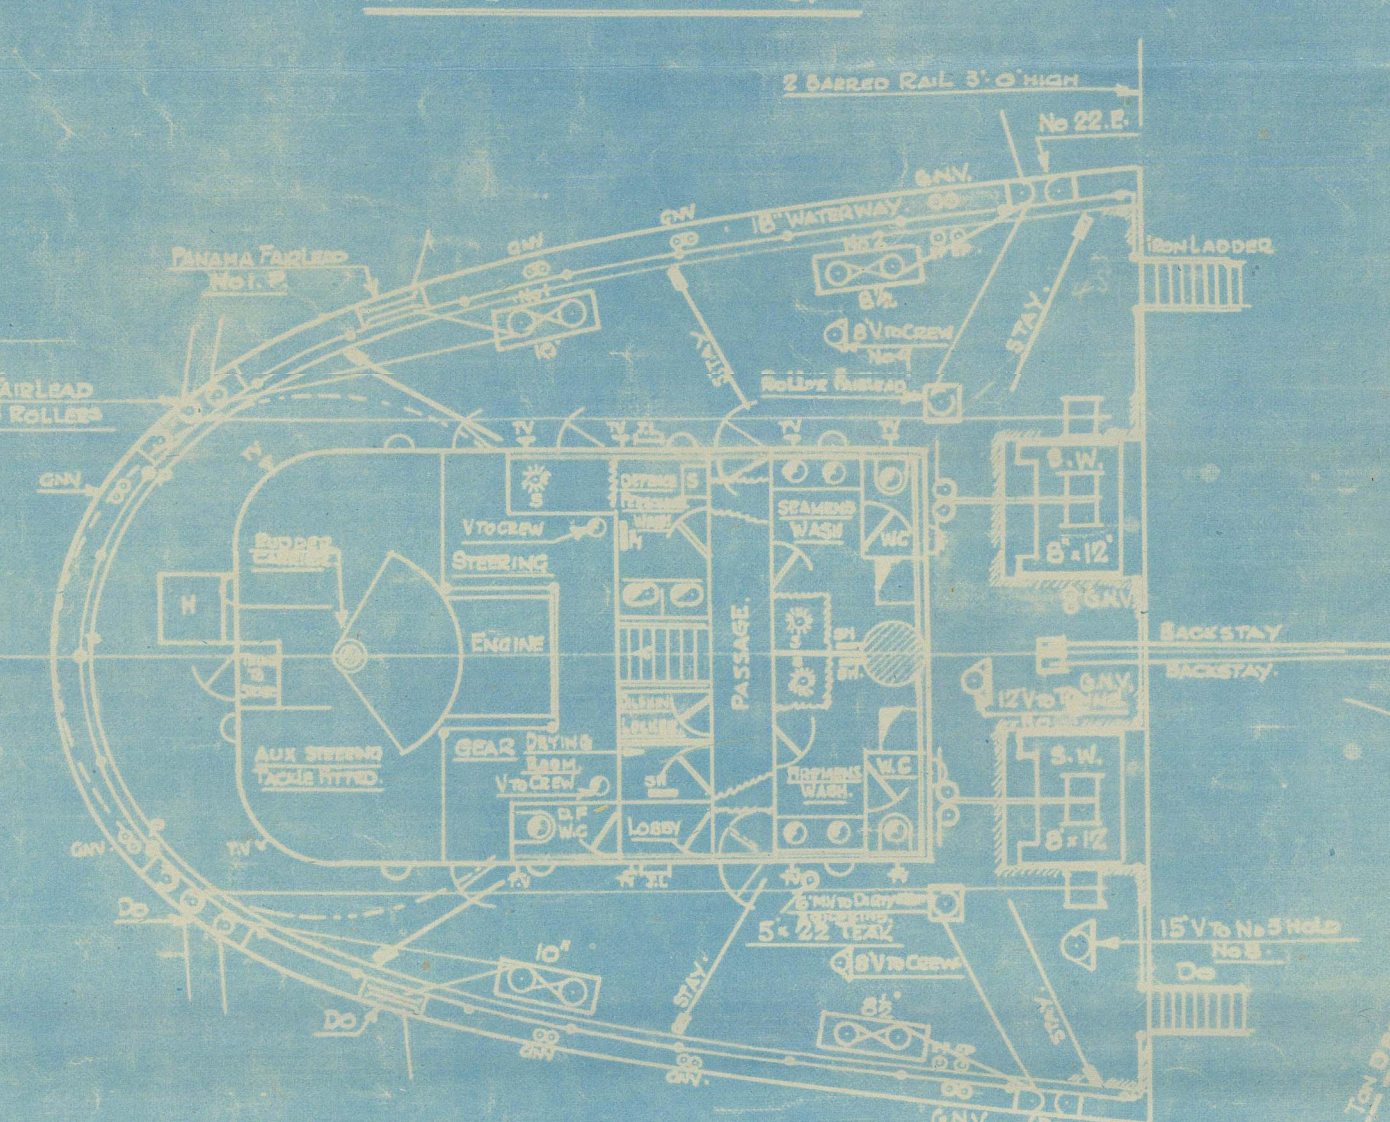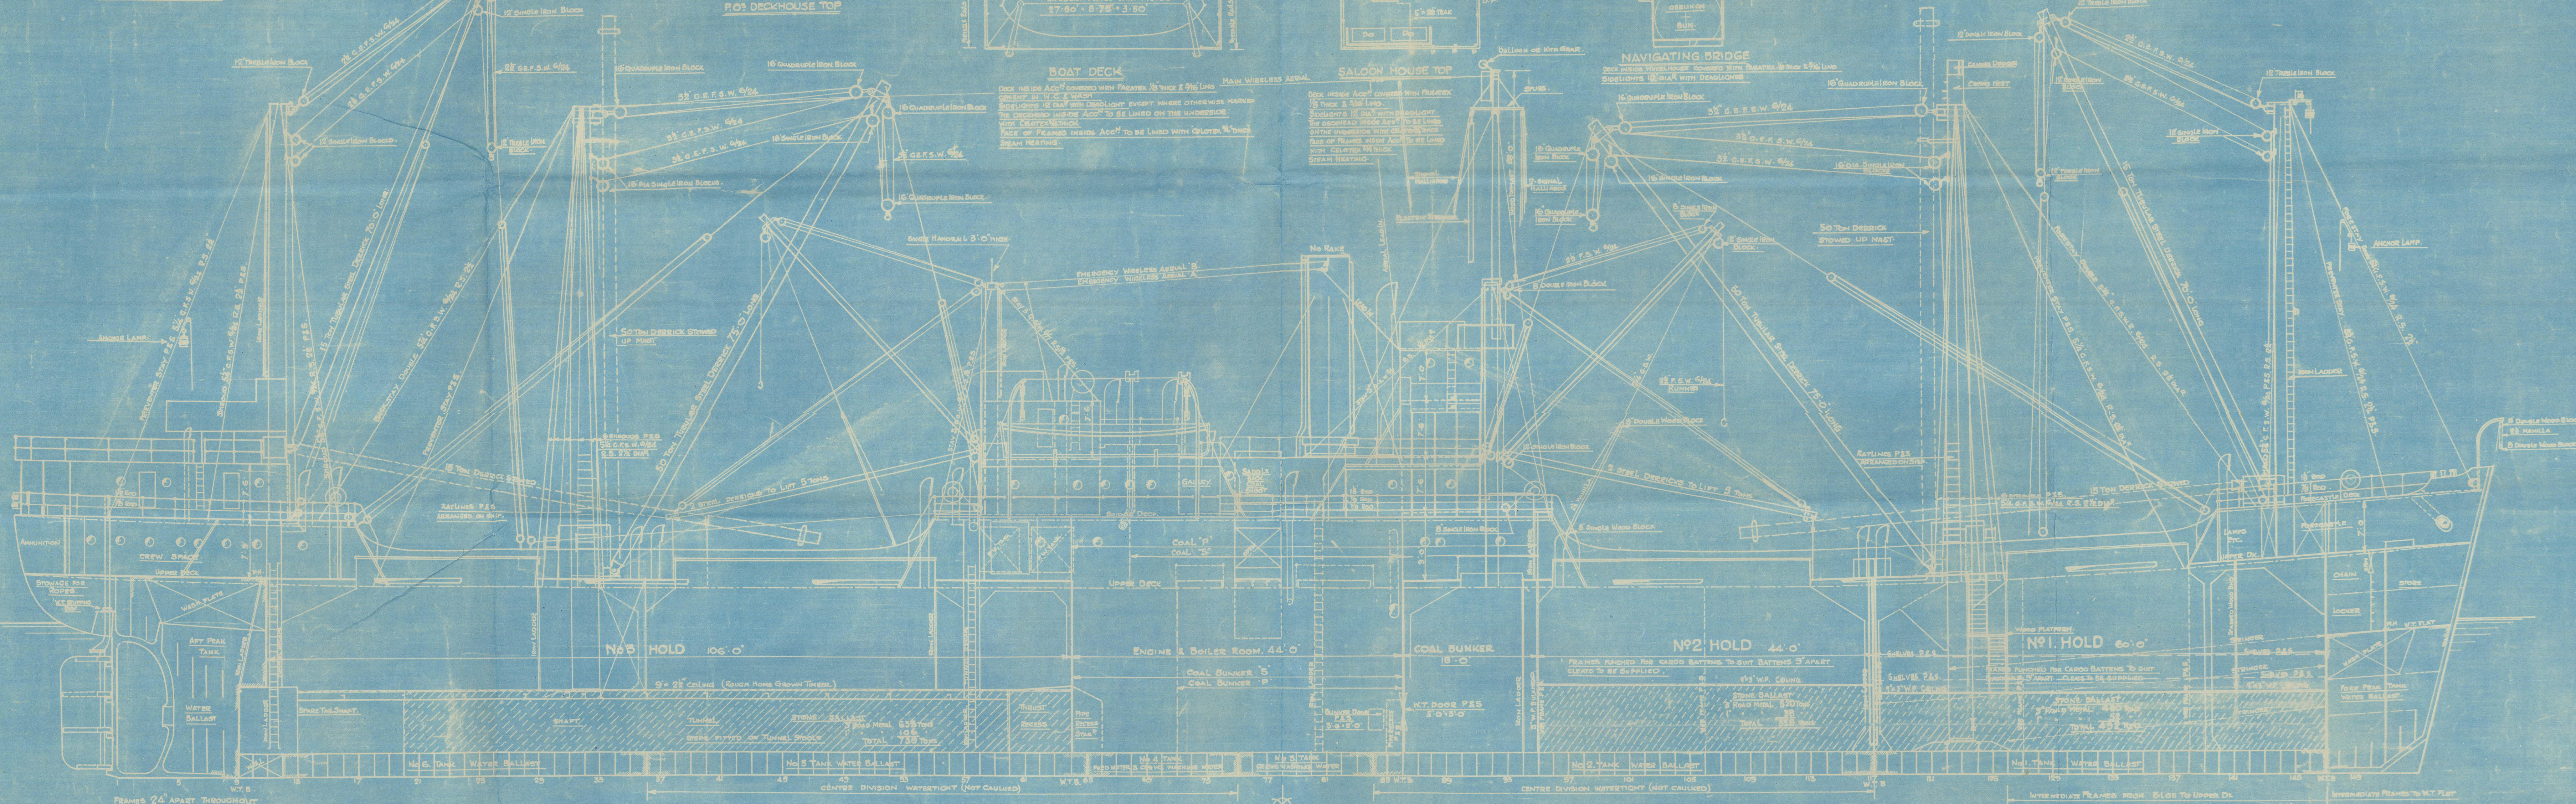


POOP DECK

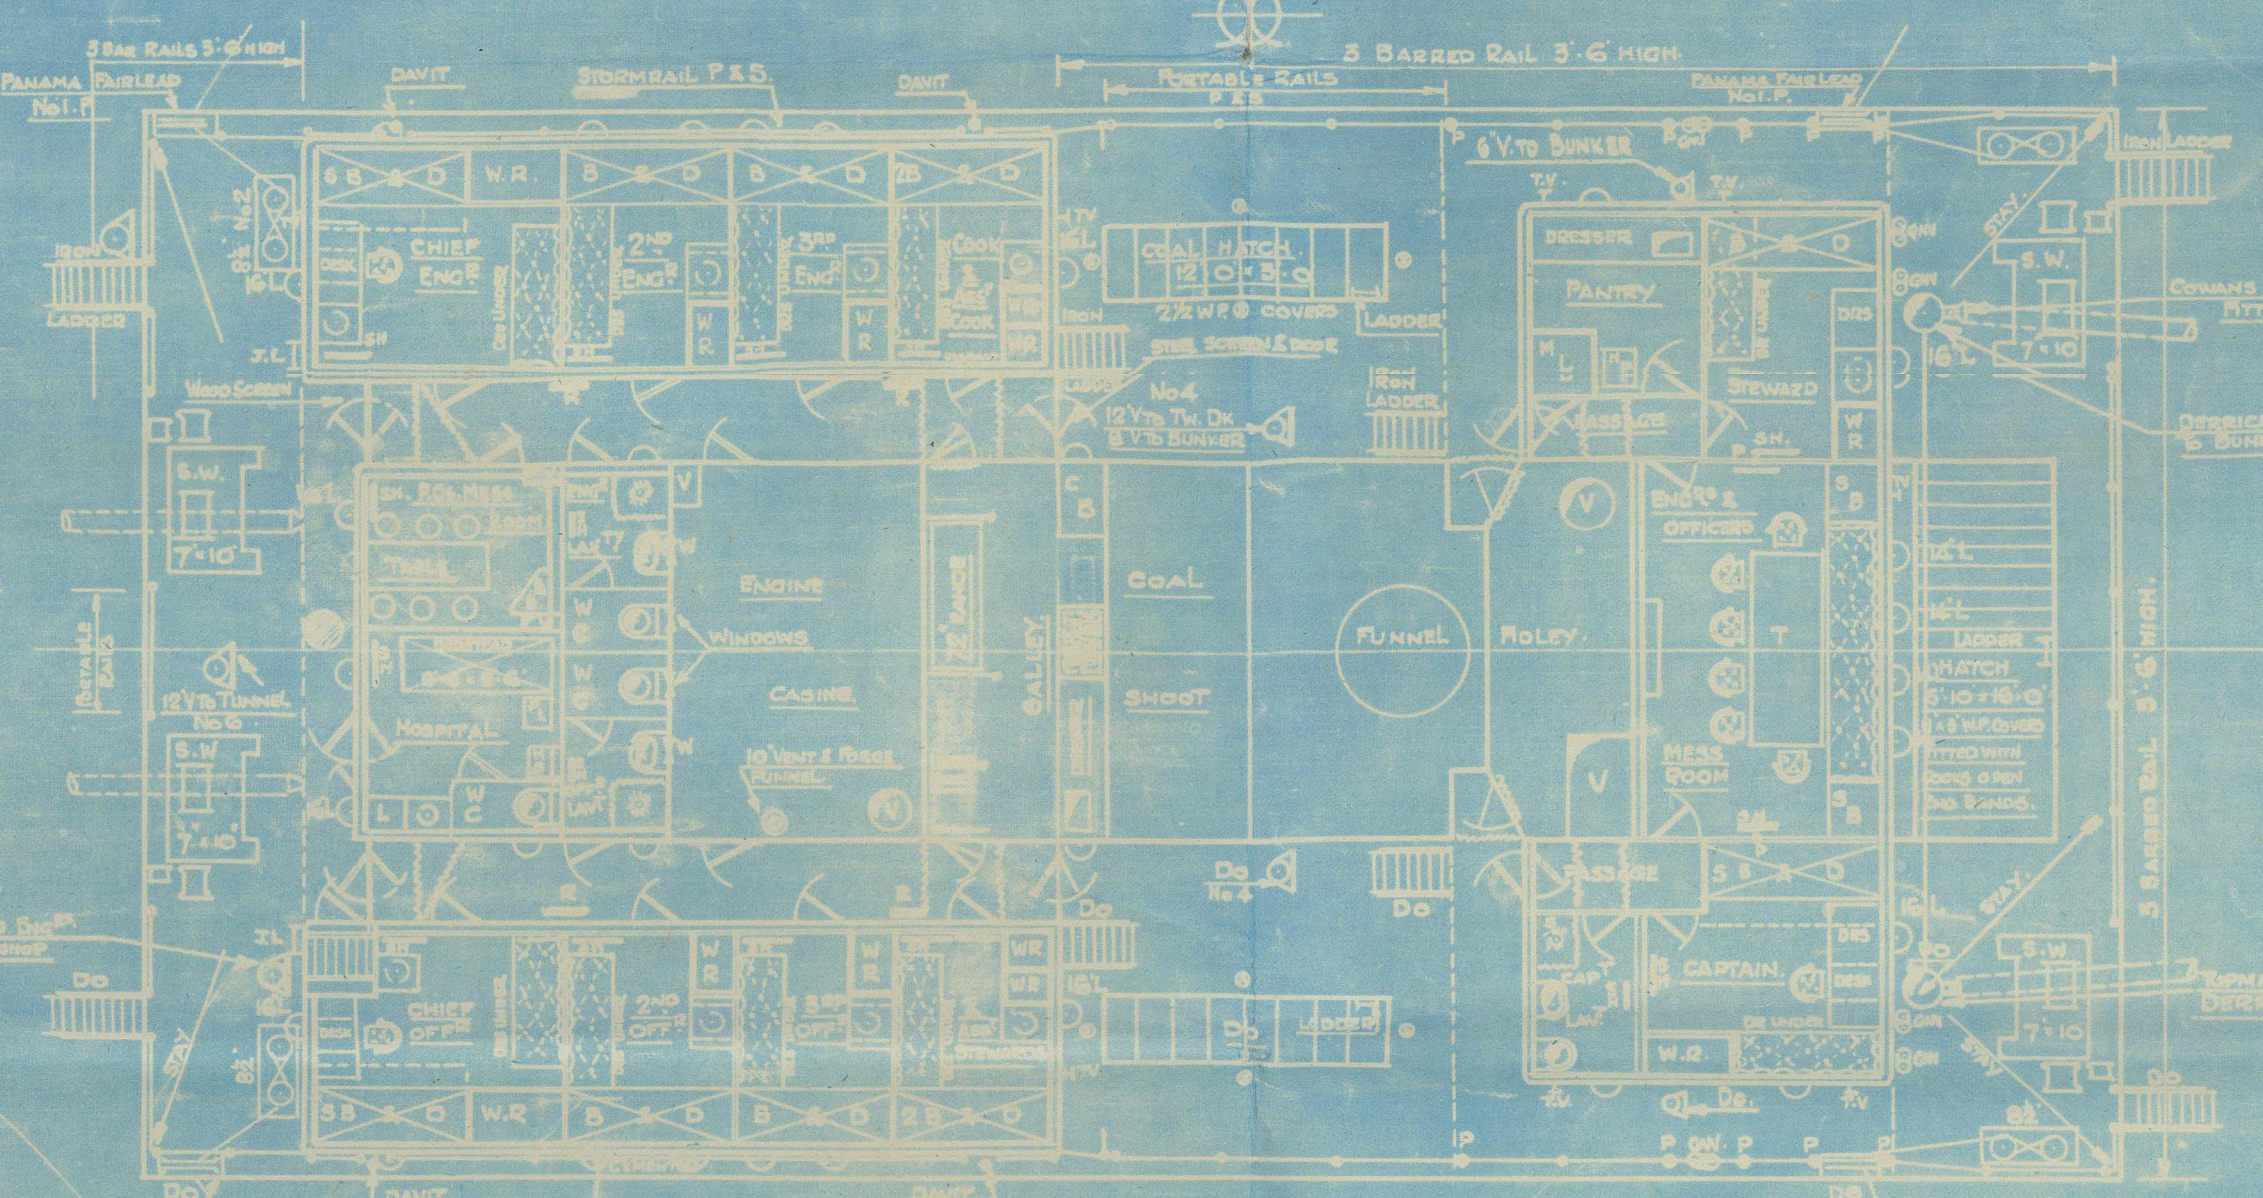

BRIDGE DECK

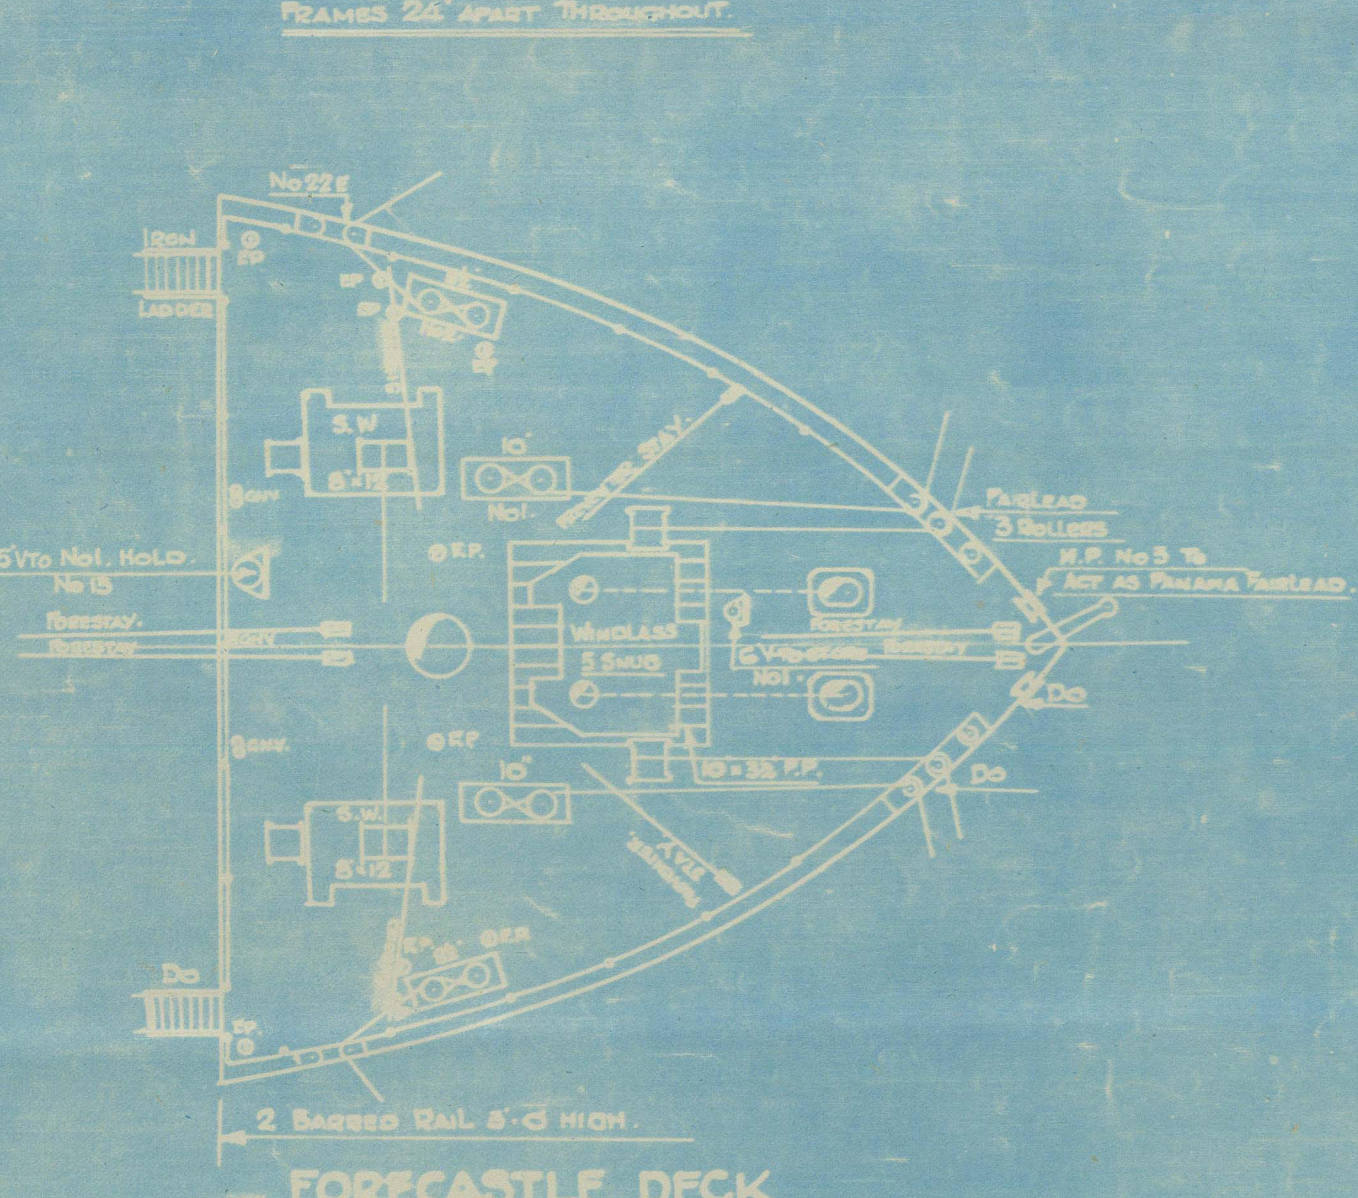

FORECASTLE DECK

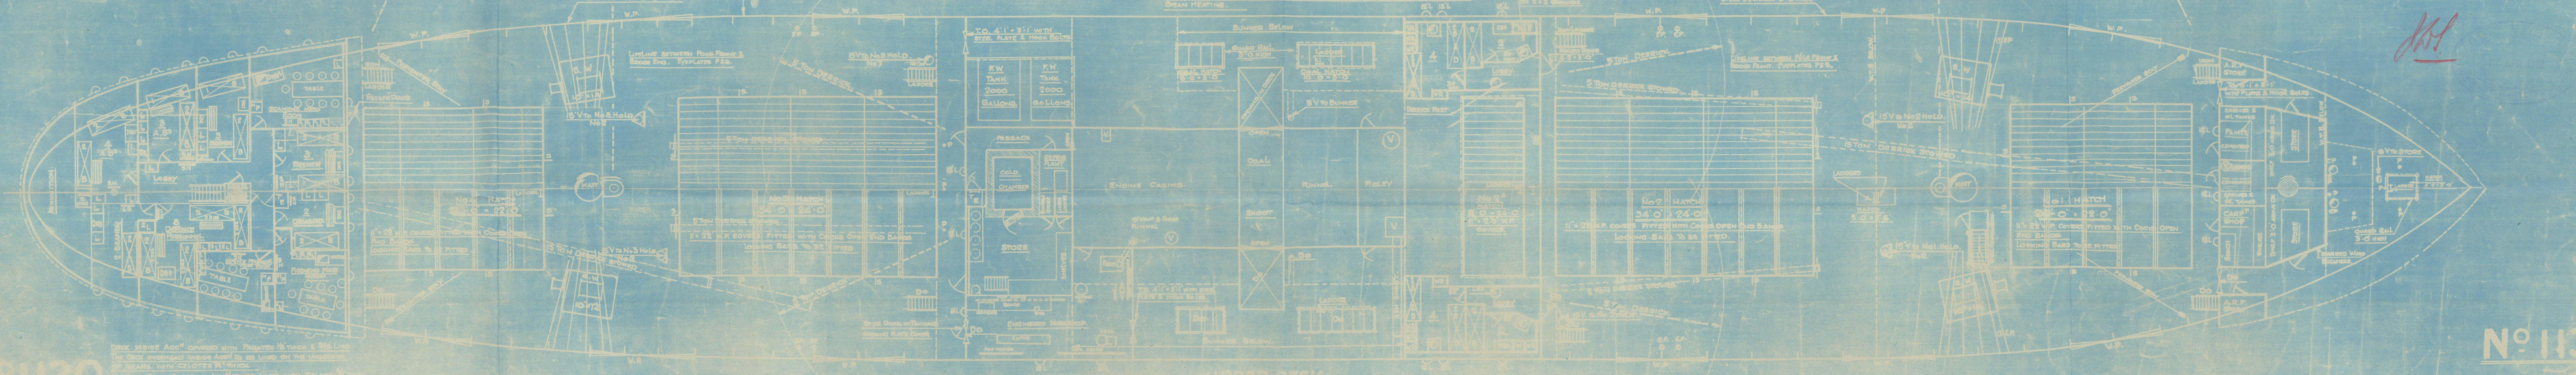

UPPER DECK

Nº 1130

Grays 1130
EMPIRE ELGAR

GENERAL ARRANGEMENT (AS FITTED)

W. Hpl Rpt No. 18281.

SLITAN

* EX MARANDELLAS



© 2021

Lloyd's Register
Foundation

012273-012278-0065