

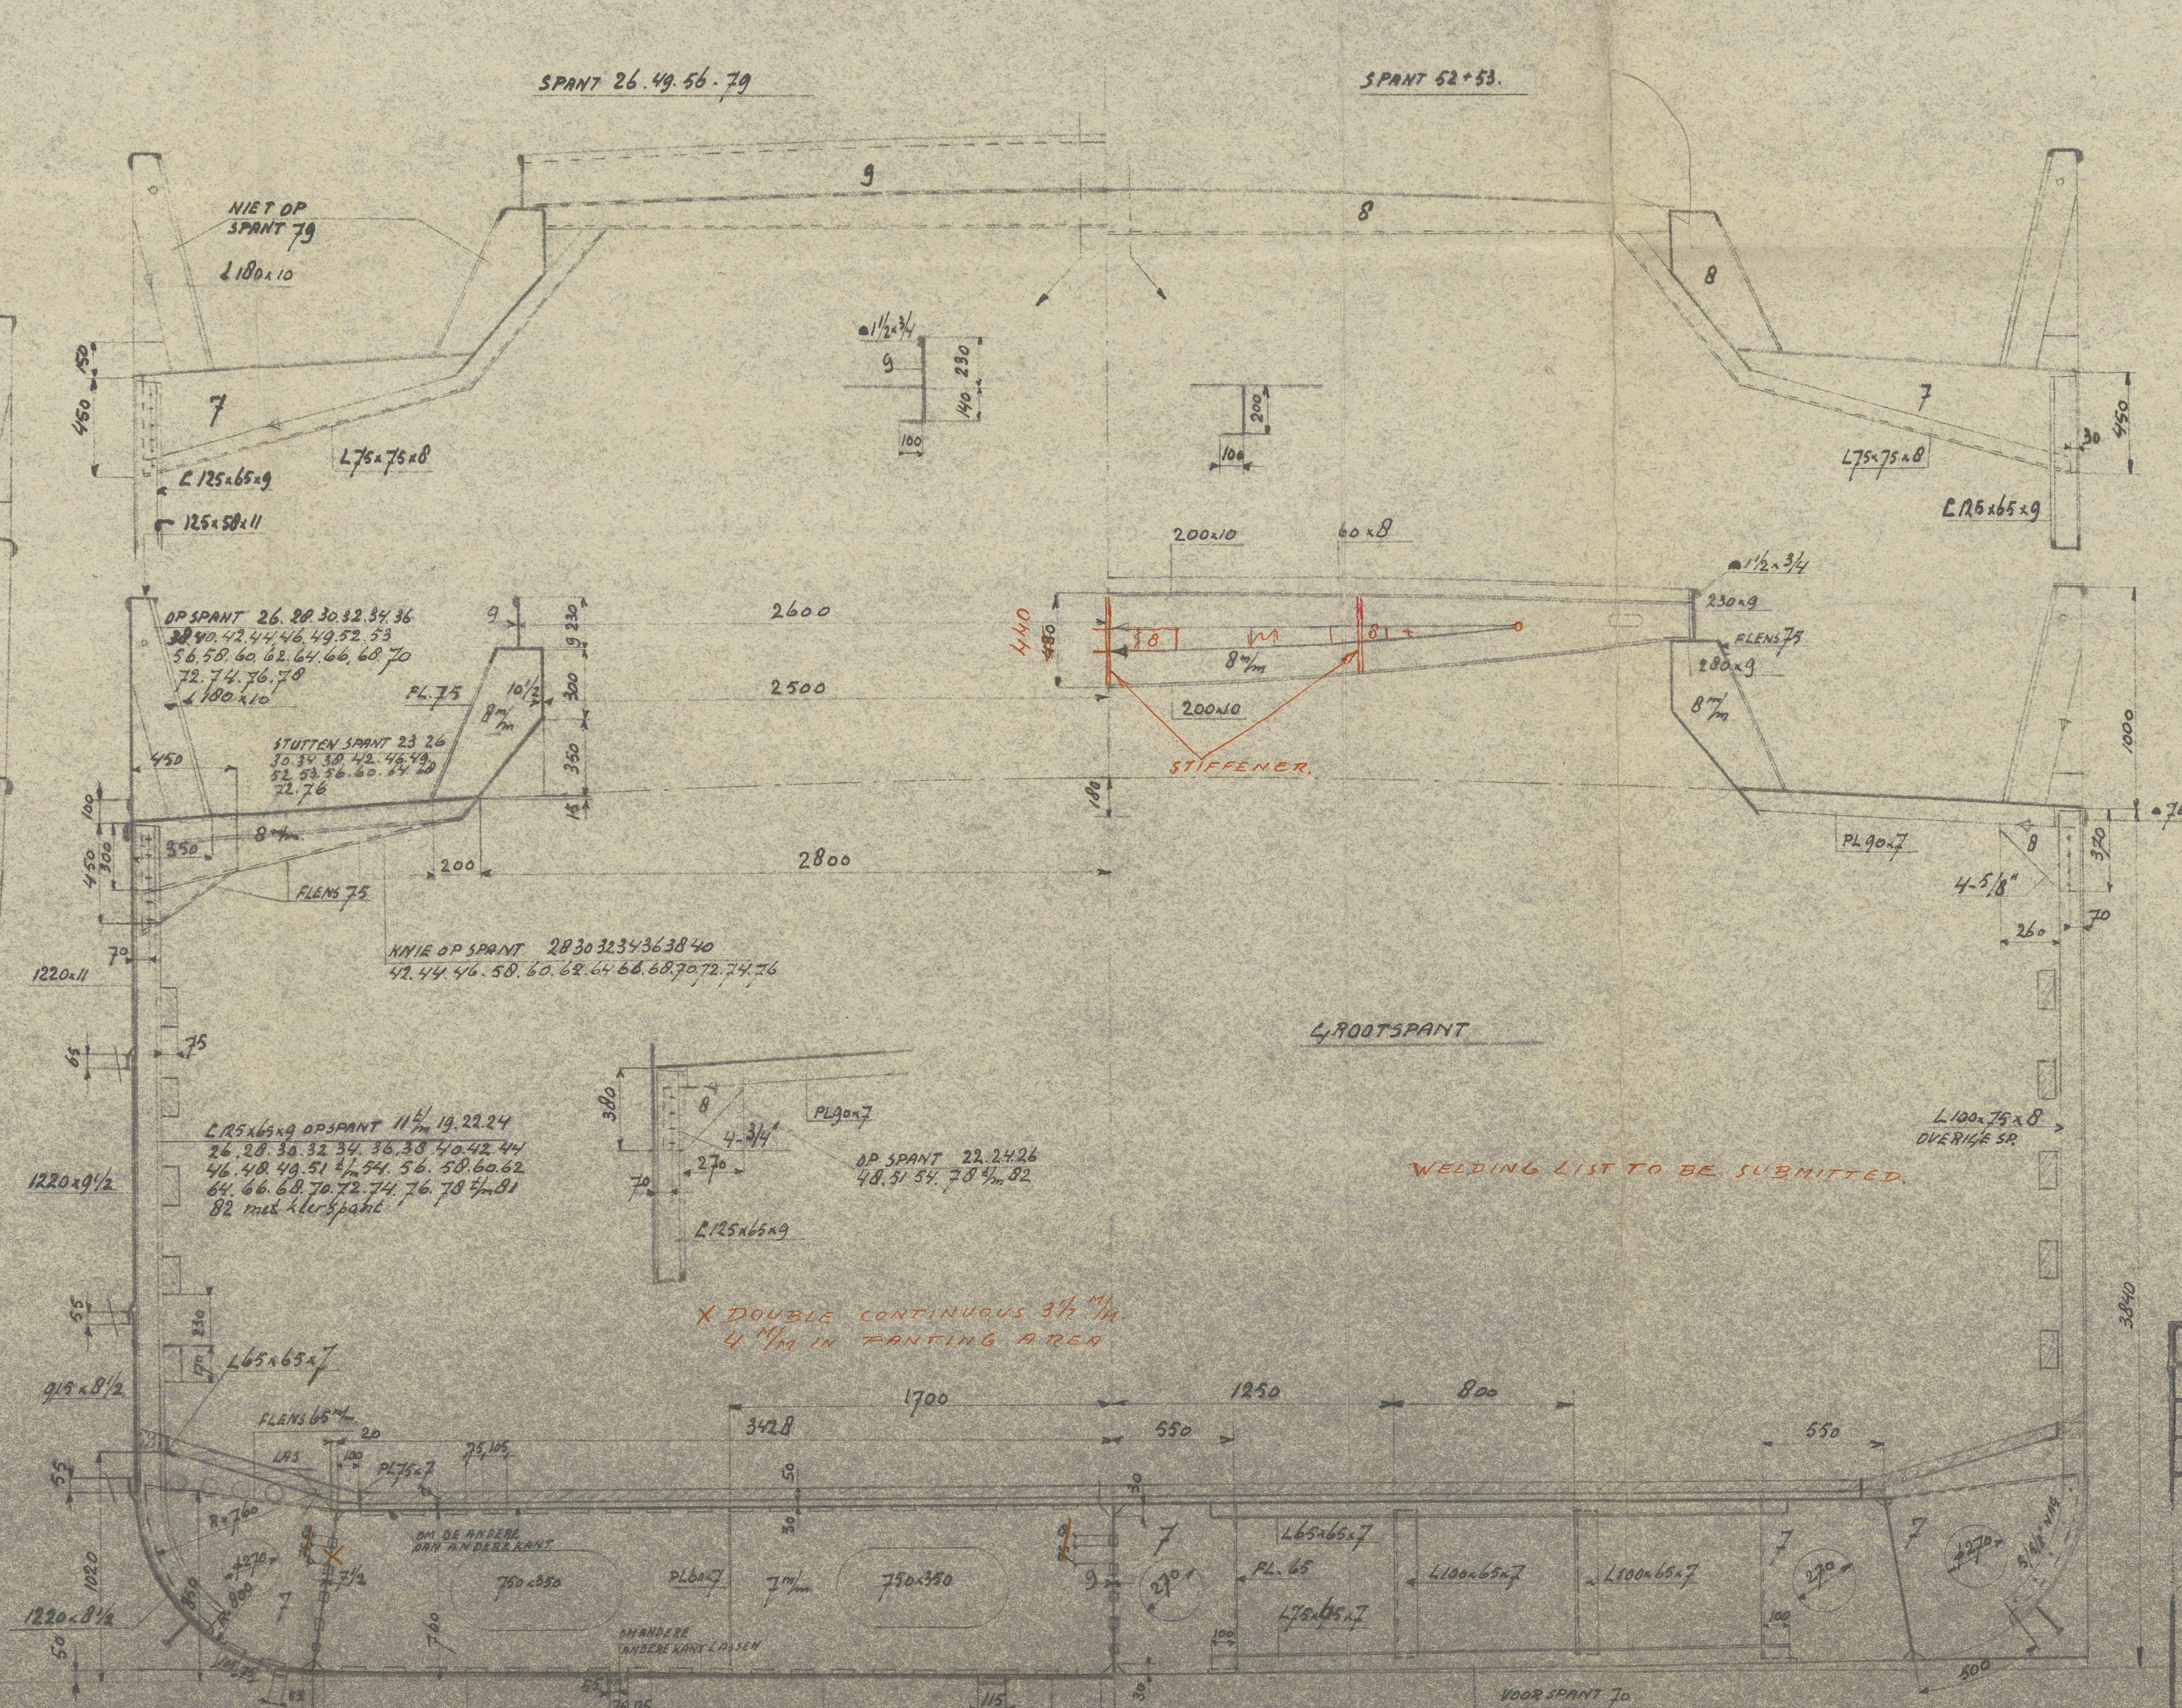


24-2-47

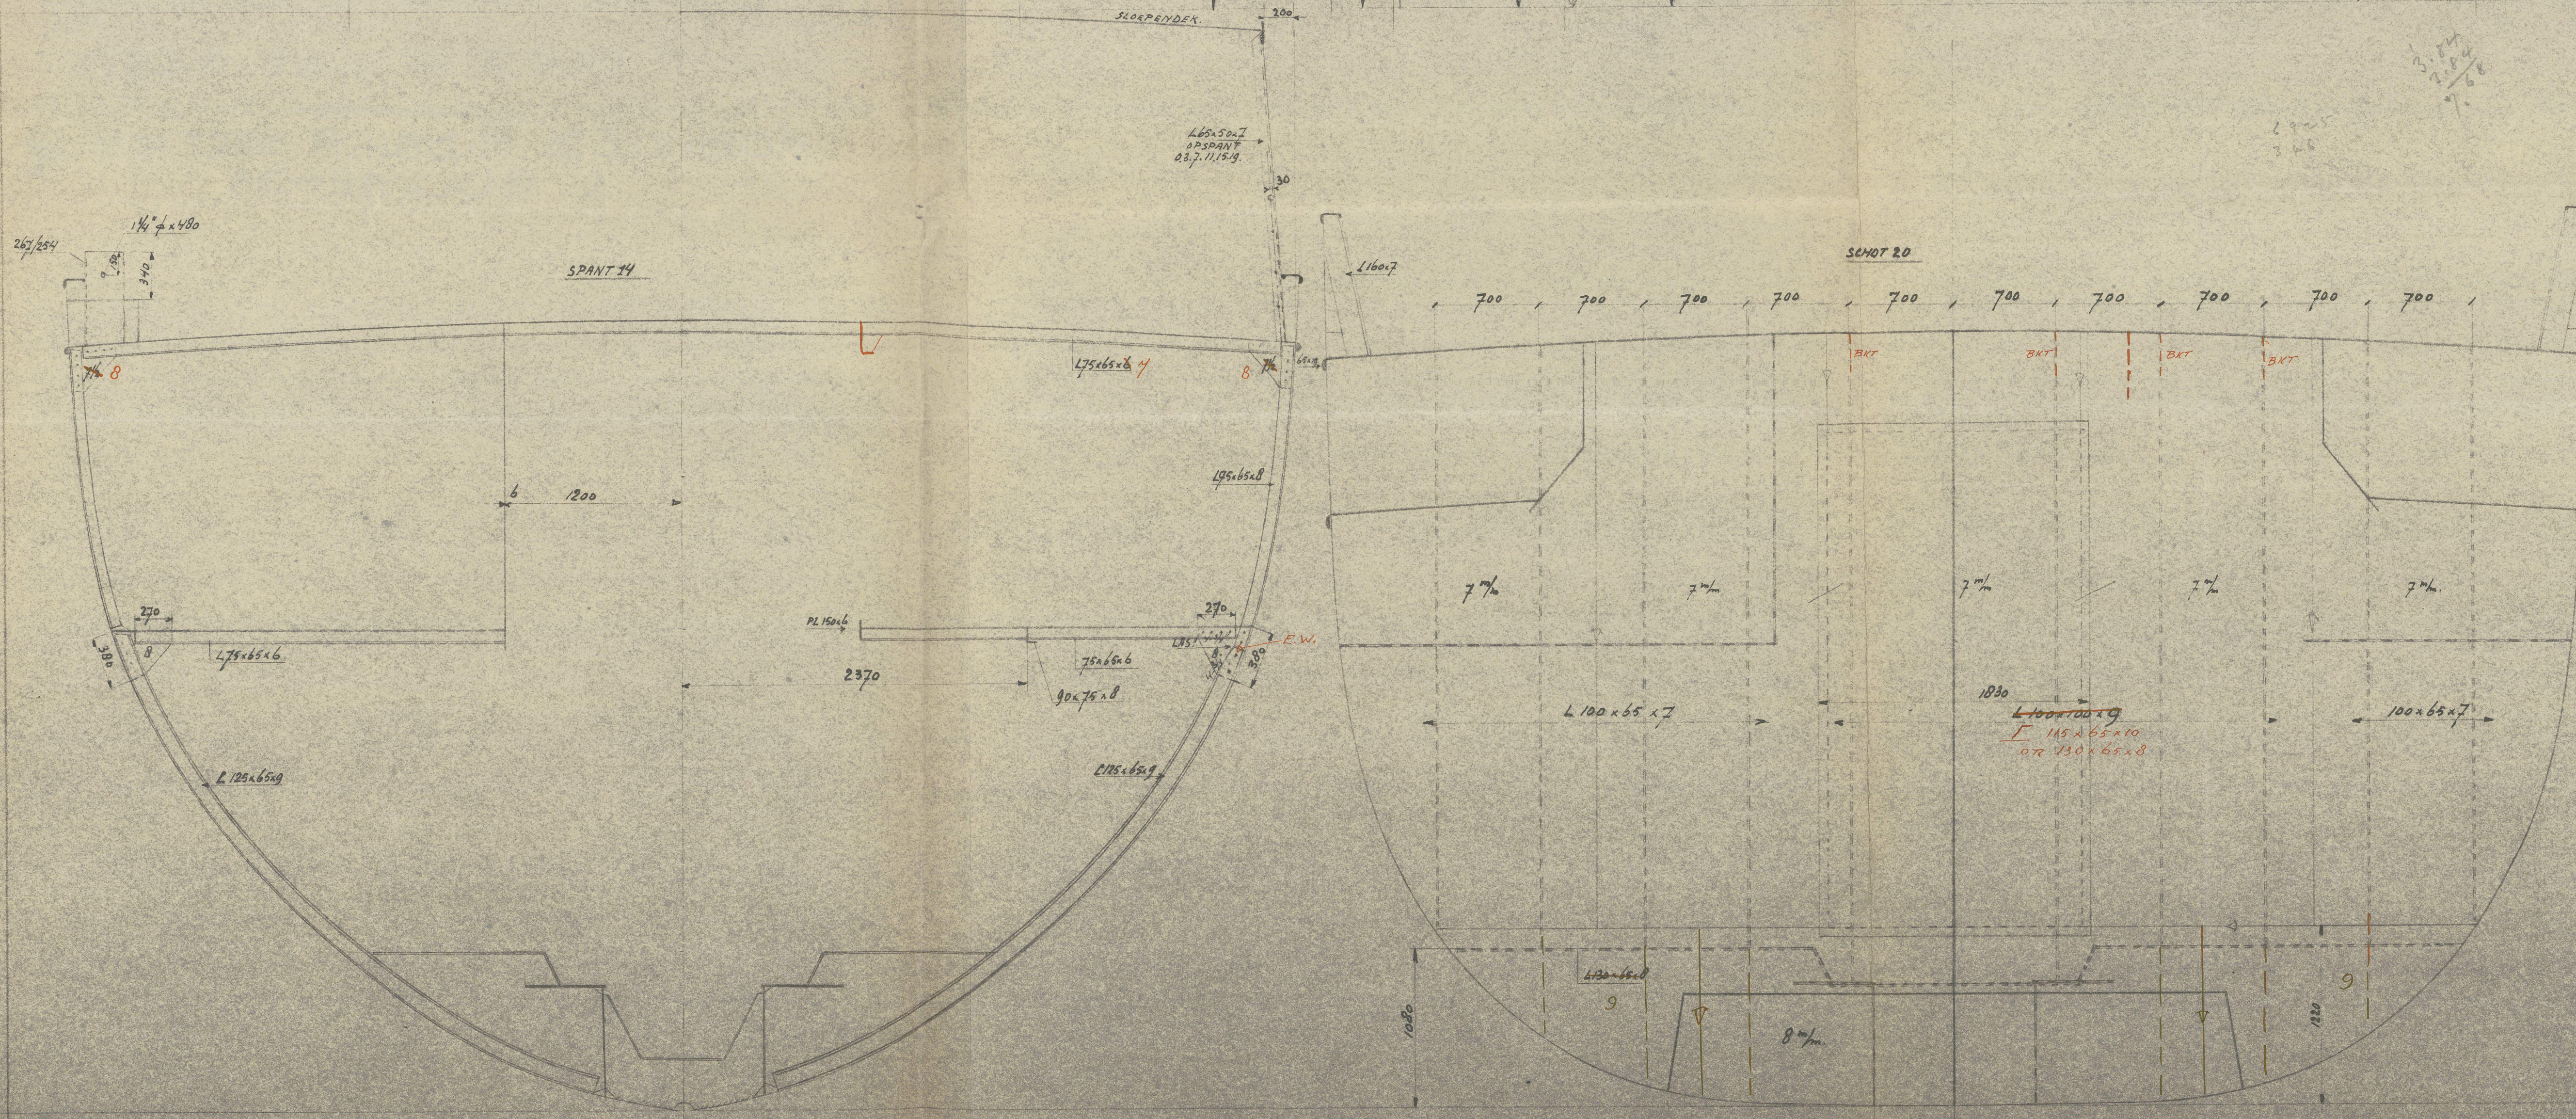

Schaal: 1:25	Datum: 1/2/47	Betree:
Geschied: 1/2/47	Gecontroleerd: 1/2/47	NOTARIS: 5/60 x 8.66 x 3.84
Gezien:		
CONSTRUCTIEPLAN II A (SCHOTTEN)		
N.V. ZAAANLANDSCHE SCHEEPSB.MIJ. - ZAANDAM		No. 44B-6A

24-2-47

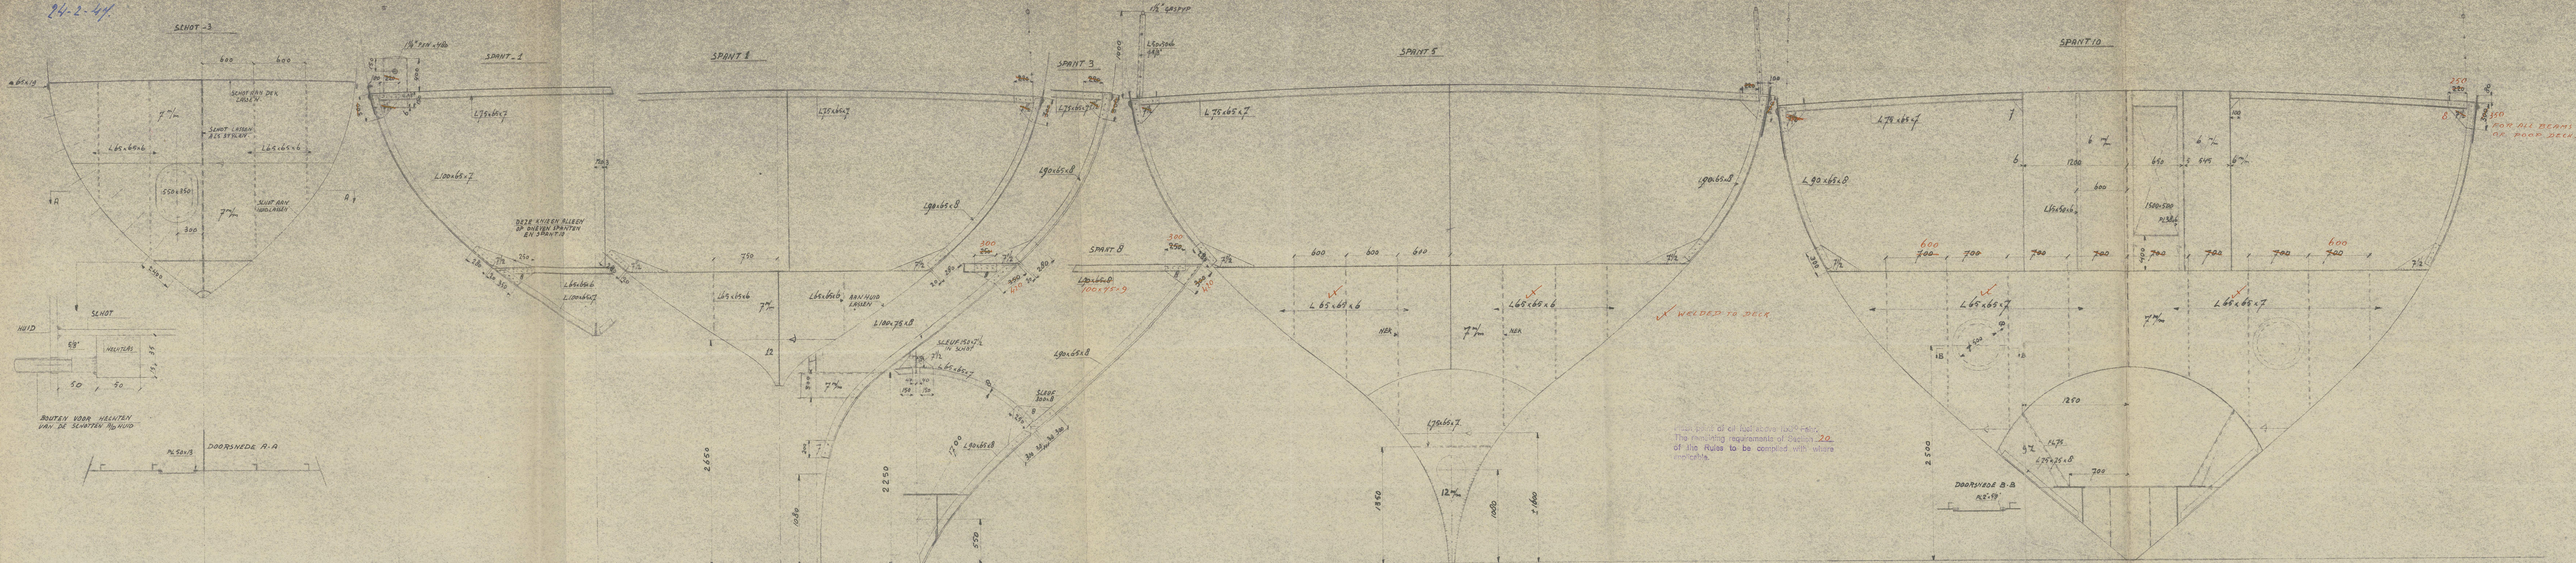



RECORDS DEPT:  
LONDON

12

" PRINSENGRACHT ★

Z A A N L A N D S C H E S C H E E P S .

Y A R D . N ° 4 4 8 . & 4 5 1

© 2021

MODIFIED MIDSHIP SECTION  
& BULKHEADS

Ships Register  
Foundation



ZAANLANDSCHE  
SCHEEPSBOUW M.Y.

YARD N° 448

MIDSHIP SECTION (MODIFIED)

BULKHEADS.



© 2021

Lloyd's Register  
Foundation