


1-2-47


SPANT 26-49-56-79

SPANT 52+53

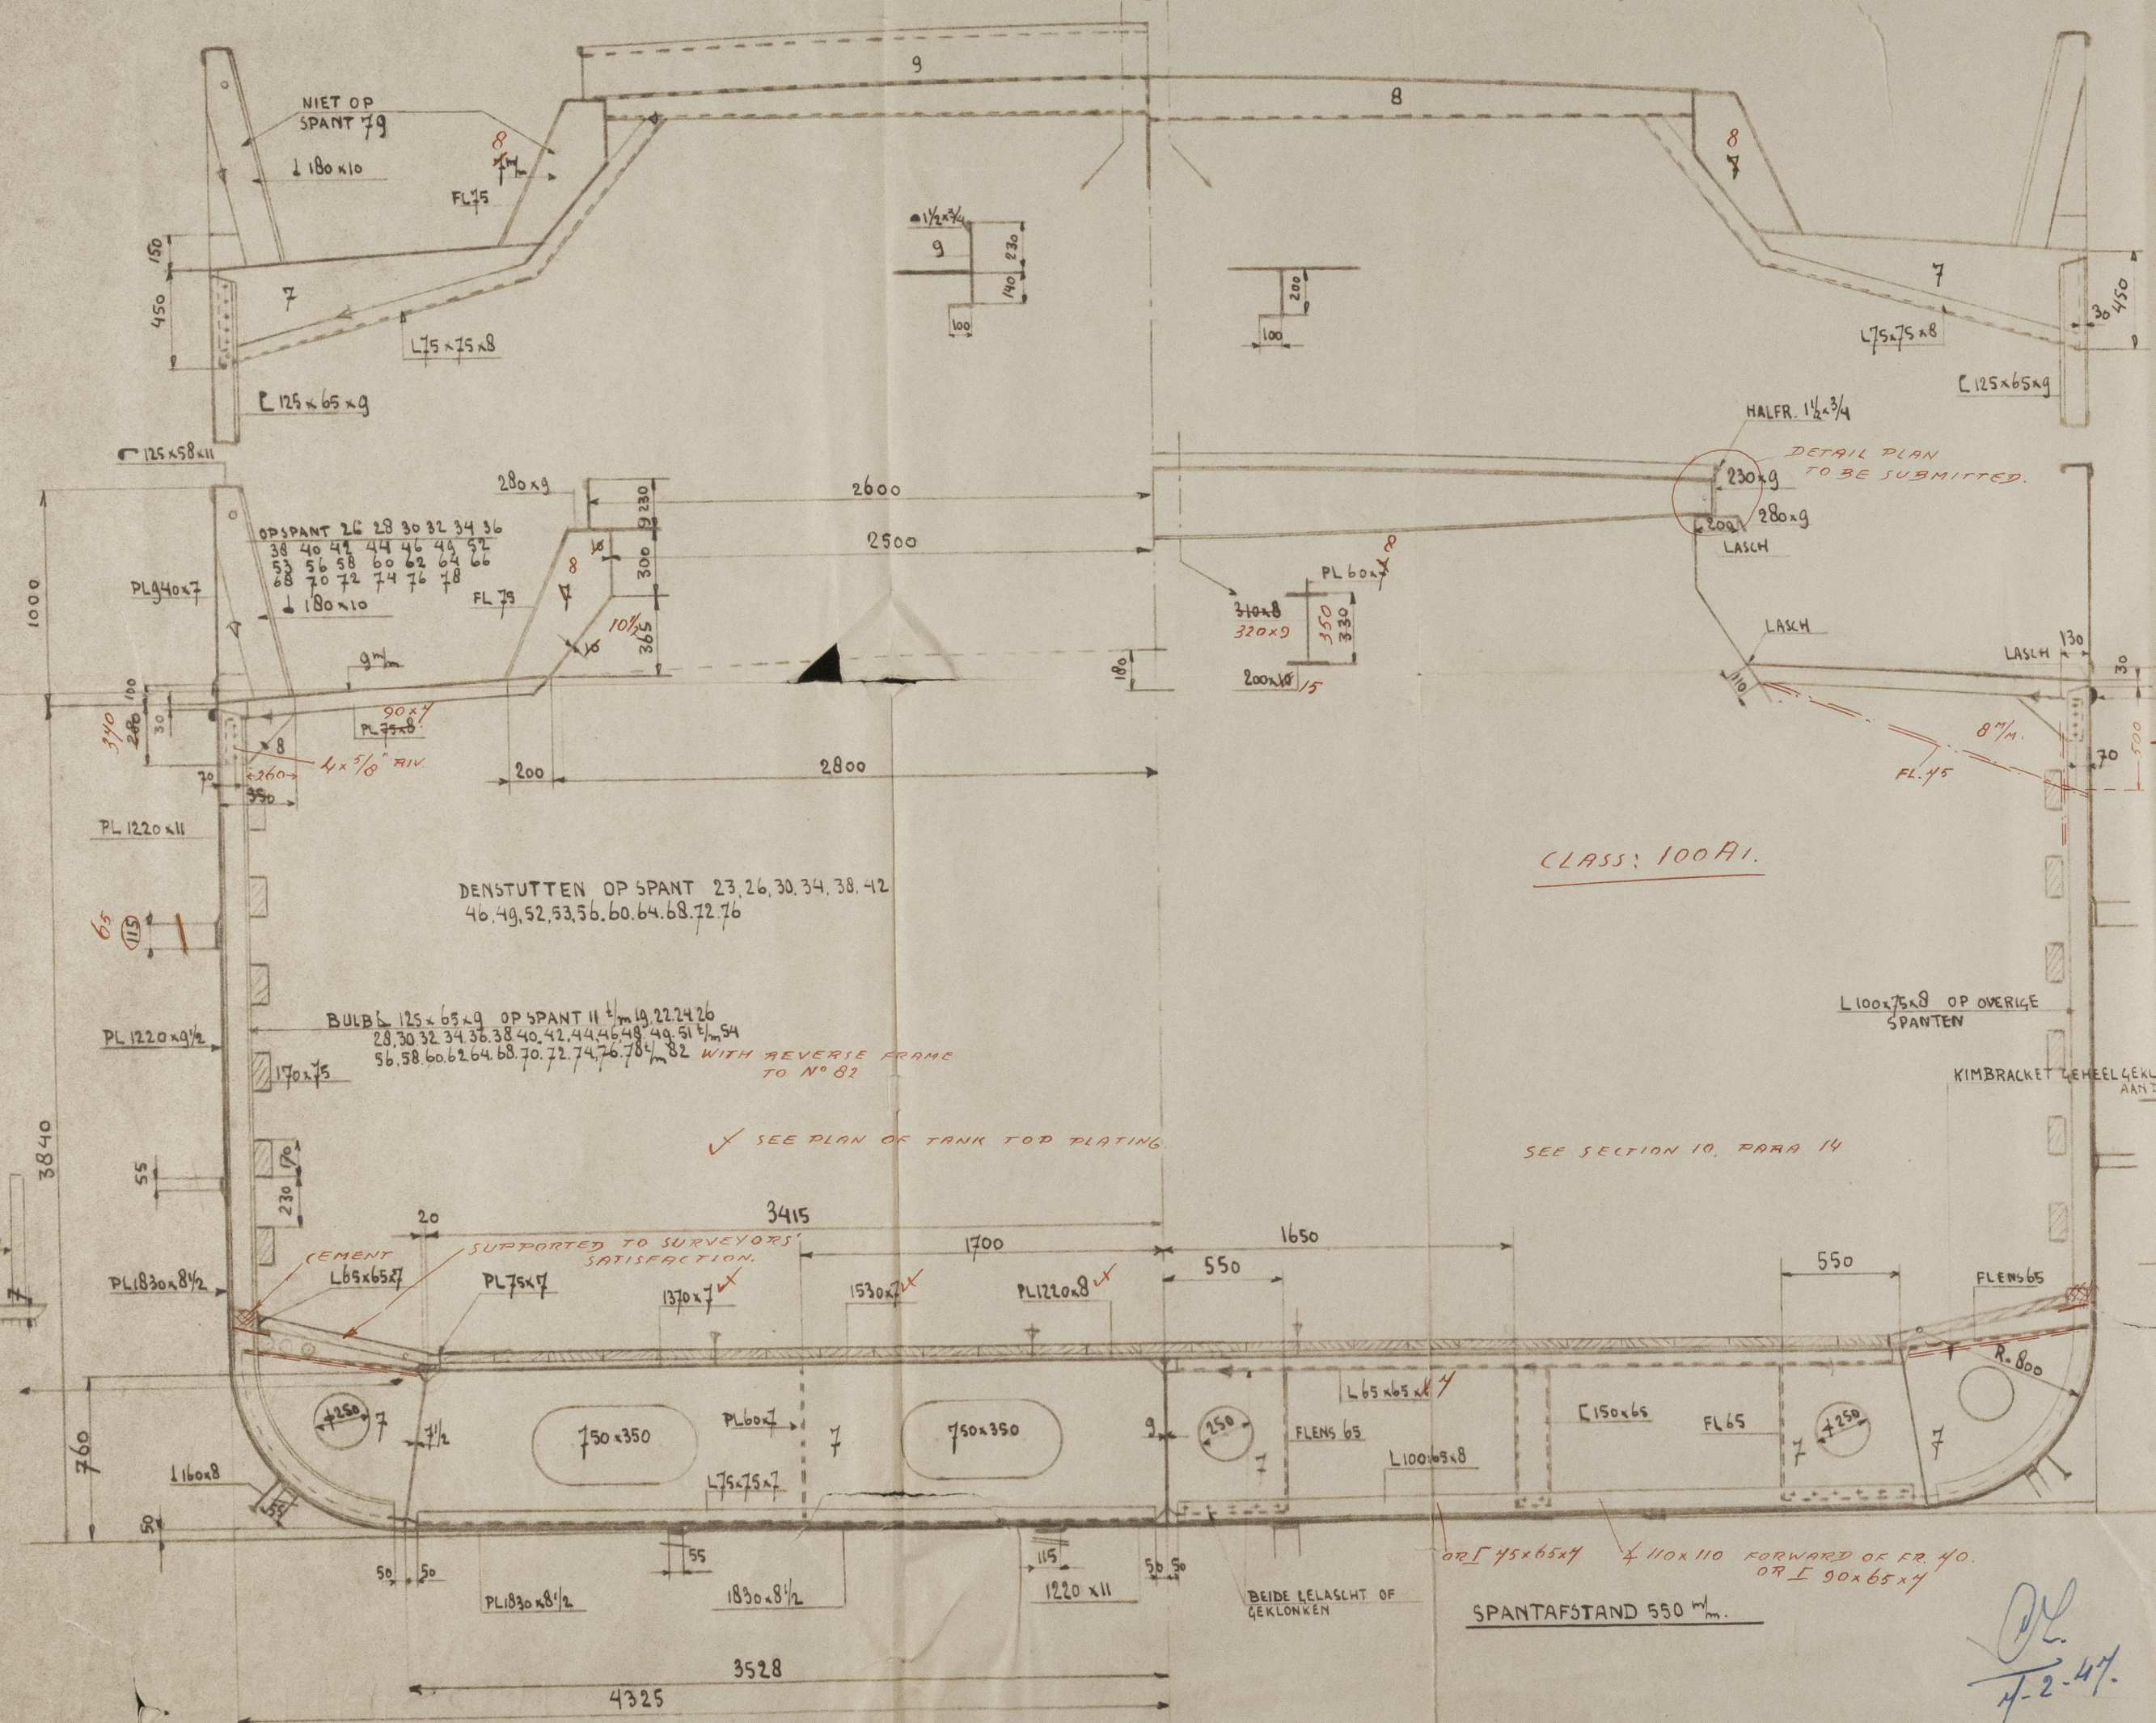

CLASS: 100 A1.

SEE SECTION 10, PARA 14

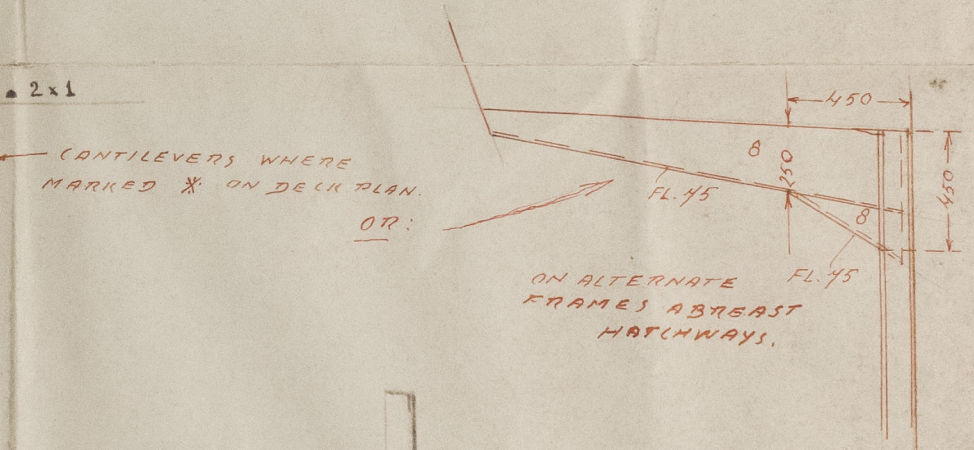

Maat: 1:25	Datum: 30/9.46	Betreft: MOTORLOASTER
Geteekend: J. de Jong	Gecontroleerd: J. de Jong	
Gezien: J. de Jong		

GROOTSPANT

N.V. ZAAANLANDSCHE SCHEEPSB.MIJ. - ZAANDAM

Formaat No. 448-6^A
Lloyd's Register Foundation

1-2-47

01142-01305-0032



7

N.V. ZAAANLANDSCHE
SCHEEPSBOUW M.Y.

YARD No 448

MIDSHIP SECTION

RECORDS DEPT.,
LONDON

"PRINSENGRACHT"



11

ZAAANLANDSCHE SCHEEPS.

YARD No 448 & 451

MIDSHIP SECTION



© 2021

Lloyd's Register
Foundation