

NOTE:-

F.T. = FOLDING TABLE.


W.B. = WASH BASIN.

S.H. = SHOWER.


S. = SINK.

M.S. = MEAT SAFE.

L. = LOCKER.

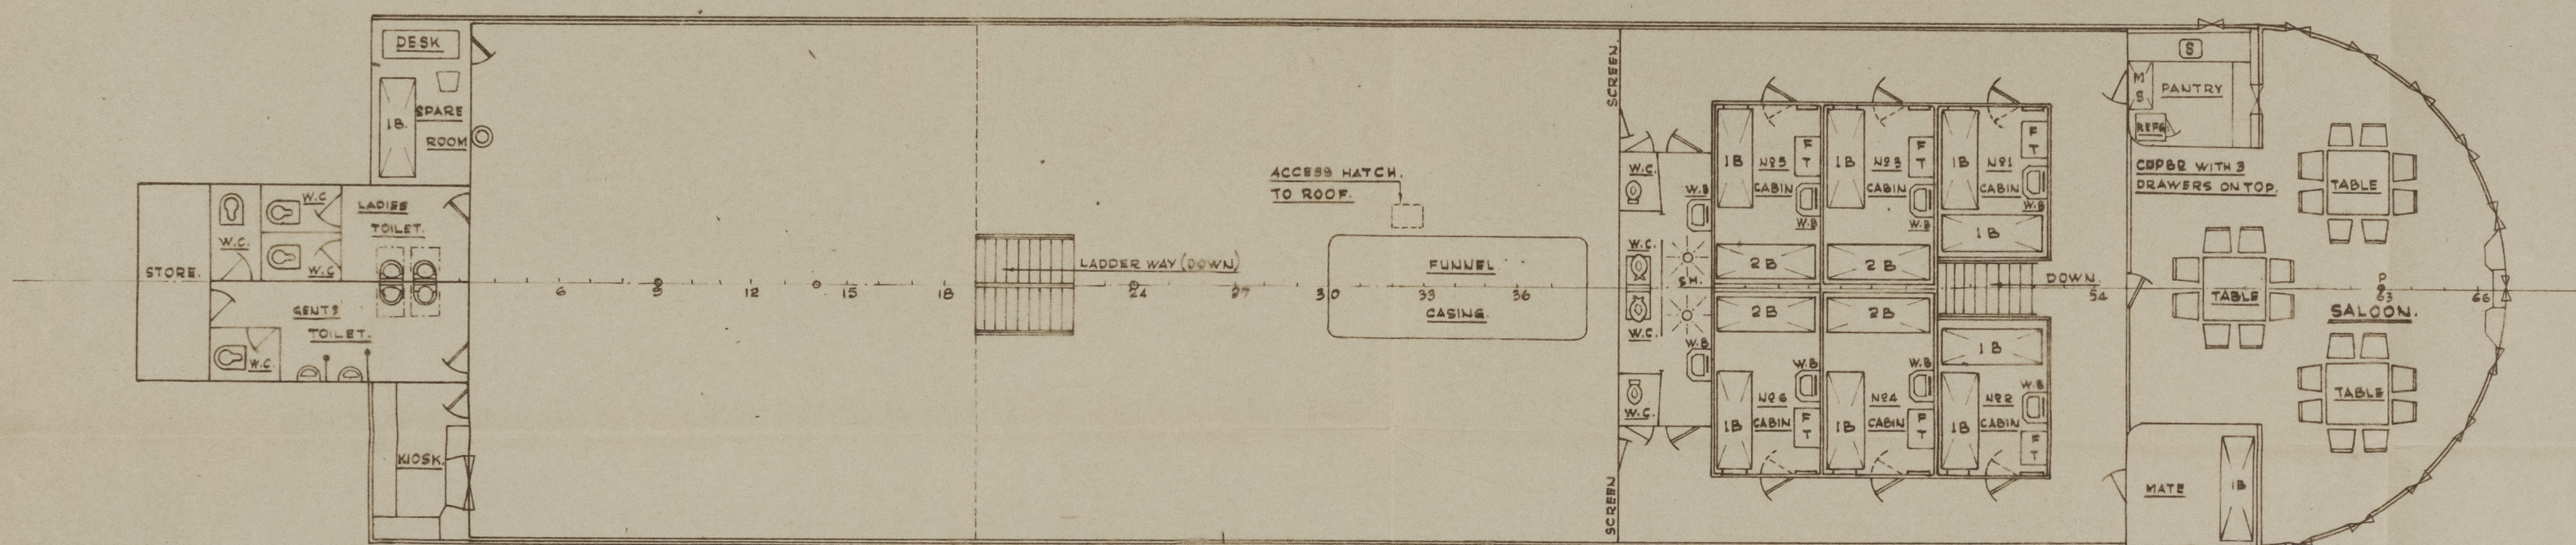

UPPER DECK

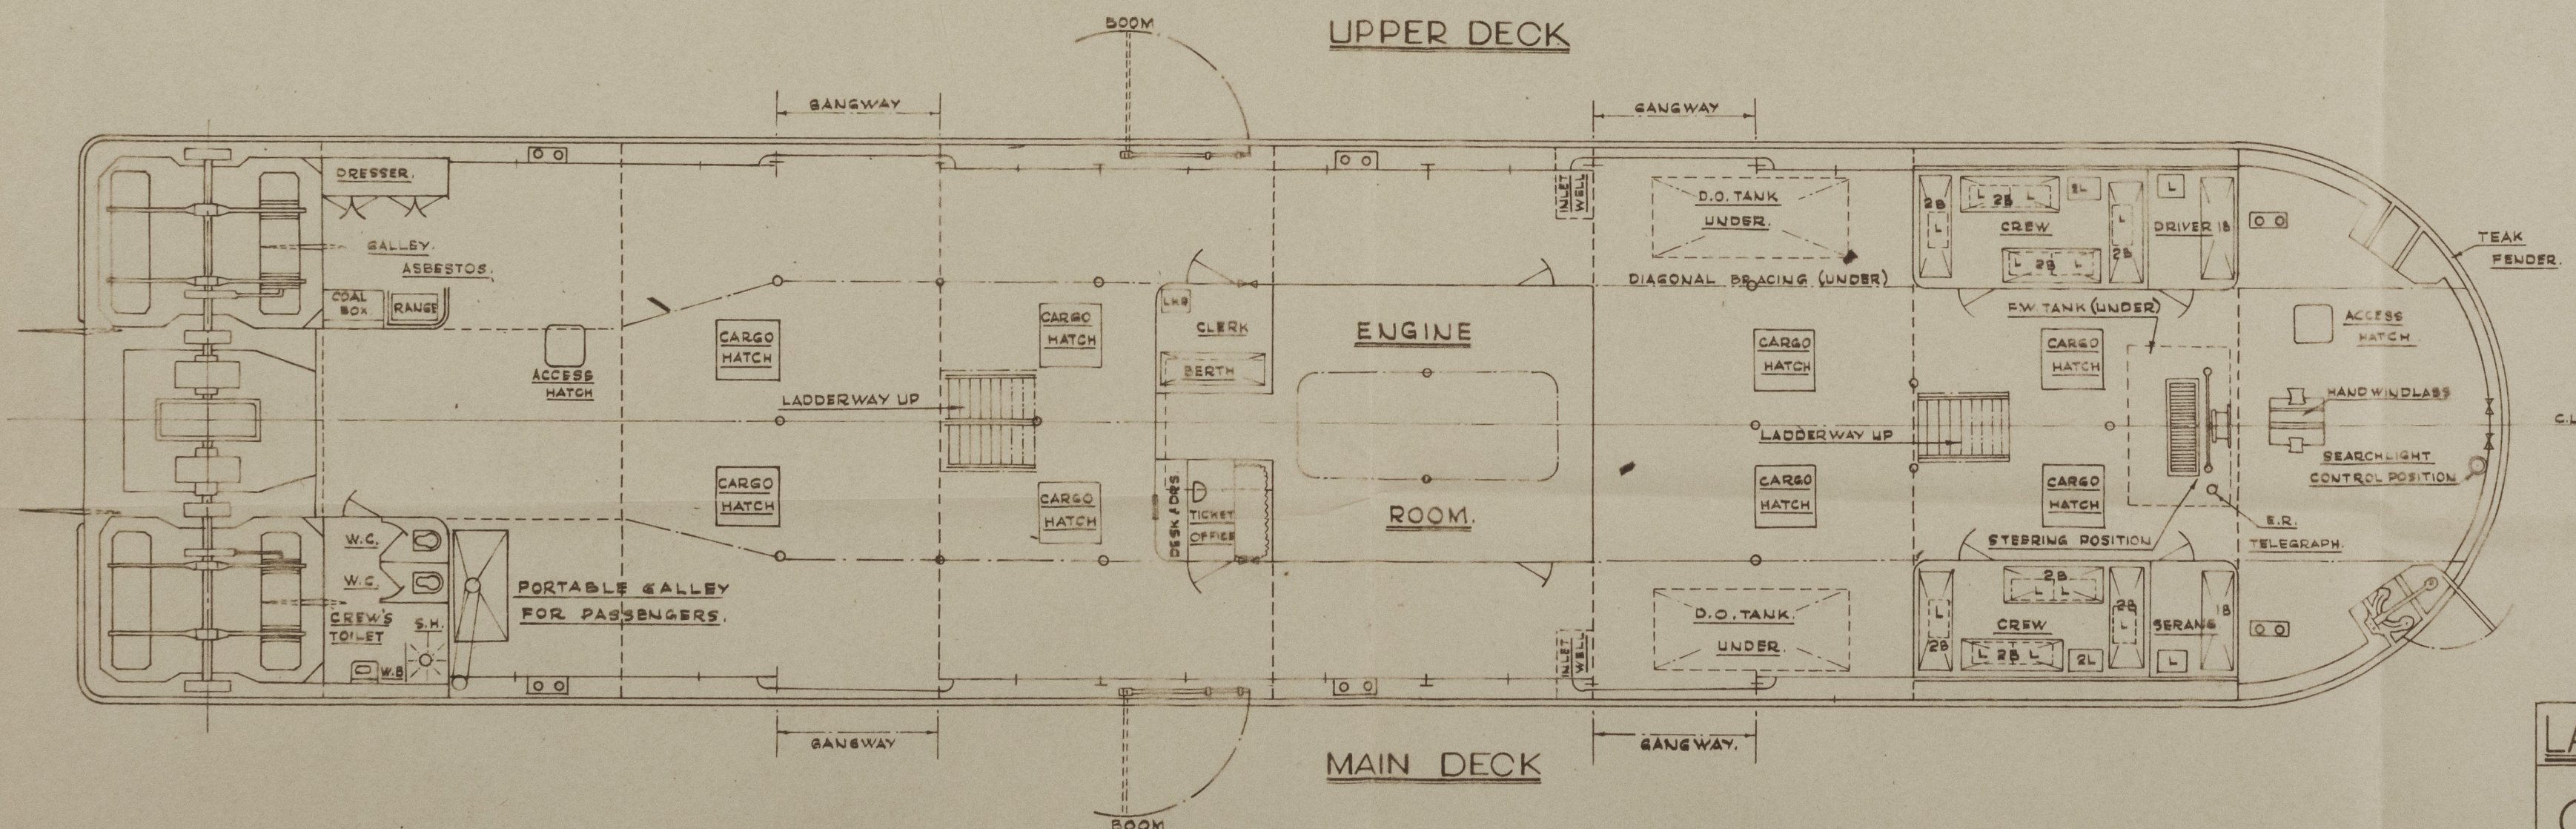

MAIN DECK

LARGE QUARTER WHEELER (130'x34'x3.6')

GENERAL ARRANGEMENT

AS FINISHED PLAN

DRAWN BY *M. G. C.* TRACED BY *M. G. C.* CHECKED BY *M. G. C.*

DATE 12.12.31 DATE 22.1.32 DATE 22.1.32

SCALE:- 1/8" = 1 FOOT DRAWING NO. R/404

012598-012605-0033

Reg N° 2150

"PADAPYAN"

General arrangement.



© 2021

Lloyd's Register
Foundation

012598-012605-0033