


RIGGING PLAN. SHOWING PROPOSED POSITION OF ARMAMENT (IN RED)

SCALE:- $\frac{1}{8}" = \text{ONE FOOT.}$

DIMENSIONS: - 420'-0" B.P. x 57'-3" MLD. x 28'-6" MLD. TO 2ND OK

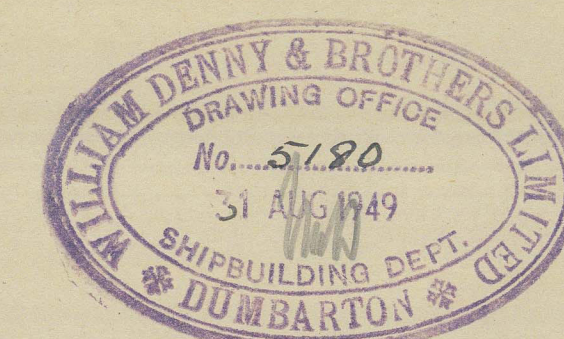

GLASGOW REPORT No. 74762

GLASGOW REPORT No. 78220

S.S. OLINDA ★

Nº 1432.

WILLIAM DENNY & BROS. LD.
DUMBARTON

RIGGING PLAN.

RECORDS DEPT.
LONDON

3



© 2021

Lloyd's Register
Foundation

012620-012623-0121