

2/4/96/61

TS. DIESEL PASSENGER & VEHICLE FERRY.

MIDSHIP SECTION.

SCALE - HALF INCH TO ONE FOOT

DIMENSIONS: LENGTH W/L 180'-0" (9% FOR LLOYDS = 172'-9")


BREADTH MLD 40'-0"

DEPTH MLD 11'-7"

LOAD DRAFT 7'-0"

TO MINISTRY OF TRANSPORT CLASS & CERTIFICATE

TO LLOYDS CLASS A-1 FOR SERVICE BETWEEN SOUTHAMPTON AND COWES

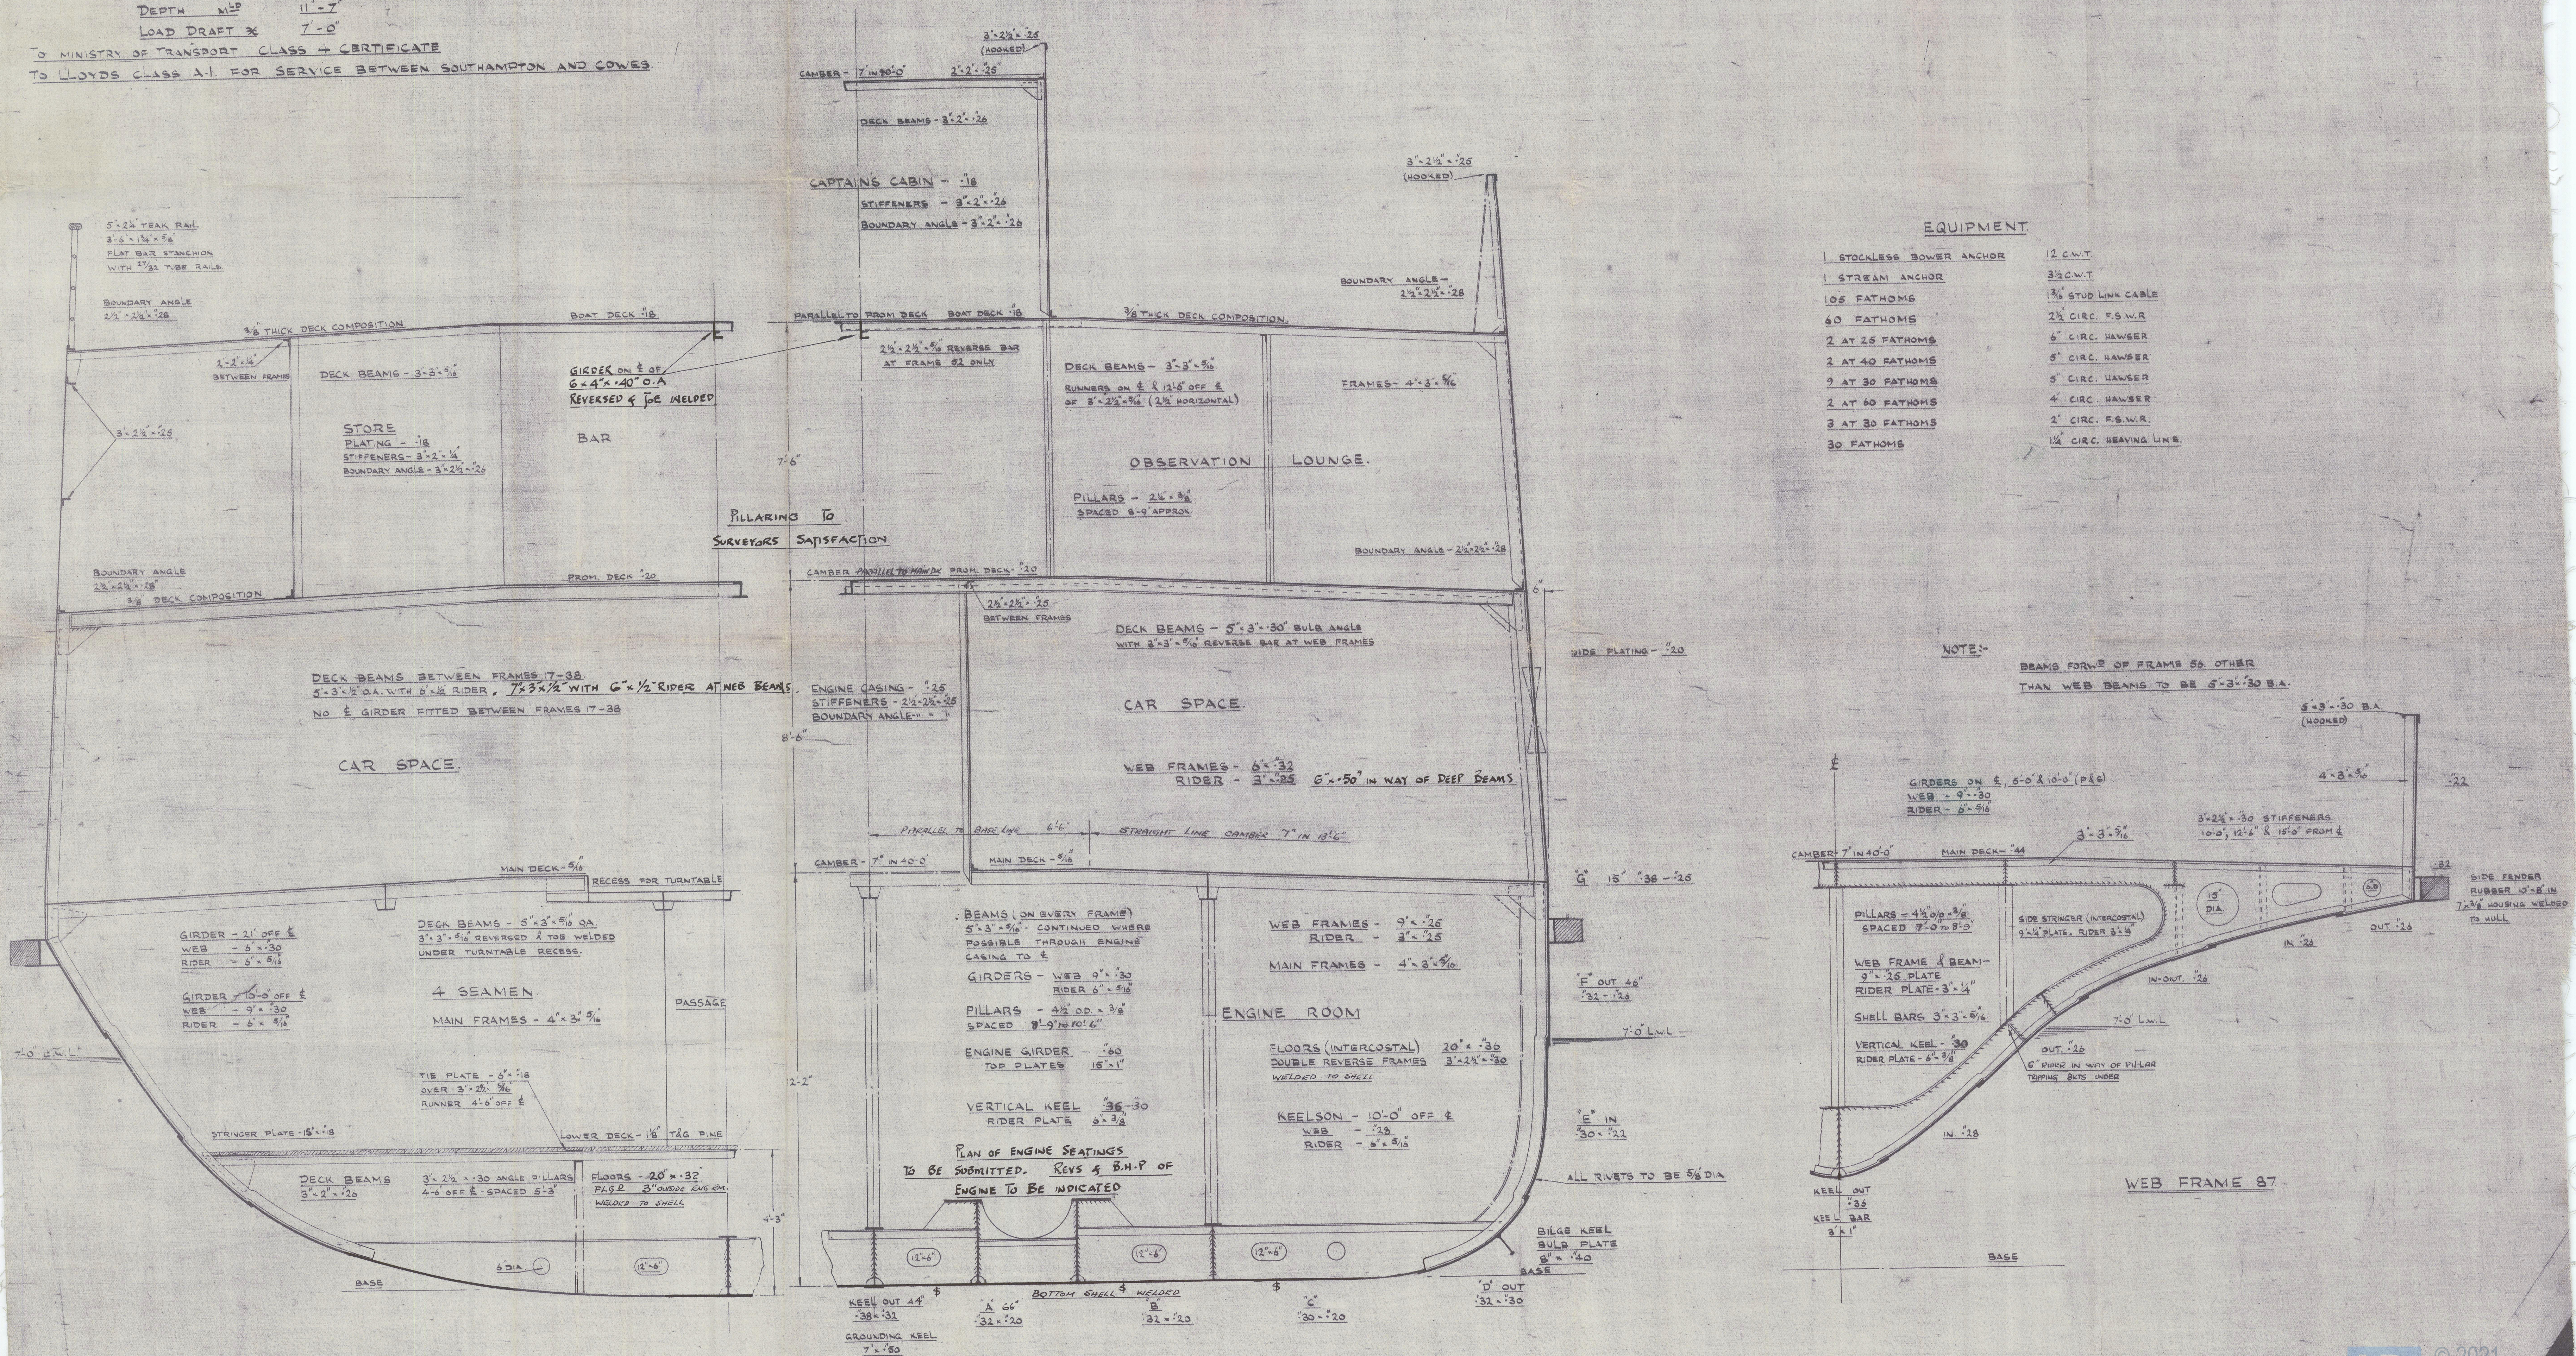

MIDSHIP SECTION.

SECTION AT FRAME 28

012694-012698-0043

NAME *OSBORNE CASTLE*

SOUTHAMPTON REPORT No.

PLAN *MIDSHIP SECTION (AS FITTED)*

BUILDERS *J. I. Thornycroft*

YARD No. *4196.*

RECORDS DEPT.,
LONDON.

2



© 2021

Lloyd's Register
Foundation

012694 - 012698 - 0043