

Jan 4196

17 FEB 1961



T.2019/2.


# PROPOSED PASSENGER & VEHICLE FERRY.

## MIDSHIP SECTION.

SCALE - HALF INCH TO ONE FOOT

DIMENSIONS:- LENGTH W/L 180'-0" (96% FOR LLOYDS = 172'9")  
BREADTH MLD 40'-0"  
DEPTH MLD 11'-7"  
LOAD DRAFT 7'-0"

TO MINISTRY OF TRANSPORT CLASS + CERTIFICATE  
TO LLOYDS CLASS A1 FOR SERVICE BETWEEN SOUTHAMPTON AND COWES.

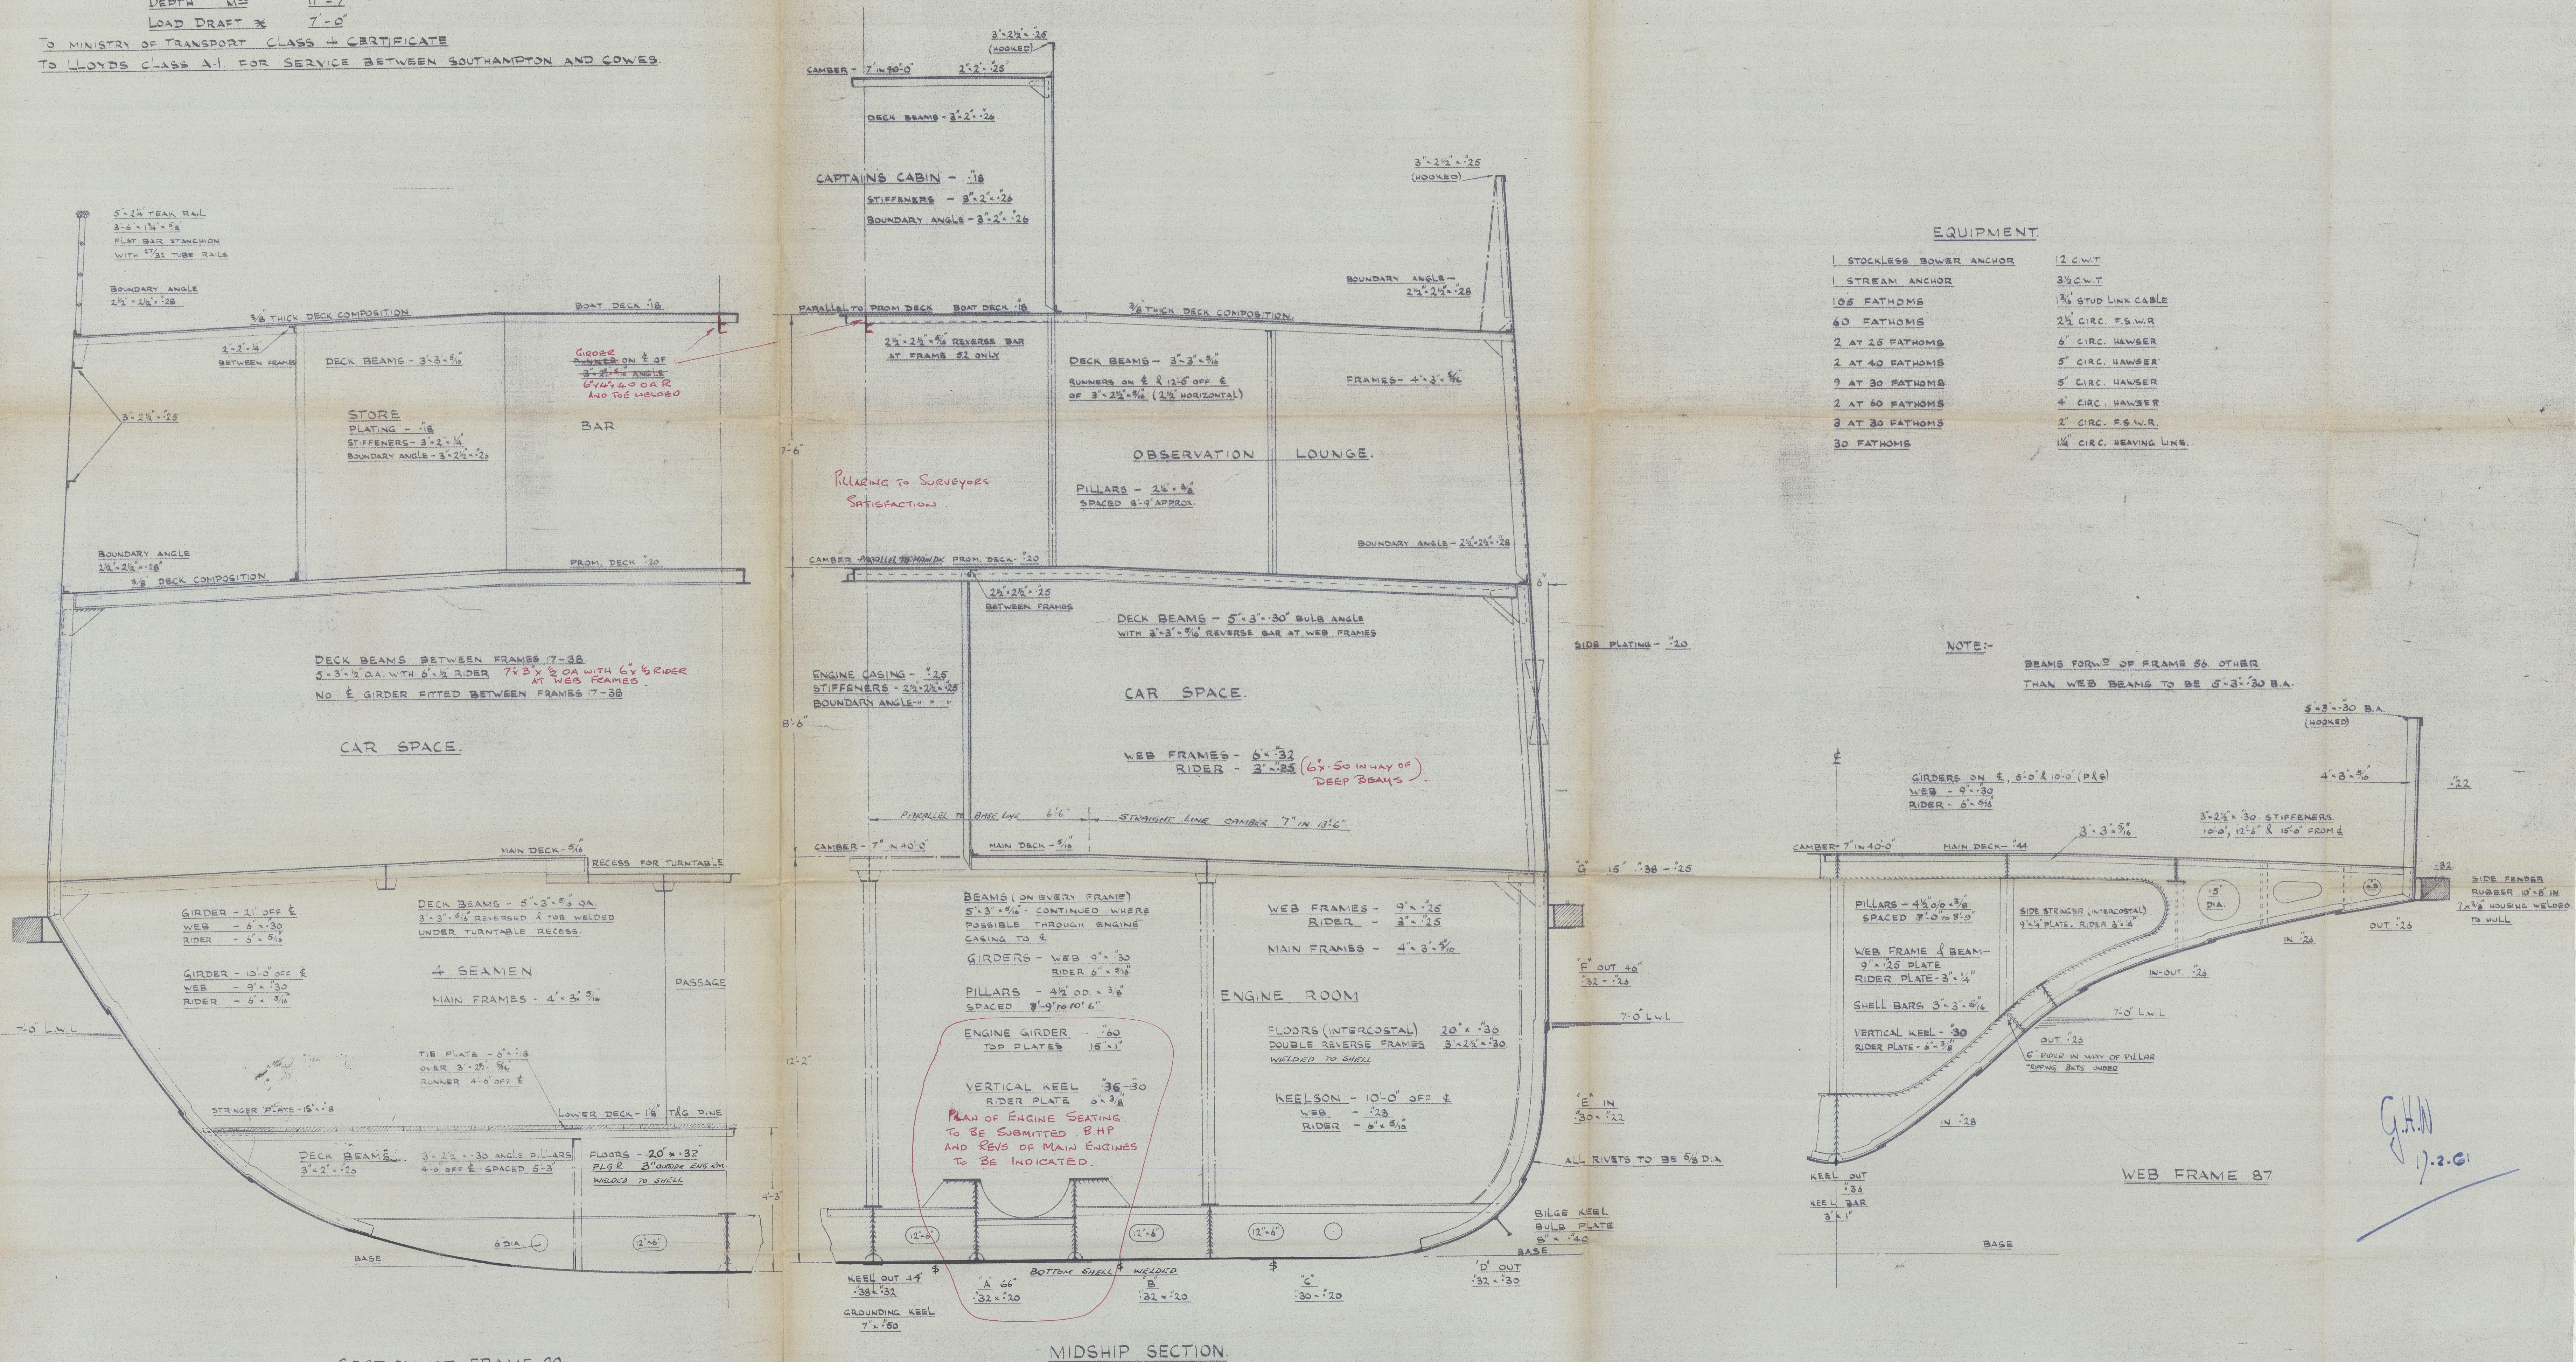

G.H.N.  
1.2.61



N/N LE GOBELET D'ARGENT

NAME	EX OSBORNE CASTLE
SOUTHAMPTON REPORT No.	27563
PLAN	MIDSHIP SECTION
BUILDERS	L I. THORNYCROFT
YARD No.	4196.

M.M.  
12695



© 2021

Lloyd's Register  
Foundation

012694-012698-0045