



DETAIL OF THE PROTECTIVE ZINC PL. (1/2)

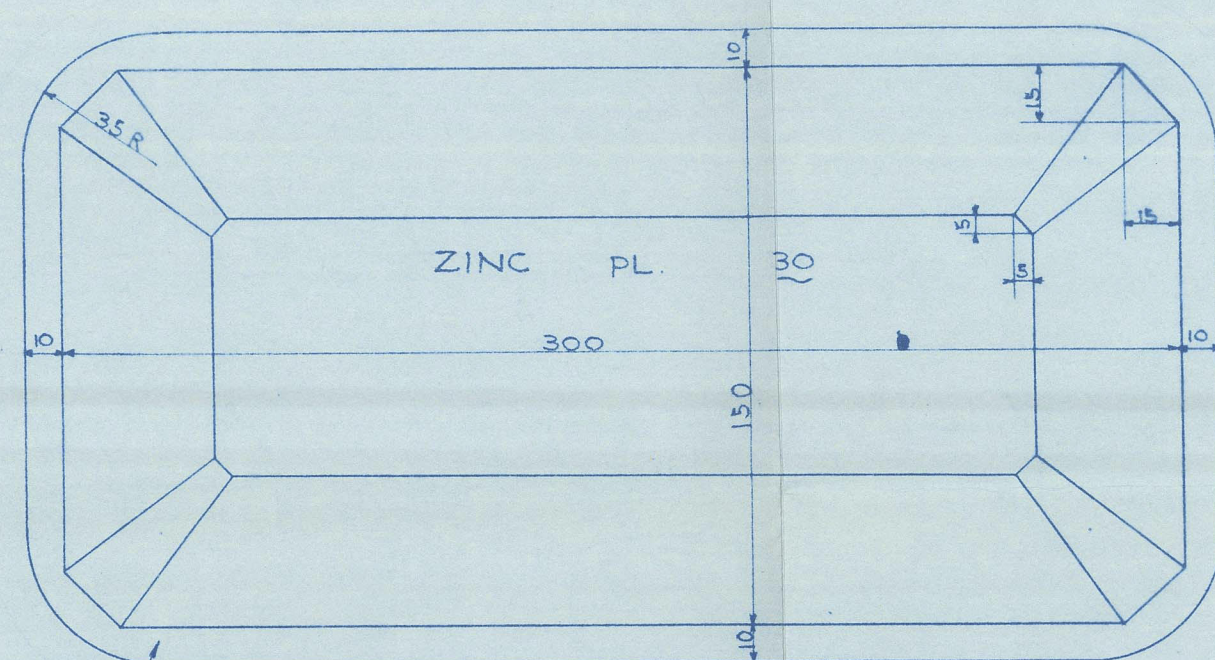


MATERIAL & WEIGHT
MATERIAL CAST STEEL (SC41)
APPROX. WT. 26.5 TONS


F.O. SECTION

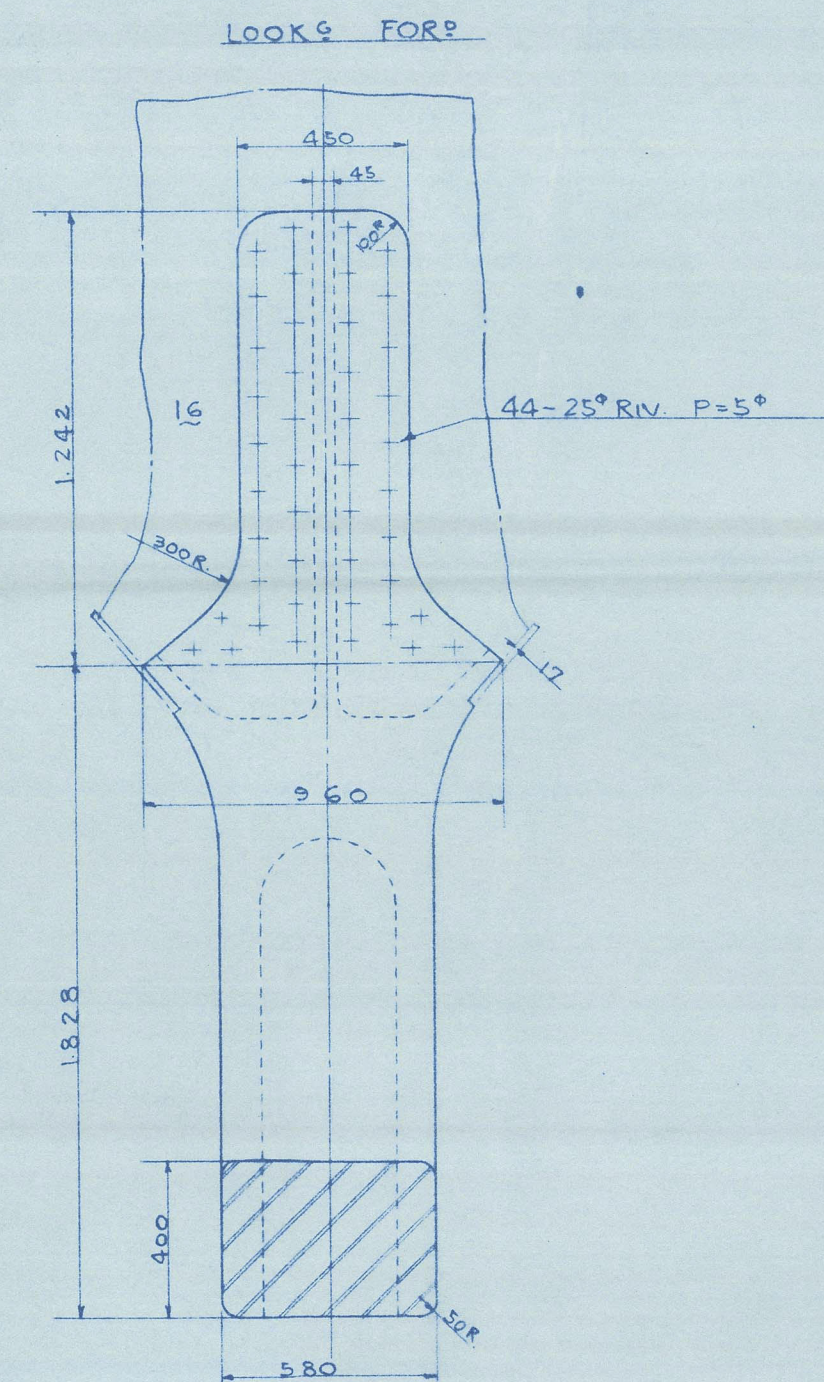


TOP PLAN

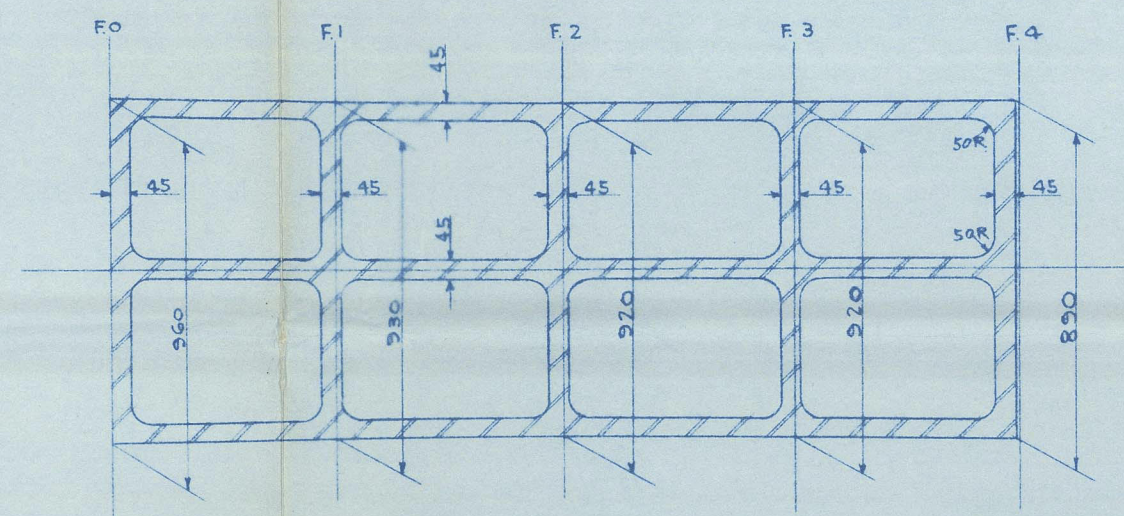


F.2 SECTION

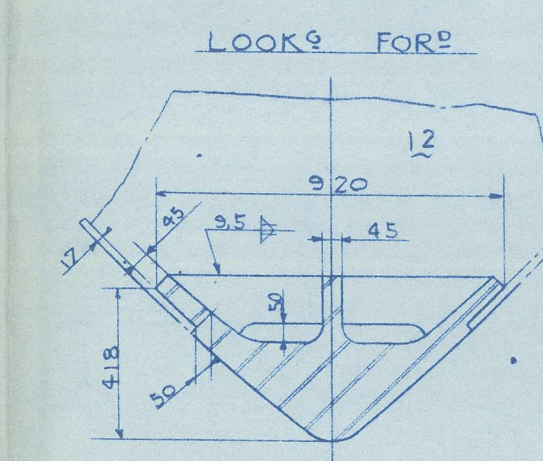


F.4 SECTION

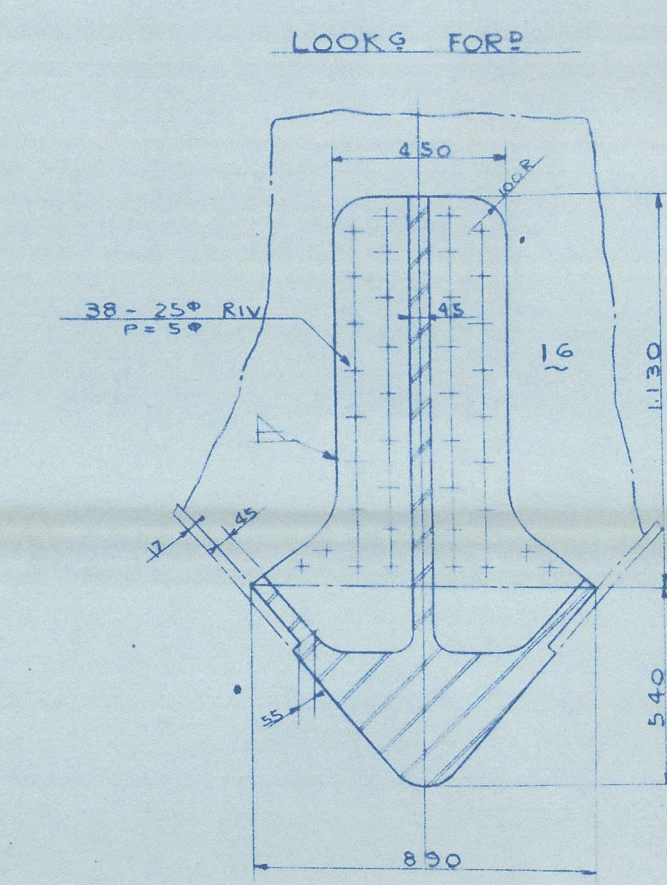


F.1 SECTION

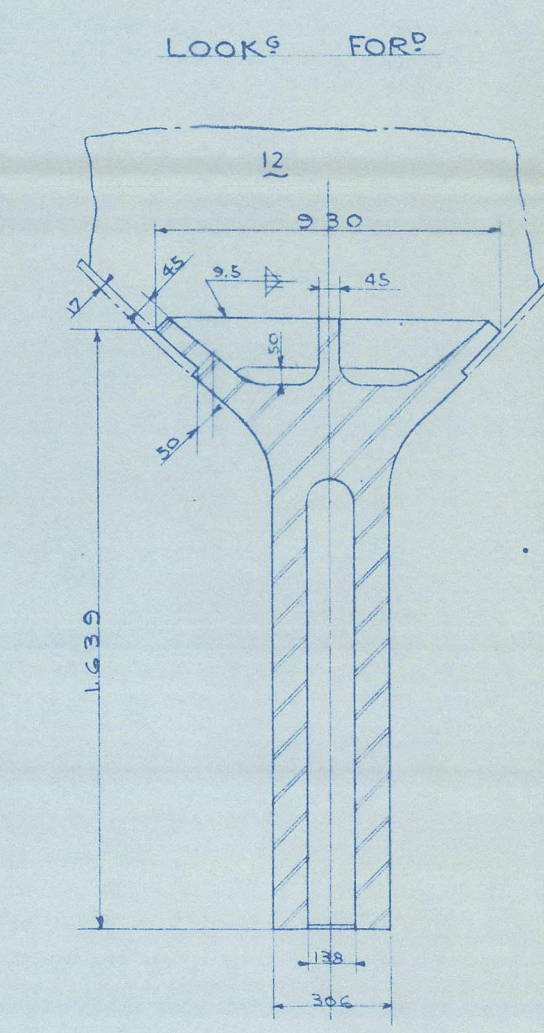


F.3 SECTION

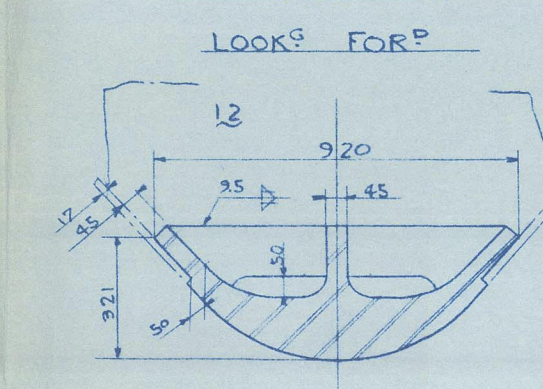


F.4 SECTION

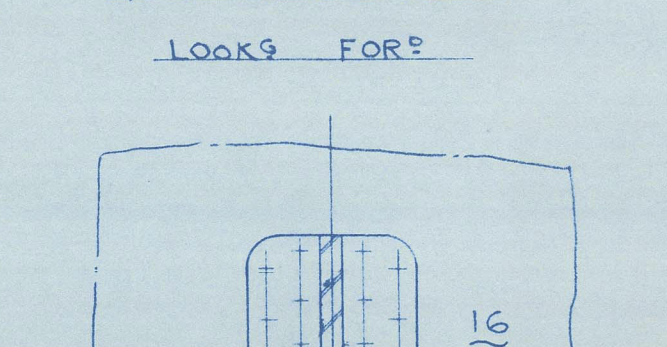


SECTION (1/2)

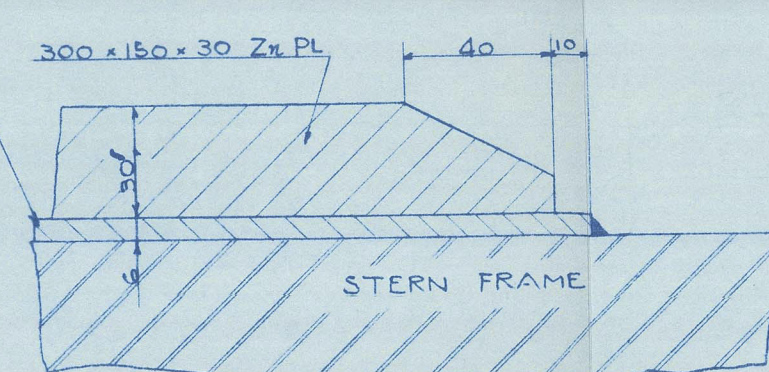


DETAIL OF TACK WELD (1/2)

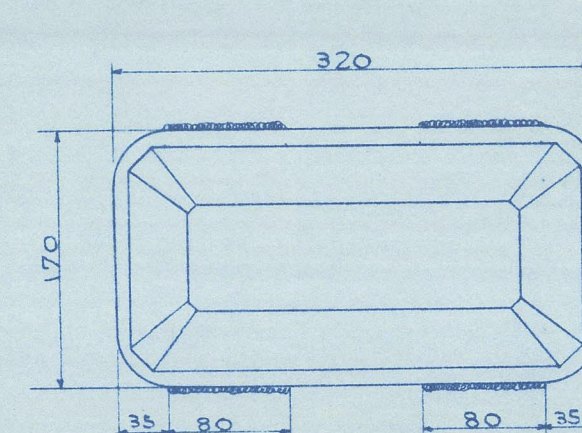


DETAIL OF NECK BEARING (1/4)

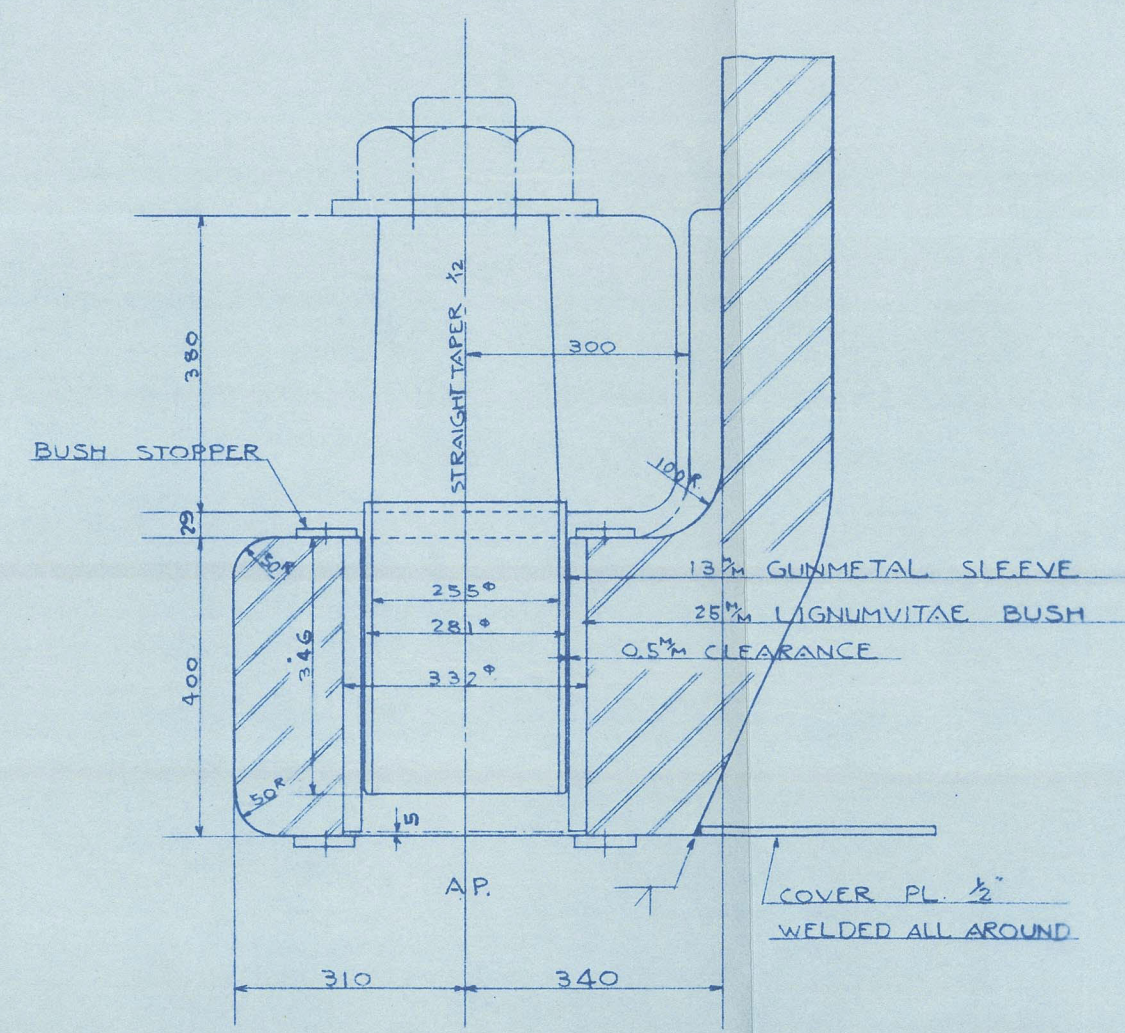


SECTION AT 6" W.L.

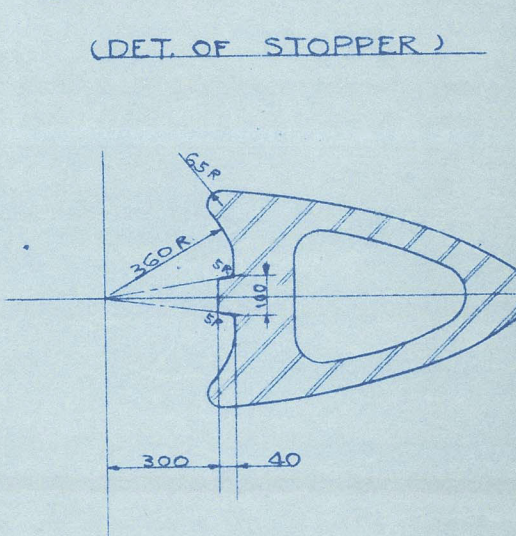

SECTION AT 6.400 W.L.

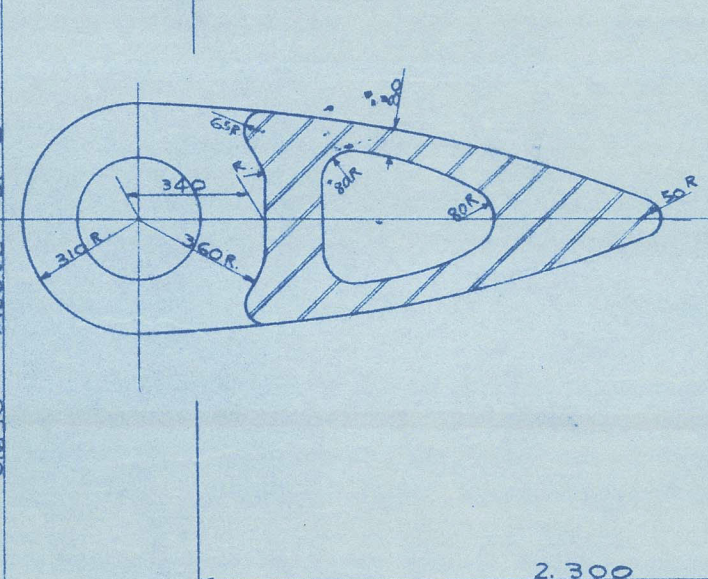


SECTION OF NECK GUDGEON

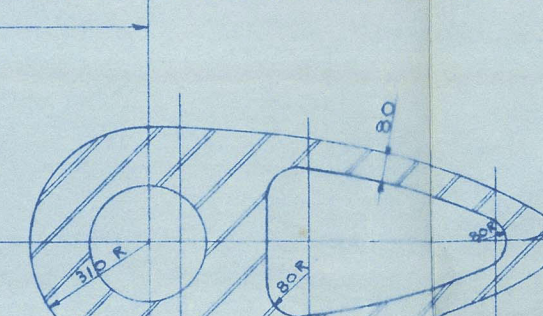


SECTIONS OF SHOE & SOLE PIECE

LOOKING FORWARD


DETAIL A (1/2)

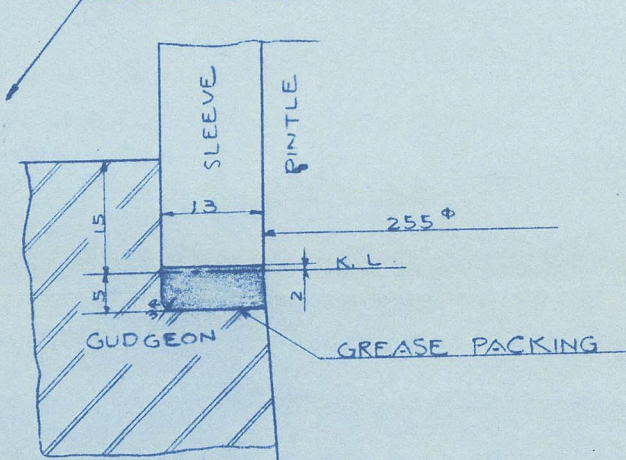


DETAIL OF BOTTOM BEARING (1/4)

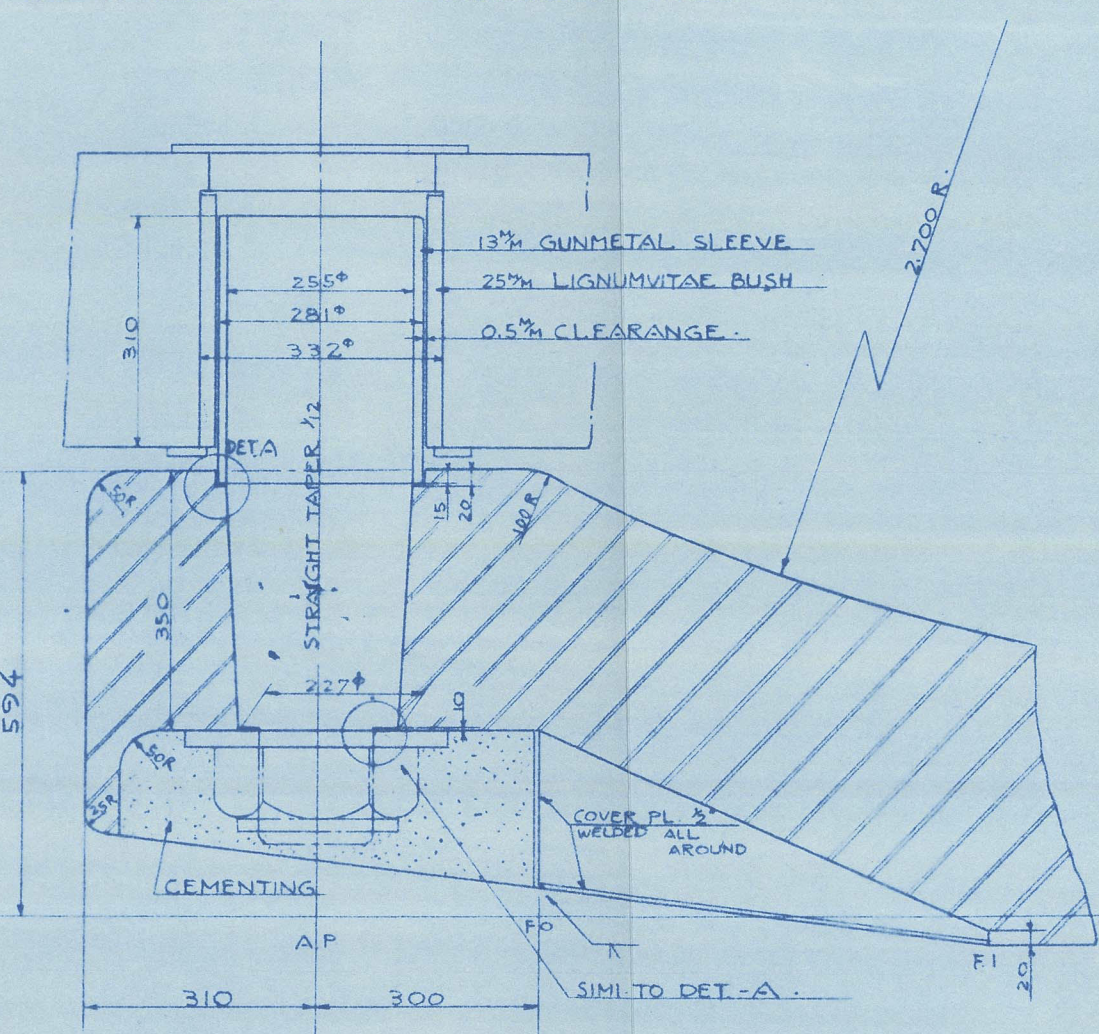


F.5

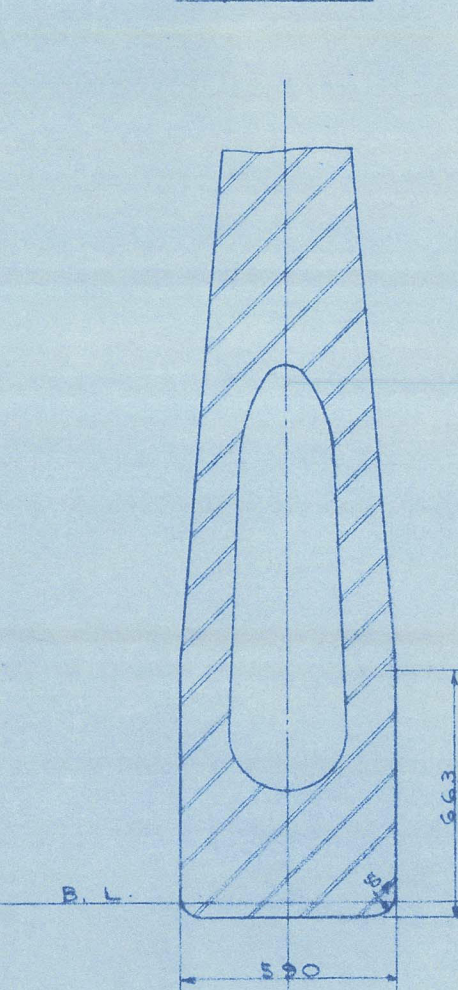


F.6

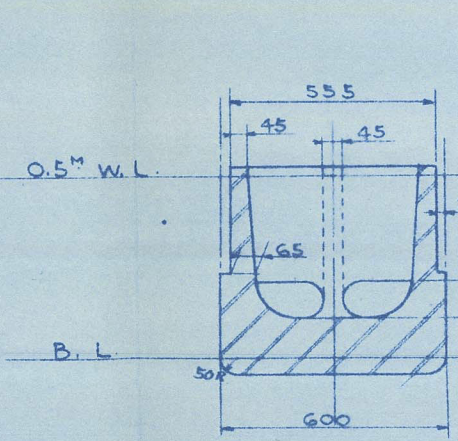


F.7

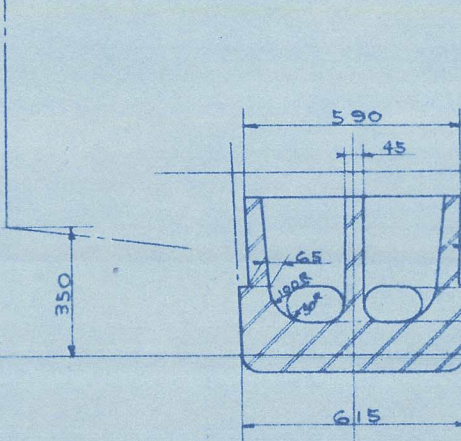


F.8

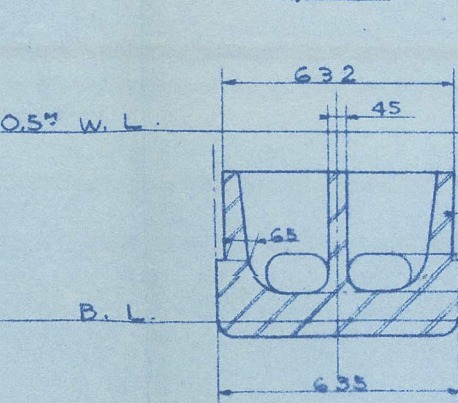

F.9

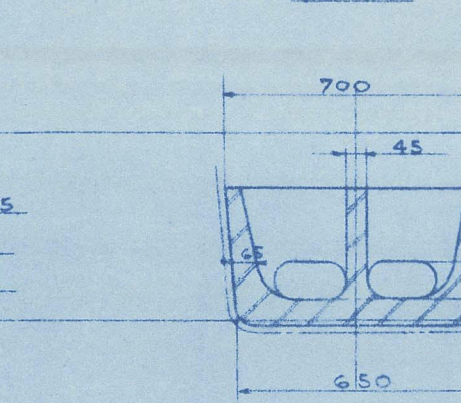

TOP PLAN

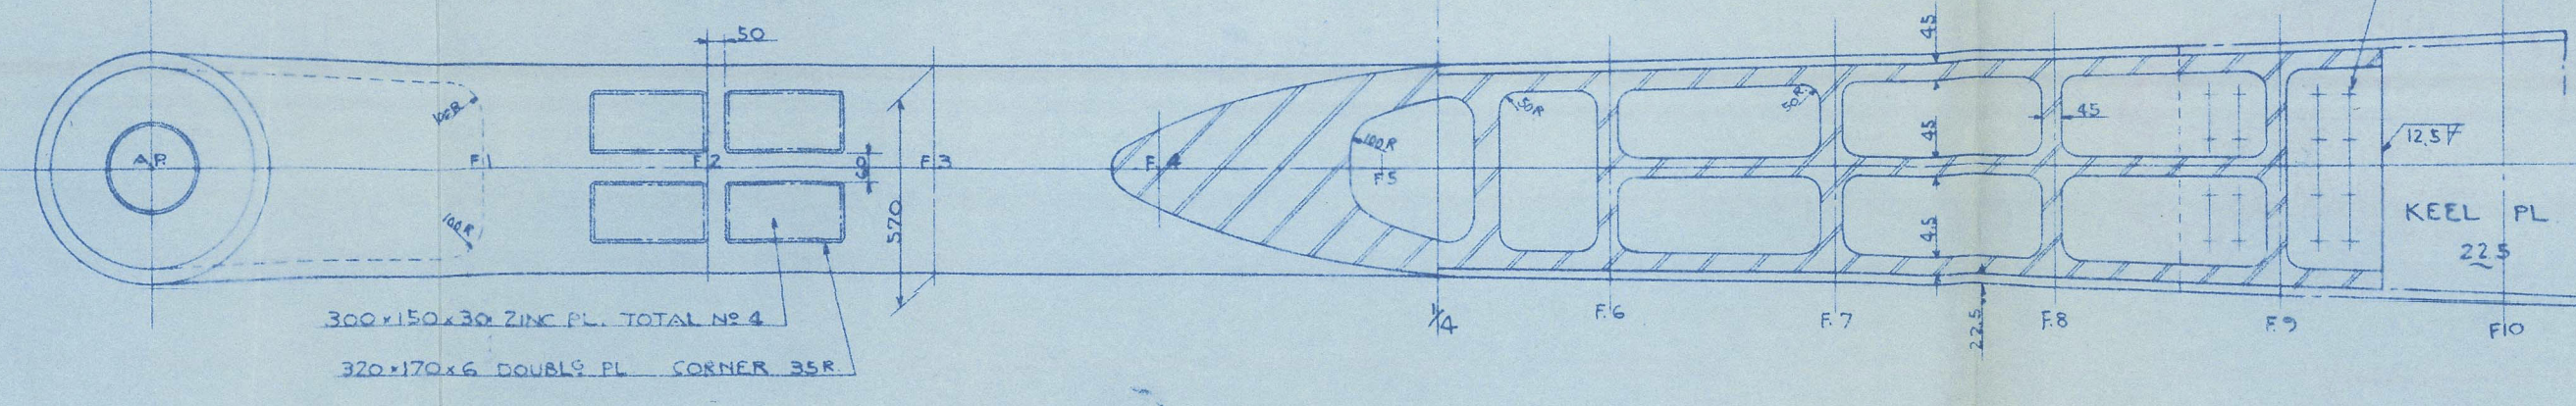

図面名称	訂正
1. 2. 訂正

DAIDO KAIUN
KOTEI MARU

STERN FRAME

(FINISHED PLAN)

DIMENSION 1400 x 194 x 12.2

SCALE 1/10 CLASS L.R.

HULL DESIGNING SECTION
SHIP DESIGNING DEPARTMENT
NABASAKI WORKS

CHEF OF DEPT. *White*

HEAD *White*

CHECKED *White*

DRAWN *White*

DATE *1499* REG. NO. *1499*

SHIP NO. *1499*

YON NO. *H-202021*

01711-01715 0059

Lloyd's Register
Foundation

KOTEI MARU. ★




Stemframe

SHIMONOSEKI

RPT. NO. FE1005

DATED. _____

RECORDS DEPT.
LONDON.

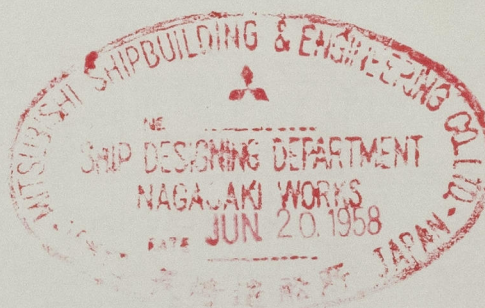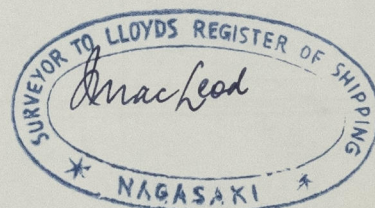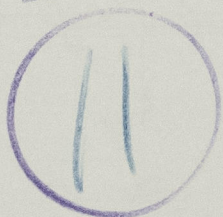

© 2021

Lloyd's Register
Foundation

012711-012715-0059