


SCALE:- $\frac{1}{2}$ " TO 1 FOOT.

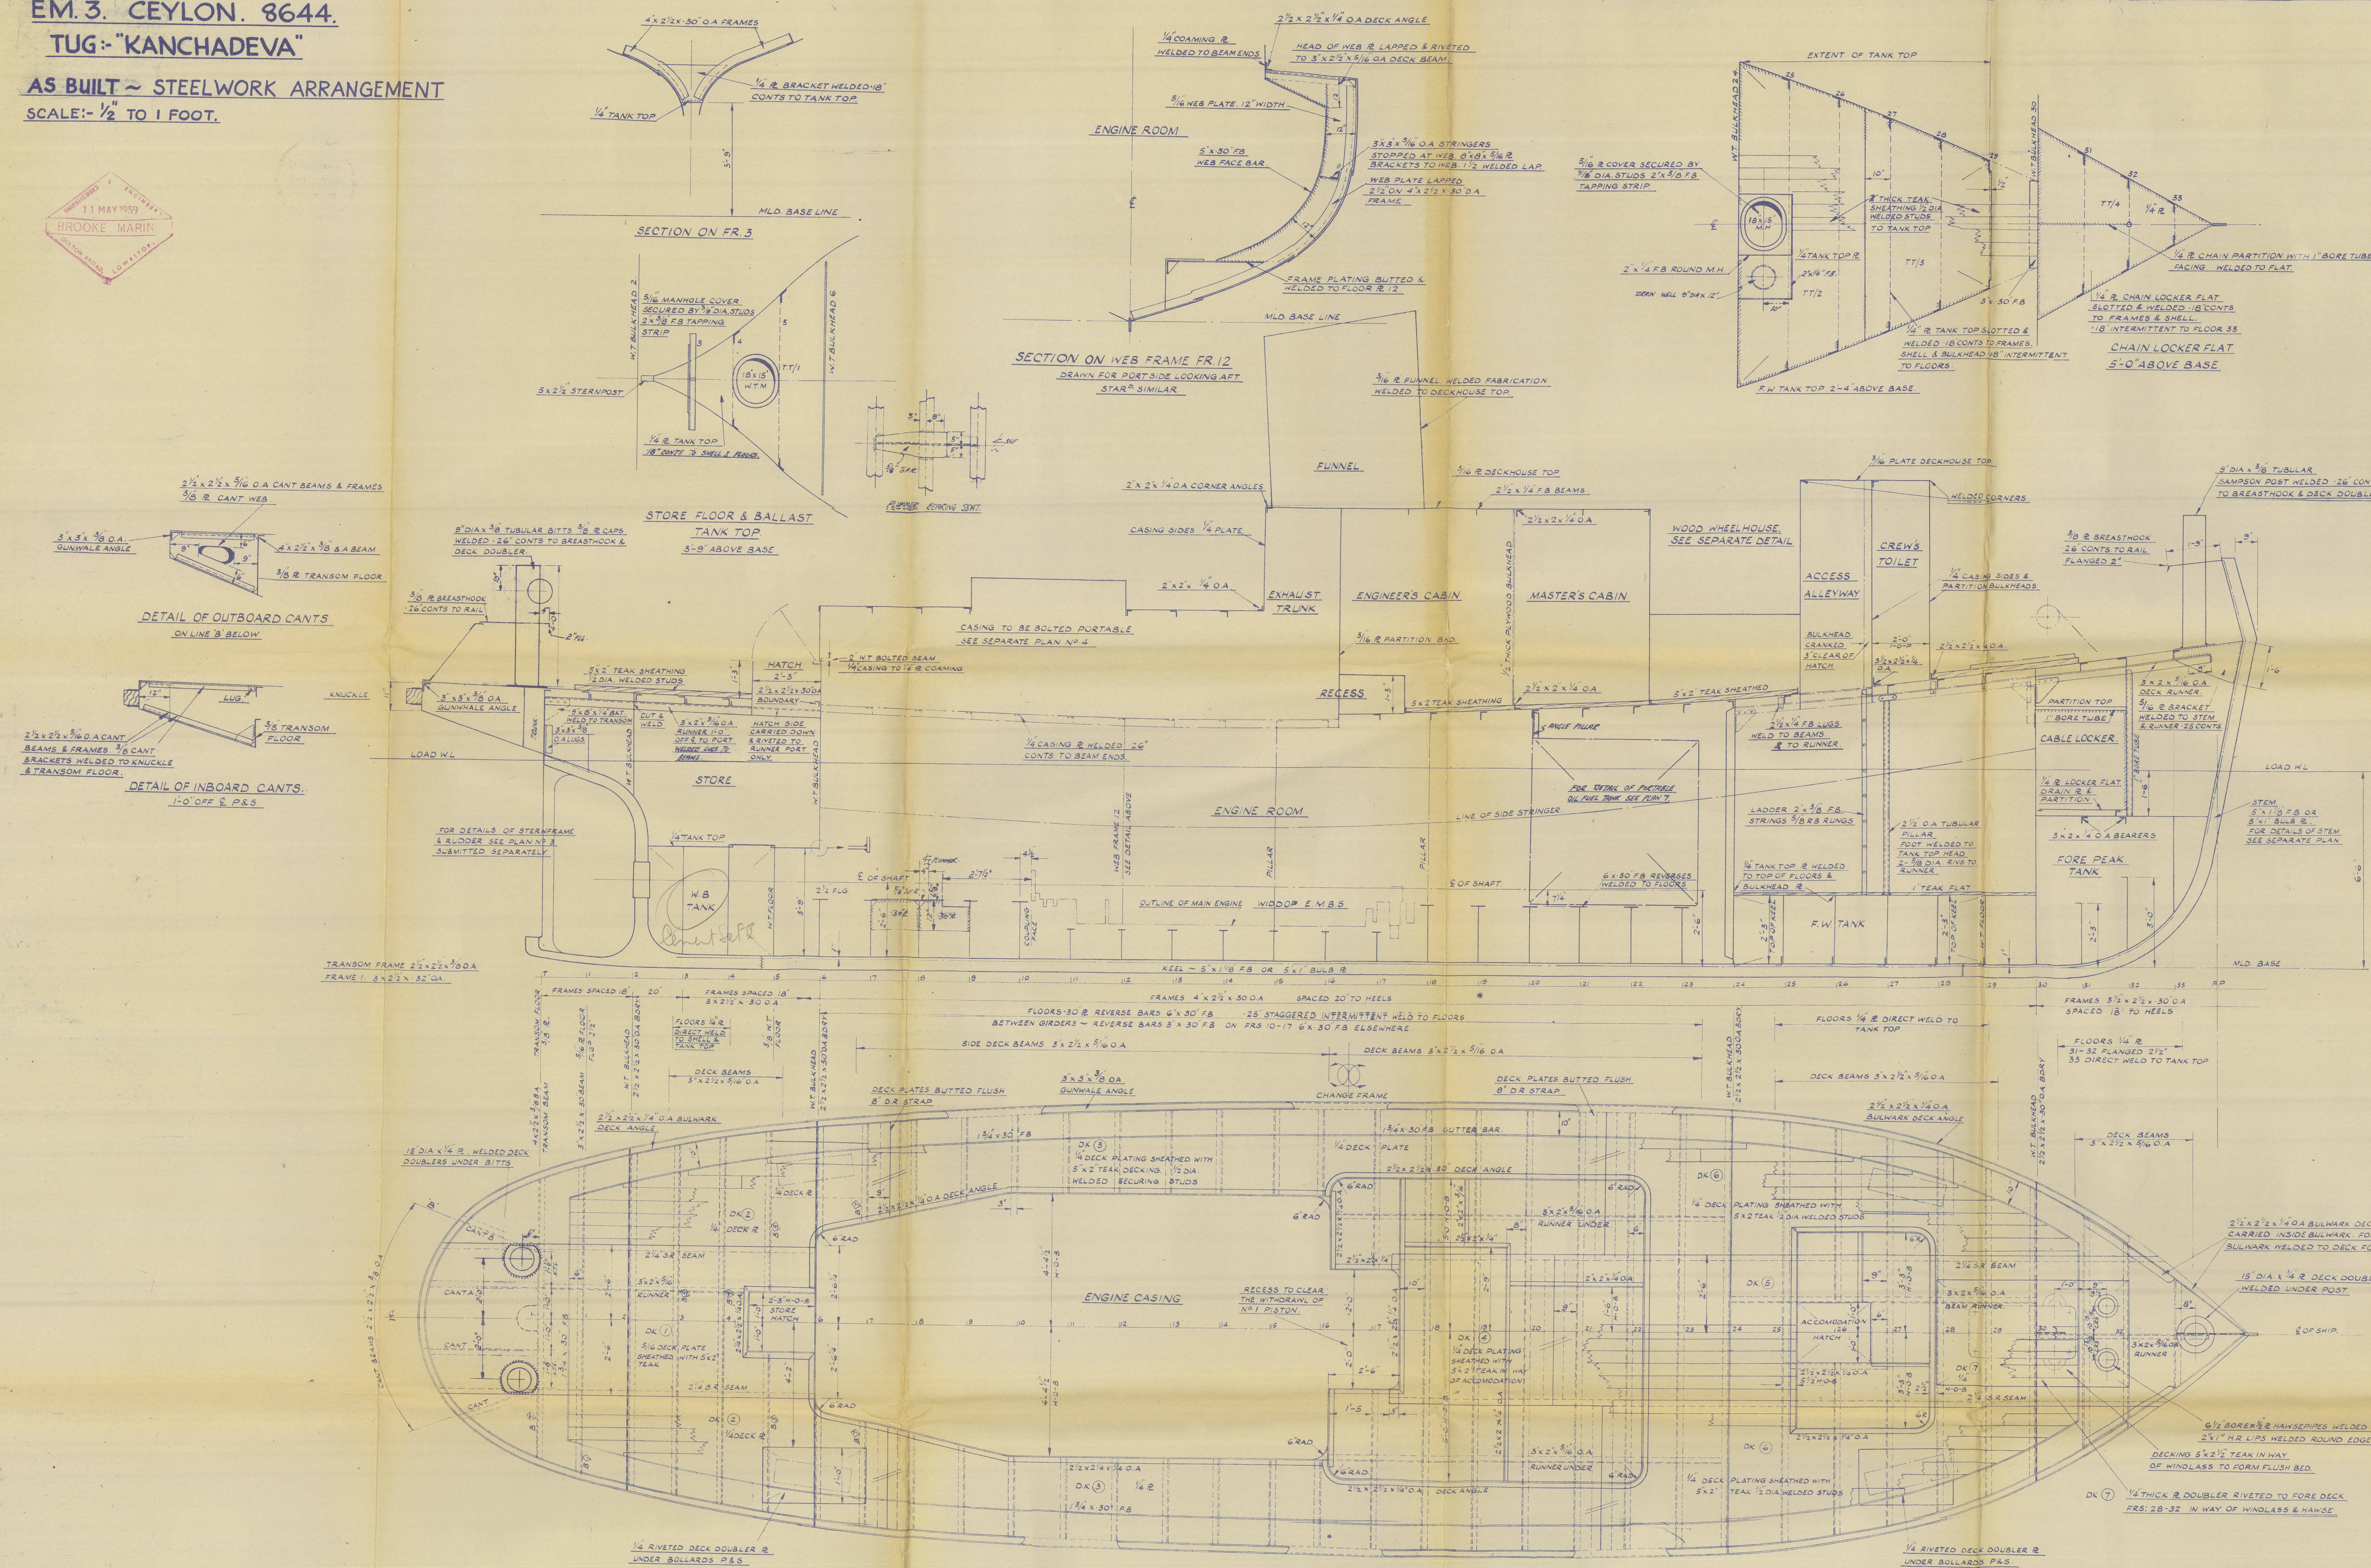


KANCHADEVA

STEELWORK. ARRANGEMENT.

(AS. BUILT)

RECORDS DEPT.
LONDON.

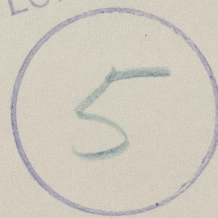

© 2021

Lloyd's Register
Foundation

012711-012715-0245

BROOKE MARINE LTD - YARD N°269

M.T. KANCHADEVA

STRUCTURAL SECTIONS - (AS FITTED)

Stelwork

IPSWICH RPT N° 140122

012411-012415-0245



© 2021

Lloyd's Register
Foundation