


1.1 06/1957

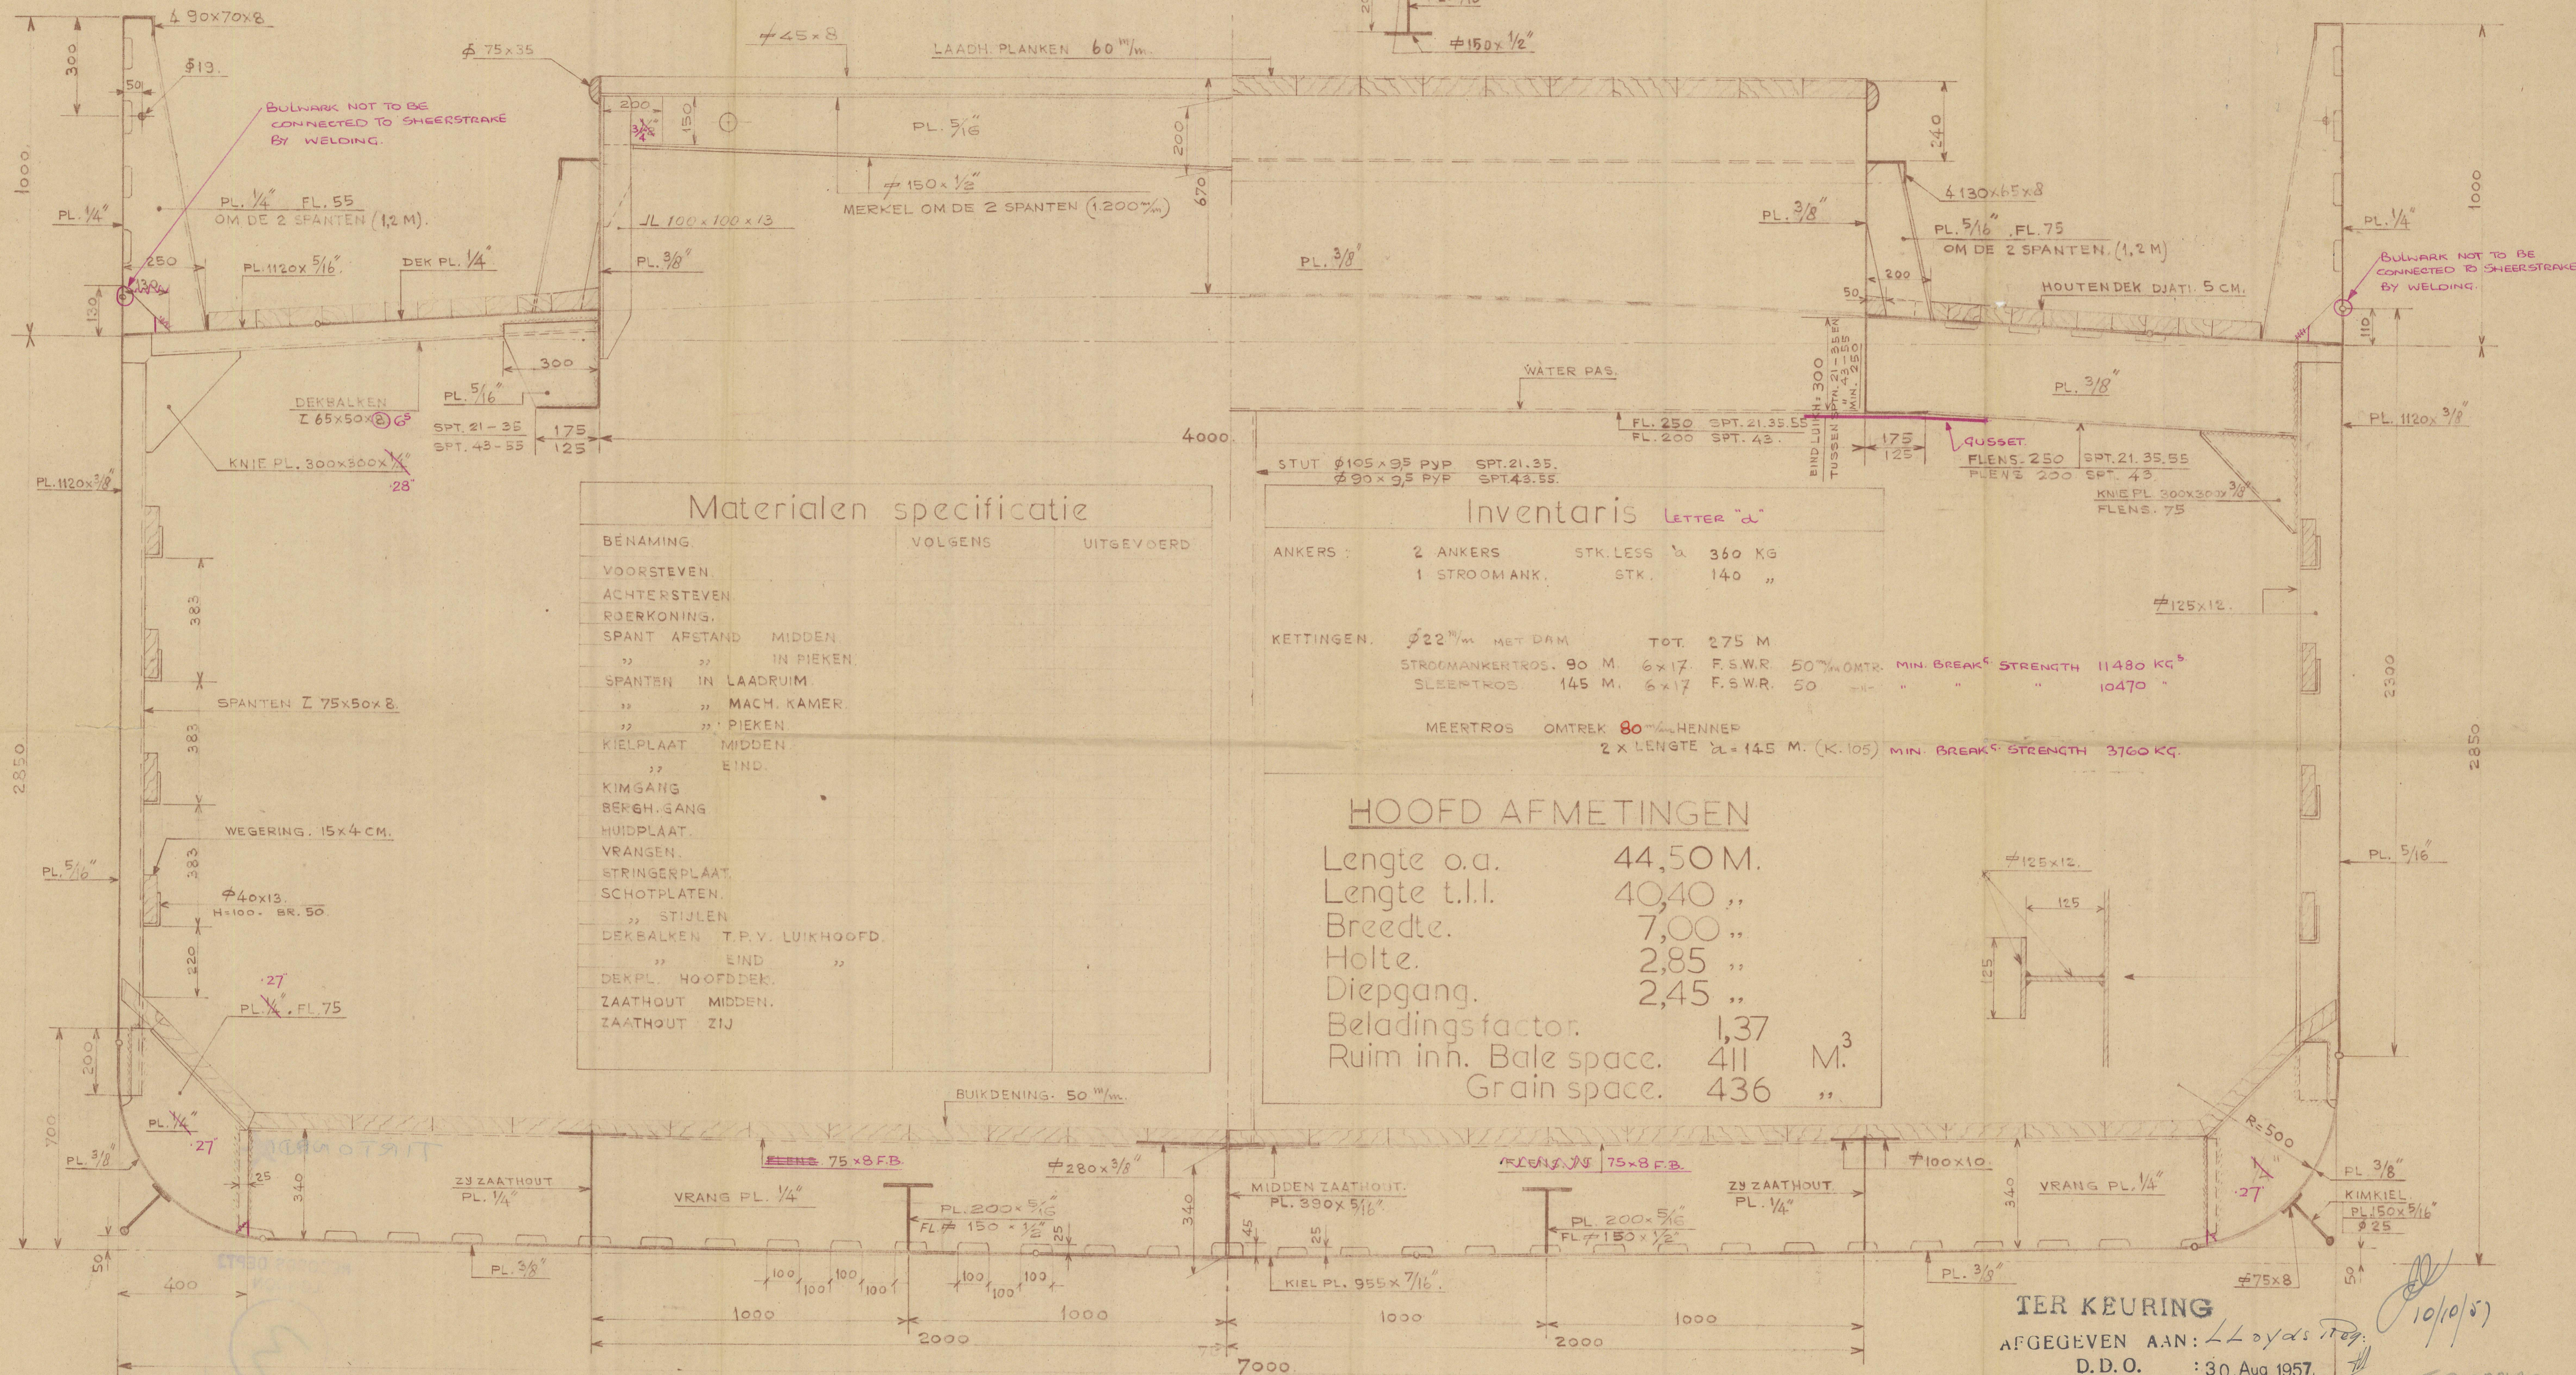

TER KEURING

AFGEGEVEN AAN: Lloyd's Reg.  
D.D.O. : 30. Aug 1957.

CLASS 100A.1 "FOR SERVICE IN INDOONESIAN ARCHIPELAGO"


THE SCANTLING AS SHOWN AND AMENDED ARE  
SUITABLE FOR A SUMMER DRAUGHT MEASURED FROM  
TOP OF KEEL OF 2.45 M.

ARTAL	POSAR	BENAMING	AFMETING	MAT.	OPM.
		VEREENIGDE PROUWEN VEREN N.V.			
		GROOTSPANT			
		300TONS COASTER			
		ORDER NR: BN. 448	SERIE		
		SCHAAL: 1:10	DATUM		
		GEALQ: 19-8-57	GEALQ: 24-8-57		
		GEZIEN: 10/10/57			

TIRTOWADI



RECORDS DEPT  
LONDON

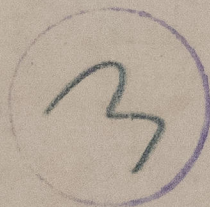

*Midship Section*



© 2021

Lloyd's Register  
Foundation

012744-012751-0038