


Lloyd's Register of Shipping.

SURVEYS FOR FREEBOARD.

(CONDITIONS OF ASSIGNMENT.)

Ship's Name "SILVER DRAGON" Port of Survey Hong Kong.
 Official Number _____ Surveyor's Signature James A. Anderson.
 Nationality and Port of Registry Korean Inchon Date of Survey 17th December, 1956.

Disposition and dimensions of superstructures, trunks, deckhouses and machinery casings to be inserted in the diagrams and tabular statement:—

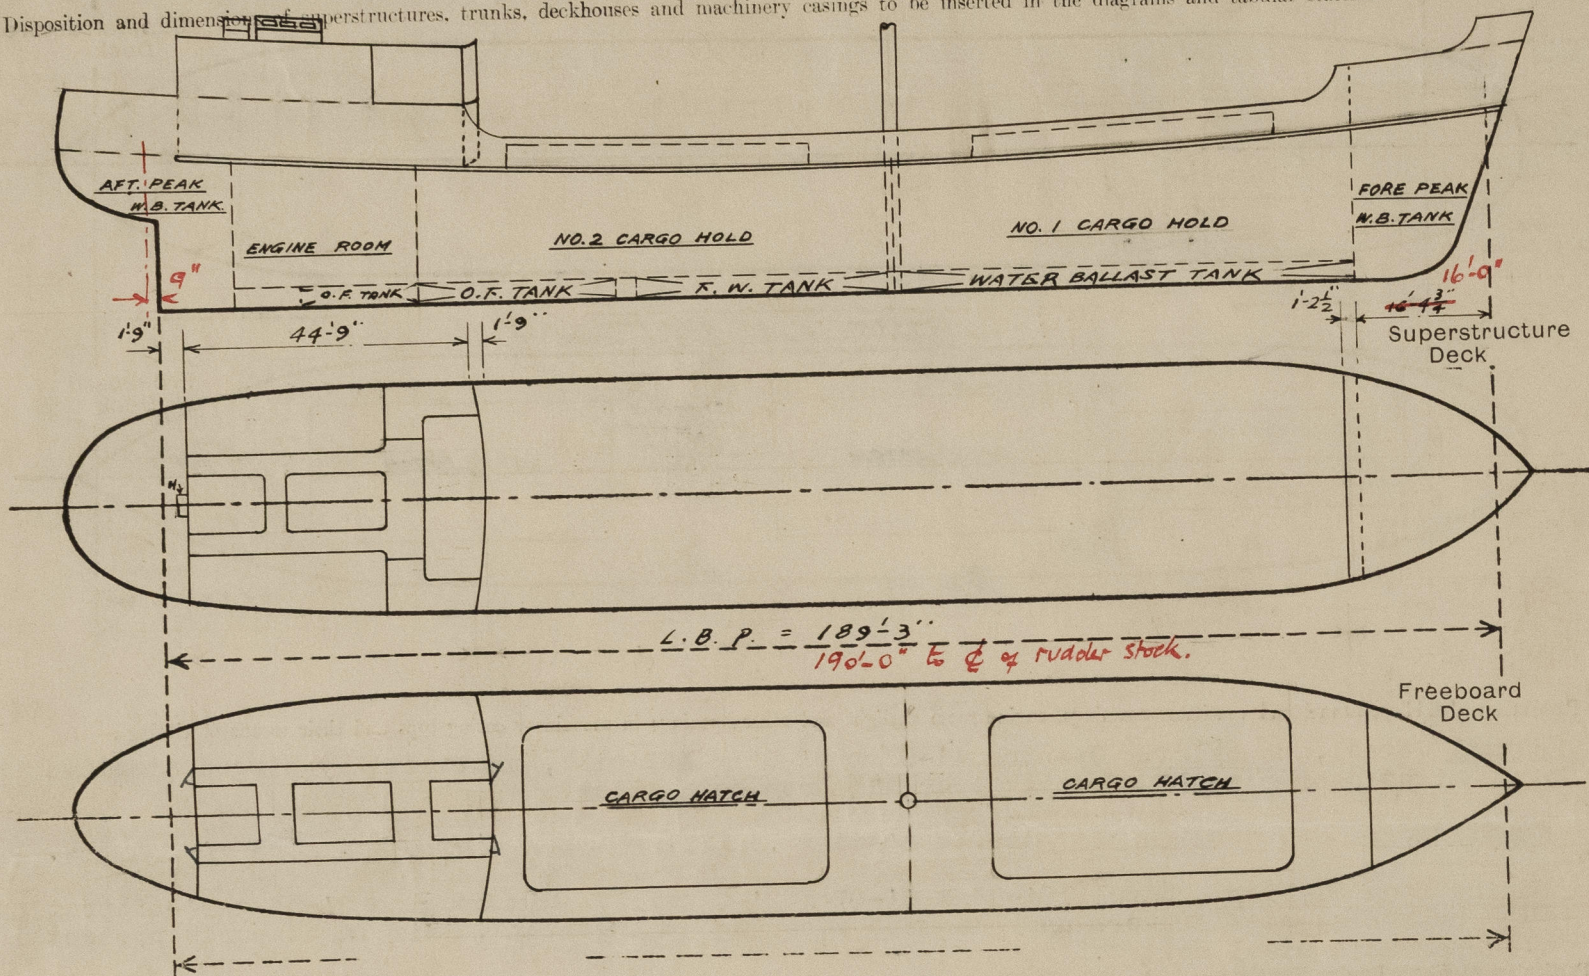

Particulars of Superstructures, Trunks, Casings, Deckhouses.


	Coaming	Plating	Stiffeners	Spacing	End Attachments of Stiffeners	Size of Openings	Height of Sills	Height of Casings
Poop Bulkhead30 ✓	.30 ✓	Inv. Angle 5"x3"x.40	2'-3" ✓	Welded top & bottom	4'-0"x2'-0"	2'-0" ✓	7'-3" ✓
Raised Quarter Deck Bulkhead ...								
Bridge, After Bulkhead ...								
Bridge, Forward Bulkhead ...								
Forecastle Bulkhead25 ✓	.25 ✓	Inv. Angle 3"x3"x.30	2'-6" ✓	Brackets top & bottom	2'-6"x2'-0" 4'-0"x2'-0"	3'-6" ✓ 2'-0" ✓	6'-6" ✓
Trunk, Aft ...								
Trunk, Forward ...								
Exposed Machinery Casings on Freeboard or Raised Quarter Decks ...								
Exposed Machinery Casings on Superstructure Decks ...								
Machinery Casings within Superstructures fitted with Class I Closing Appliances25 ✓	.25 ✓	Inv. Angle 3"x2 1/2" x.30	2'-6" ✓	-	5'-0"x2'-0"	1'-0" ✓	7'-3" ✓
Deckhouses on Flush Deck Ships ...								

Particulars of Closing Appliances (state if capable of being manipulated from both sides).

Poop Bulkhead ...	Hinged steel weathertight doors, strongly framed and capable of being operated from both sides. ✓
Raised Quarter Deck Bulkhead ...	
Bridge, After Bulkhead ...	
Bridge, Forward Bulkhead ...	
Forecastle Bulkhead ...	Light aperture hinged steel cover with adequate securing arrangements. ✓
Exposed Machinery Casings on Freeboard or Raised Quarter Decks ...	Hinged steel weathertight doors, strongly framed and capable of being operated from both sides. ✓
Exposed Machinery Casings on Superstructure Decks ...	
Machinery Casings within Superstructures fitted with Class I Closing Appliances ...	Hinged steel weathertight doors capable of being operated from both sides. ✓
Deckhouses on Flush Deck Ships ...	

Silver Dragon.

Particulars of Gangway Cargo and Coaling Ports :— Nil.

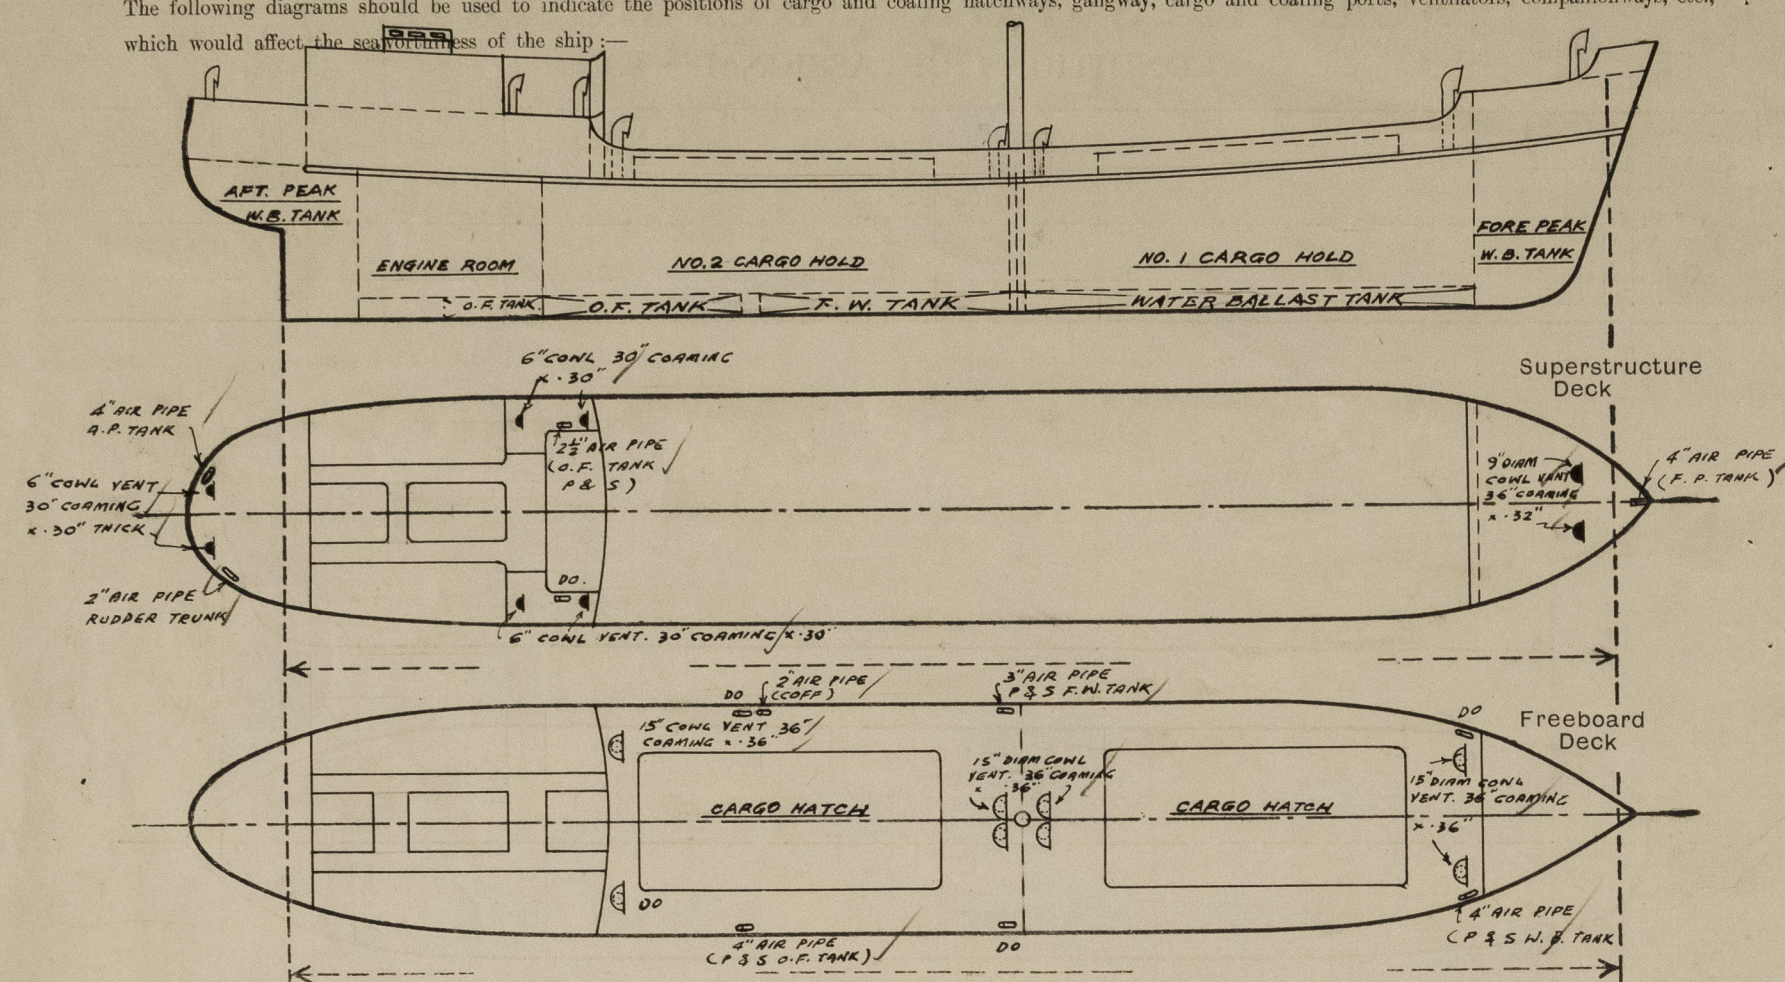

Particulars of Scuppers and Sanitary Discharge Pipes — Poop & Forecastle drained through 2" dia. holes in bulkhead (p & s) fitted with screwed brass plugs permanently attached to bulkheads.

Sanitary Discharge Pipes in Poop Space 1 p. 1 s. 4" dia. fitted with bronze S.N.R.V. at shell with extension spindle to deck and indicator.

Sanitary Discharge Pipes from Boat Deck ^{POOP} Two starbd side 4" dia. fitted with bronze non-return valve at shell.

Galley on Boat Deck 2" dia. fitted with bronze non-return valve at shell.

Lavatories on Boat Deck 1 p. ls. 2" dia. fitted with bronze non-return valves at shell


Main Deck Scuppers Six 3 p. 3 s. 4" dia. pipes through stringer and sheer strakes.


Particulars of Side Scuttles:— None below freeboard deck.

Vertical distance of Sill of lowest Side Scuttle above top of keel.....—

Particulars of Guard Rails:— Forecastle, Poop & Boat Decks. Three tier rails, 3'-0" high, stanchions 2 $\frac{1}{2}$ " x 4 $\frac{1}{2}$ "^{dia}, spaced 4'-0" apart.

Particulars of Gangways, Lifelines, etc. :- Adequate materials and fittings on board for rigging life lines.

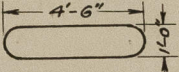Particulars of Freeing Arrangements.						
	Length of Bulwark	Height of Bulwark	Size of Freeing Ports	Number each side	Area each side	Rule area each side
After Wax	46'-9" 125.5'	3'-6"		Two	8.57 sq.ft.	25.4 sq.ft.
Forward Wax	80'-2"	3'-6"	As above	Four	17.14 sq.ft.	
<p>State position of each freeing port { Wax Wax:- from poop bulkhead 8'-6" - 29'-6" - 50'-0" - 65'-9" - 86'-9" - 107'-9" height above deck 7".</p> <p>(F. and A. position and height above deck edge) { Wax Wax Wax:-</p> <p>State whether the freeing ports are fitted with shutters, bars, or rails, and give particulars of such: Two vertical one horizontal bars $\frac{7}{8}$ dia</p> <p>Additional area where sheer is less than standard. -</p>						

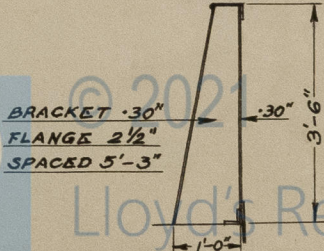

Particulars of Ventilators in exposed positions on freeboard and superstructure decks :—

Freebd Deck Eight coamings 15" dia. x 3'-0" high x .36 fitted with wood plugs & canvas covers.

Forecastle Deck Two coaming 9" dia. x 3'-0" high x .32 fitted with wood plugs & canvas covers.

Poop Deck Six coamings 6" dia. x 2'-6" high x .30 fitted with wood plugs & canvas covers.

Boat Deck Thirteen coamings 6" dia. x 2'-6" high x .30 fitted with wood plugs & canvas covers.

Particulars of Air Pipes in exposed positions on freeboard, raised quarter, or superstructure decks:—

particulars of Air Pipes in exposed positions on freeboard, raised quarter, or superstructure decks:—
Freebd Deck Two 4" dia. to No.1 double bottom tank opgs. 3'-0" above deck } Fitted with
 Two 3" dia. to fresh water double bottom tanks opgs. 3'-0" above deck } wood plugs &
 One 2" dia. to double bottom cofferdam, opg. 3'-0" above deck. } canvas covers.
 Two 4" dia. to oil fuel double bottom tanks opgs. 3'-0" above deck fitted with
 gauze wire and canvas covers.

Forecastle Deck One 4" dia. to fore peak tank opg. 2'-6" above deck fitted with wood plug and canvas cover.

Poop Deck Two 2½" dia. to oil fuel double bottom tanks opg. 2'-6" above deck fitted with gauze wire and canvas cover ✓
One 4" dia. to after peak tank opg. 2'-6" above deck fitted with wood plug and canvas cover ✓

PARTICULARS OF PROTECTION TO OPENINGS, ETC.

		HATCHWAYS ON FREEBOARD AND SUPERSTRUCTURE DECKS.							
		Freebd Deck		Poop Deck					
		Standard	Standard						
Description of Hatchway ...		Cargo	Cargo		Access				
Dimensions of Hatchway ...		44'-0"	44'-0"		2'-3"				
		x 20'-0"	x 20'-0"		x 1'-4"				
COAMINGS	Height above Deck ...	2'-0"	2'-0"		1'-6"				
	Thickness { Sides43	.43		.30				
	{ Ends ...								
	Stiffeners ...	4 5"x3"x.32	4 5"x3"x.32		-				
	Brackets, Stays ...	4 4"x2 1/2"x.30	4 4"x2 1/2"x.30		-				
HATCH BEAMS	Number ...	6	6						
	Spacing ...	6'-3 1/2"	6'-3 1/2"						
	Scantling and Sketch ...								
	Bearing Surface ...	3 1/2" x 1 1/2"							
FORE AND AFTERS	Number ...								
	Spacing ...								
	Unsupported Lengths ...								
	Scantling* and Sketch ...								
	Bearing Surface ...								
HATCH COVERS	Material ...	O.P.			Steel				
	Thickness ...	3 1/4"			.30				
	How fitted ...	Fore & Aft			Hinged				
	Bearing Surface ...	4"			Watertight				
Spacing of Cleats ...		2'-0"			Six				
Number of Tarpaulins...		Two			eyebolts & toggles				
<p>*Are wood fore and afters steel shod at all bearing surfaces? All wood hatch covers fitted with G.I. bands at ends.</p> <p>Are battens and wedges efficient and in good condition? Yes.</p> <p>Are tarpaulins in good condition and in accordance with rule requirements? Yes.</p> <p>Are lashings provided in accordance with rule requirements? Yes 2 1/2" x 5/16" flat bars with draw bolts.</p>									

Particulars of any special features:—



© 2021

Lloyd's Register Foundation