

PL. 3702 | C^{de}

SOCIÉTÉ DES ATELIERS

TERRIN

DE L'AFRIQUE DU NORID

BRITISH HONOUR

Arbre vilebrequin

Relevé des cassures

Crankshaft fracture.
Alg rept No. 1968 A.

012744-012761-0242



eché

1/10

Alger le 14.10.52

Approuve

Reference

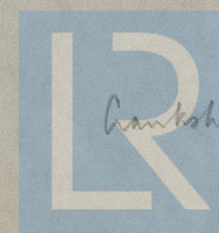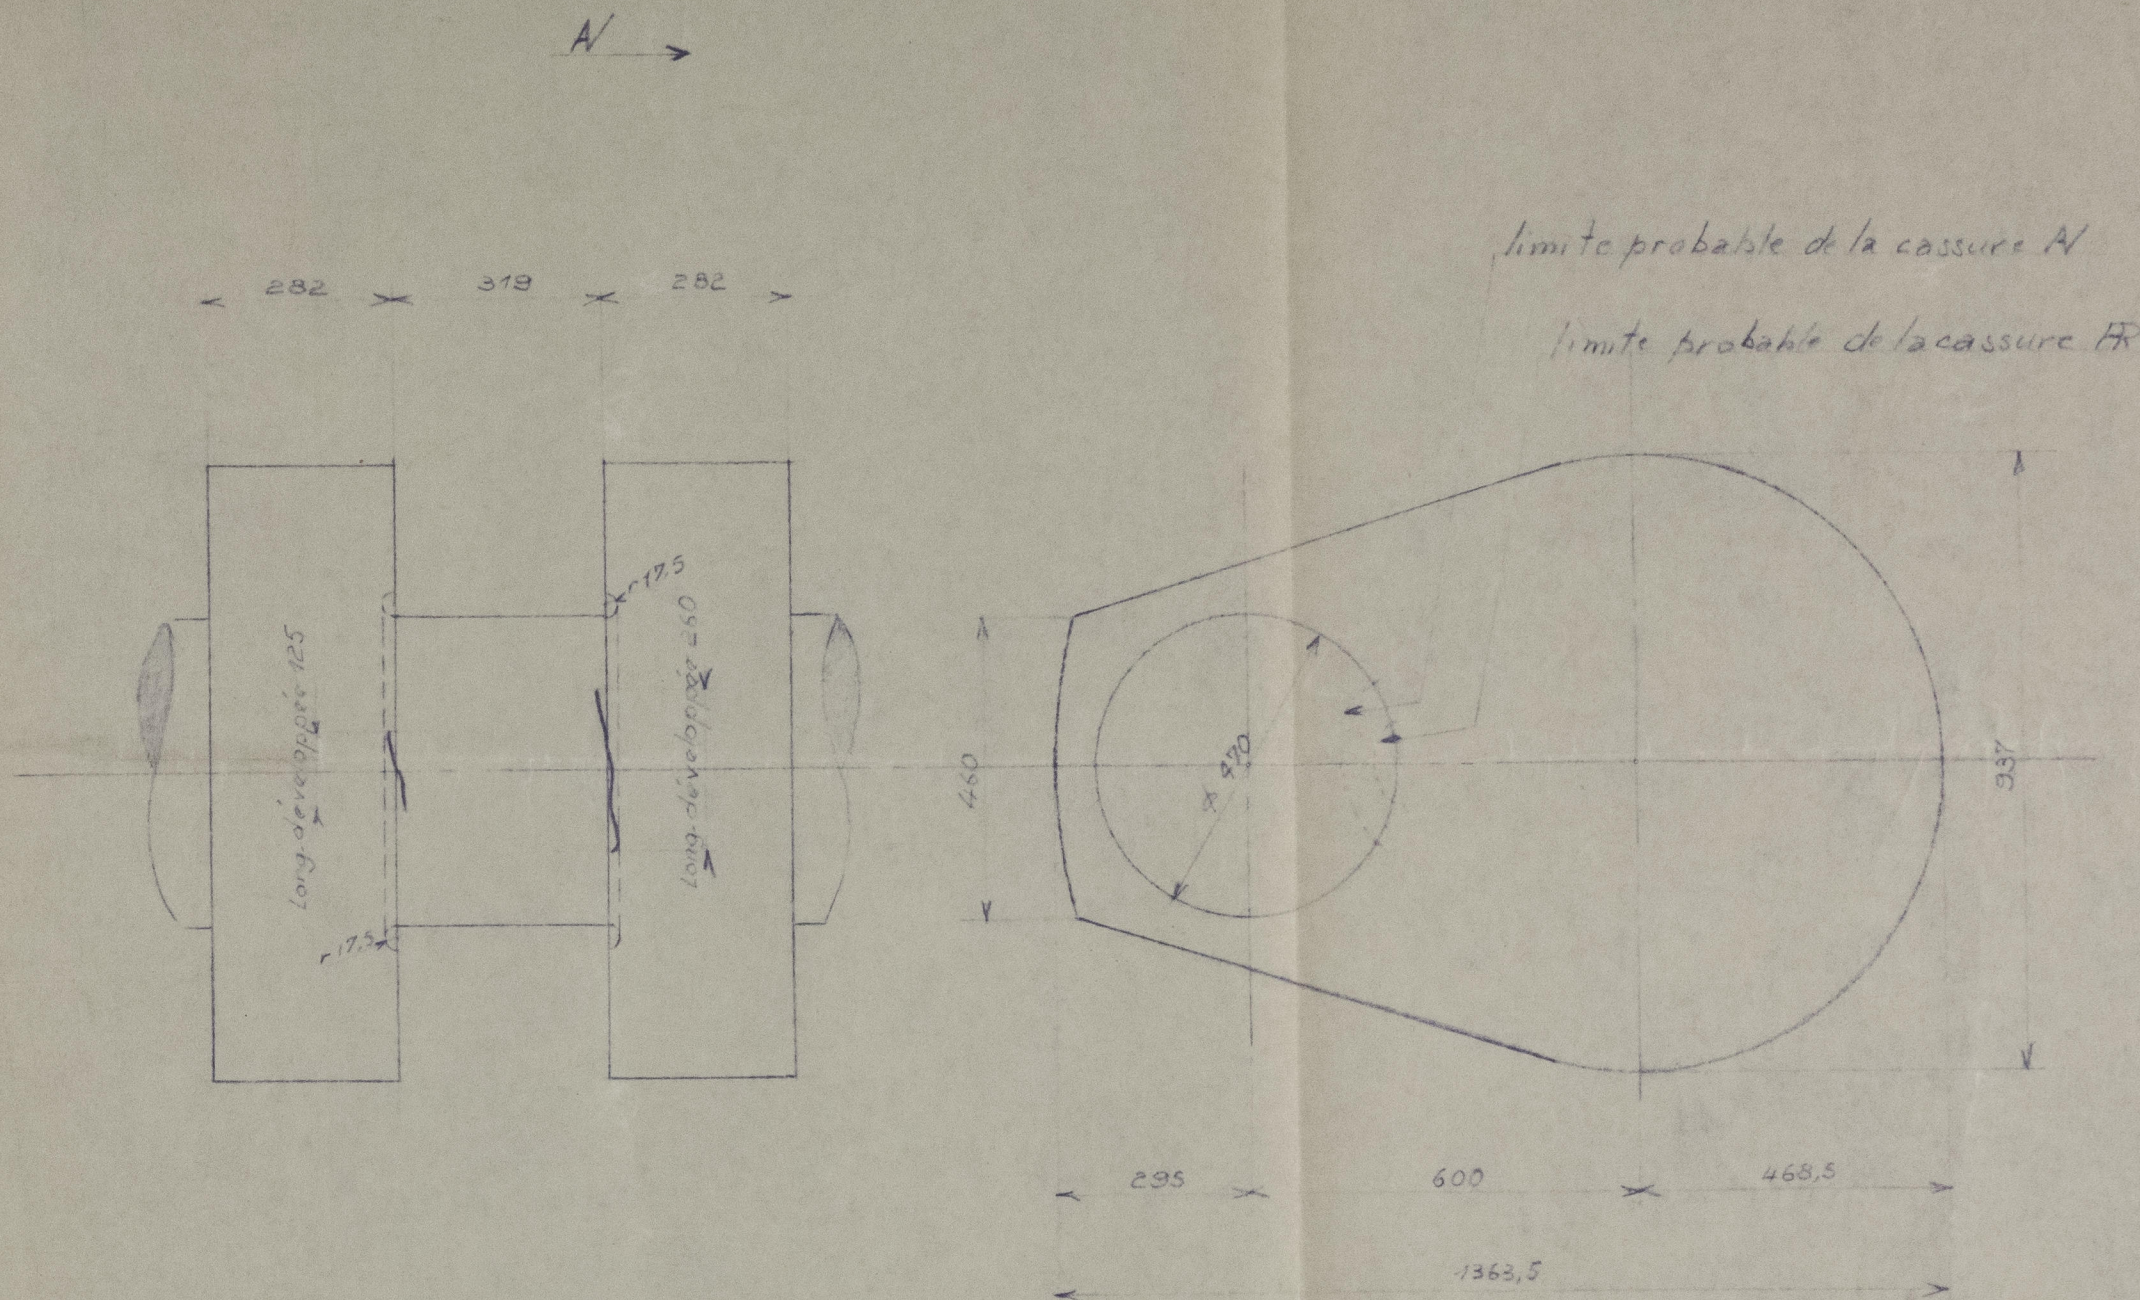

© 2021

Crankshaft fracture

Lloyd's Register
Foundation