


UNITED WITH THE BRITISH CORPORATION REGISTERED

Official No.

SKETCH OF DECKHOUSE ON FREEBOARD DECK

DIMENSIONS METRIC

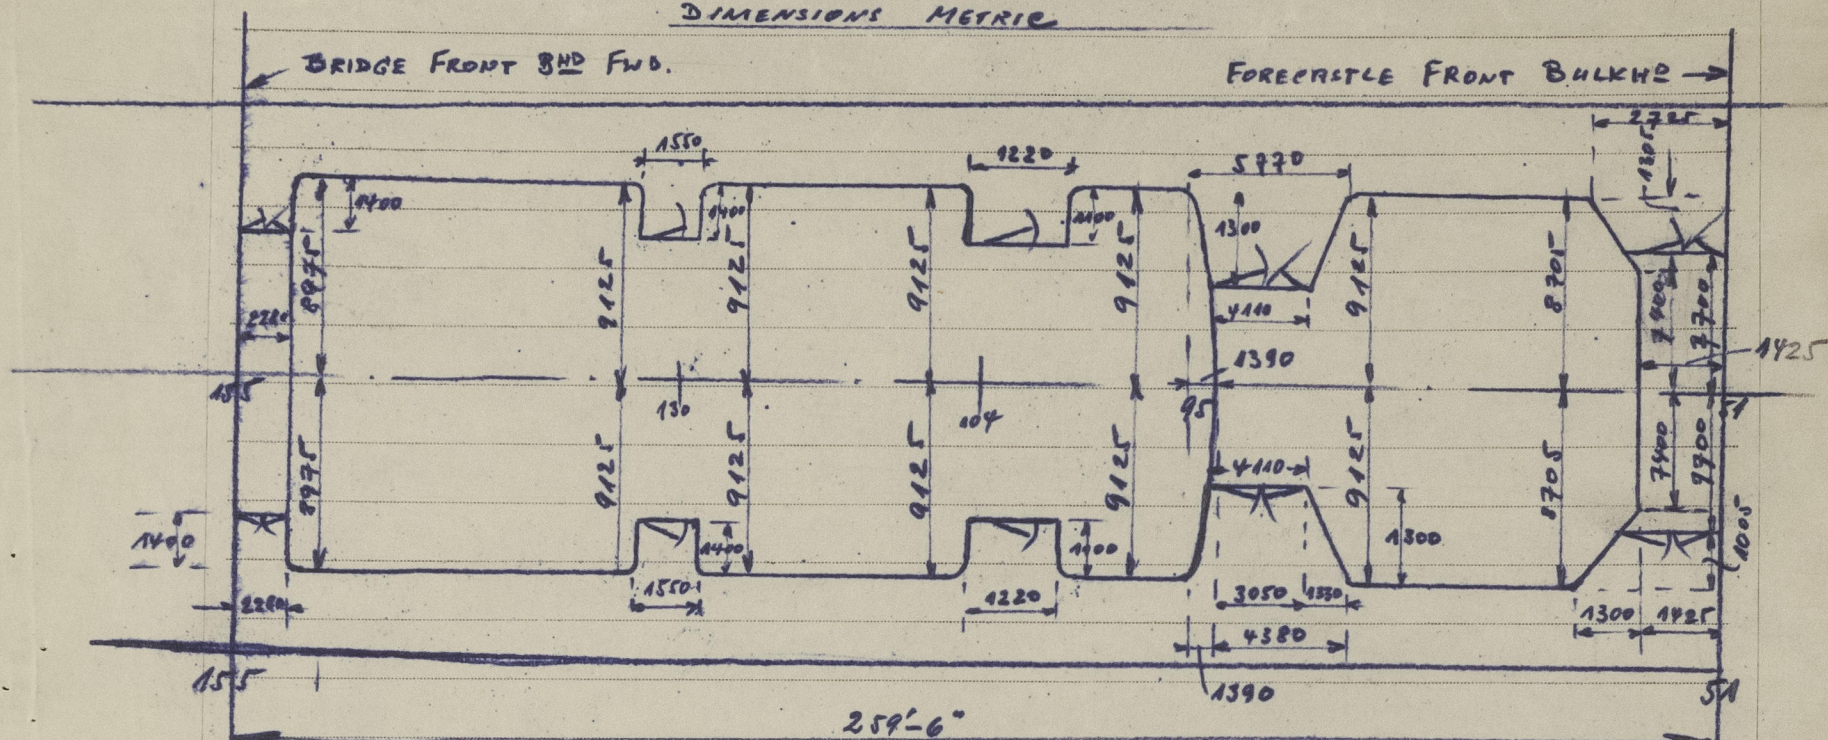

Bremen, the 25th January, 1957
A. H. C. C.