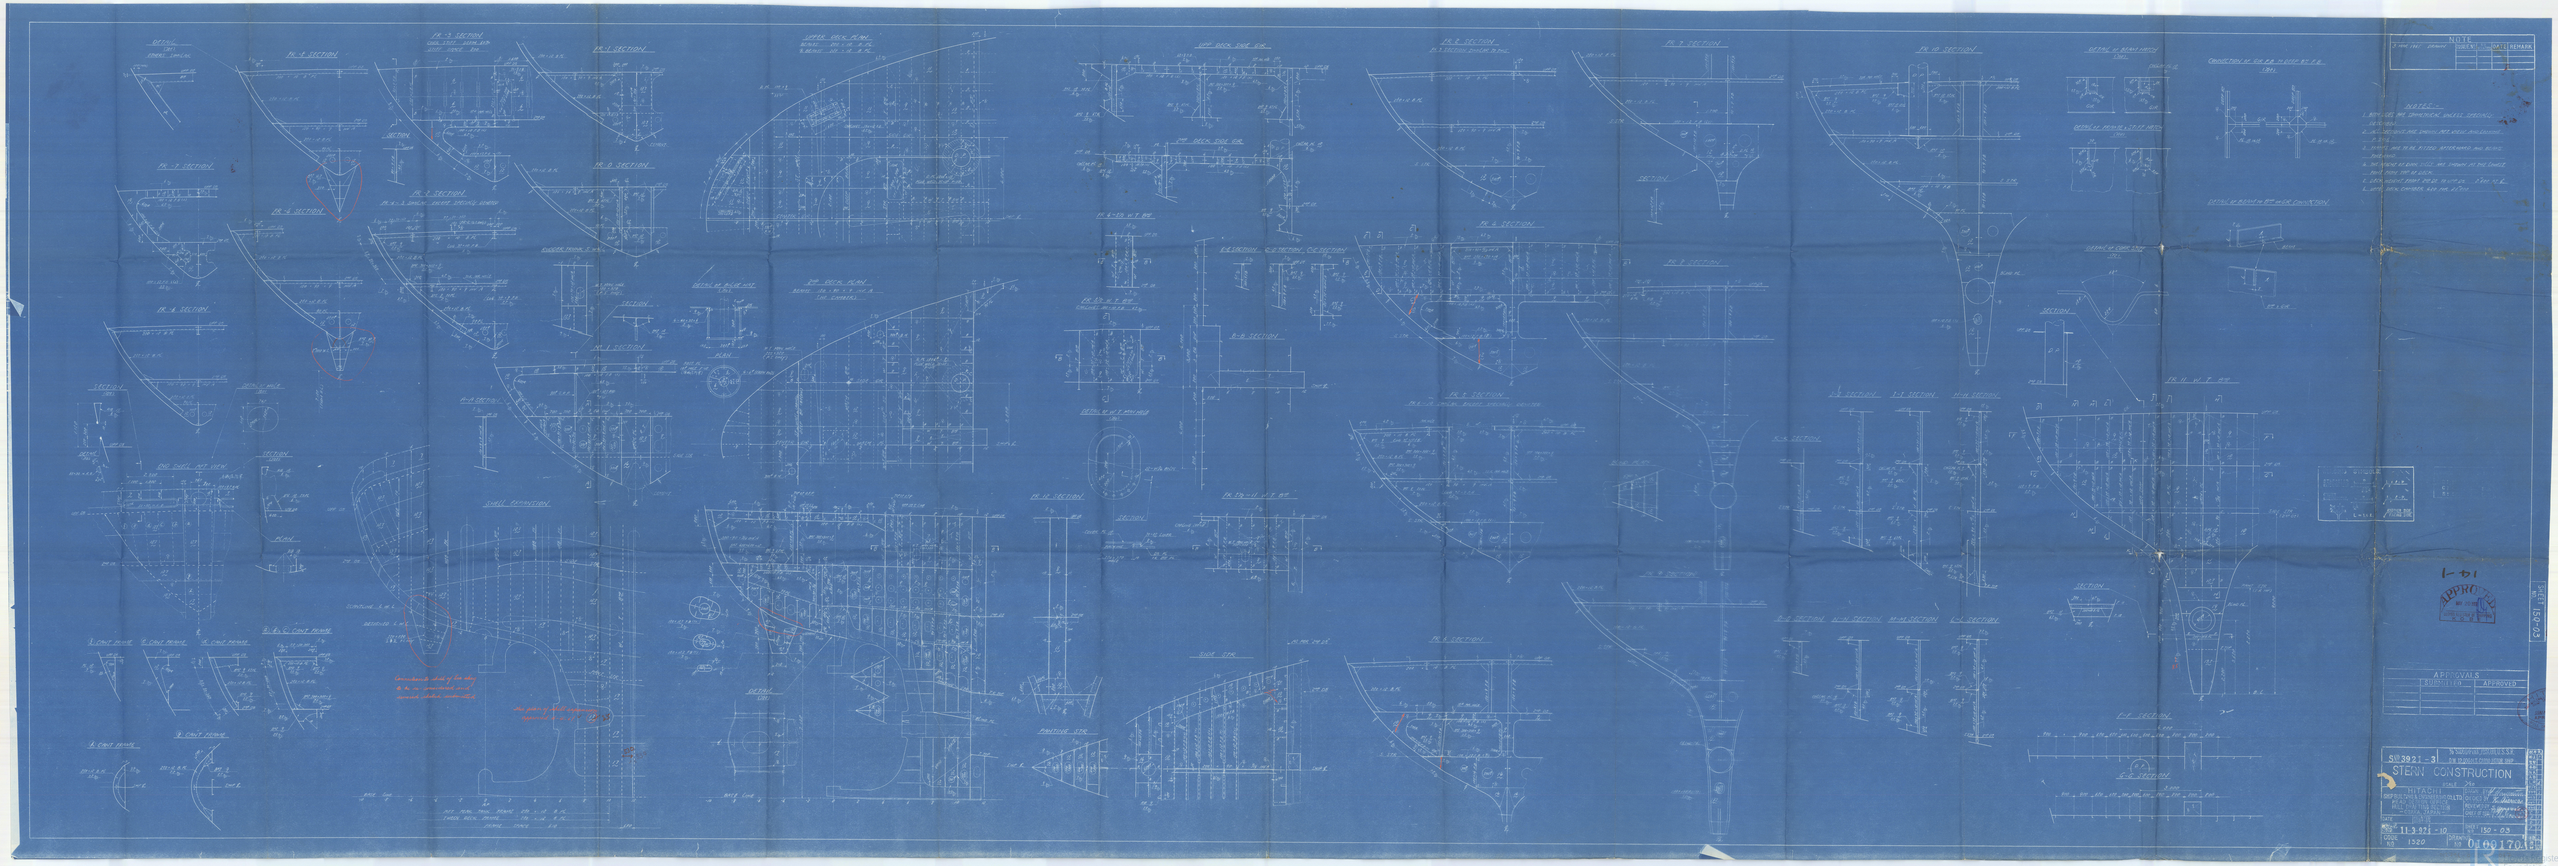
NOTE
NOTES:-
APPROVALS
SUBMITTED
APPROVED
SHELL EXPANSION
SIDE STR.
PANTINE STR.
STERN CONSTRUCTION
HITACHI
SHEET NO. 150-03
DATE 11-3-921-10
SCALE 1:20
DRAWING NO. 1520
STEAM NO. 0100170

Kobe Rpt. No.	10186
Port of Survey	OSAKA, JAPAN
Name of Ship.	"OKHOTSK"
Title of Plan.	"STERN CONSTRUCTION

FOR AP

ACE
ENGINEERING
DESIGN OFFICE
JAPAN
5 1961
DRAFTING SECT

RECORDS DEPT
LONDON

3

FOR APPROVAL

© 2021
Lloyd's Register
Foundation

012796-012800-0067