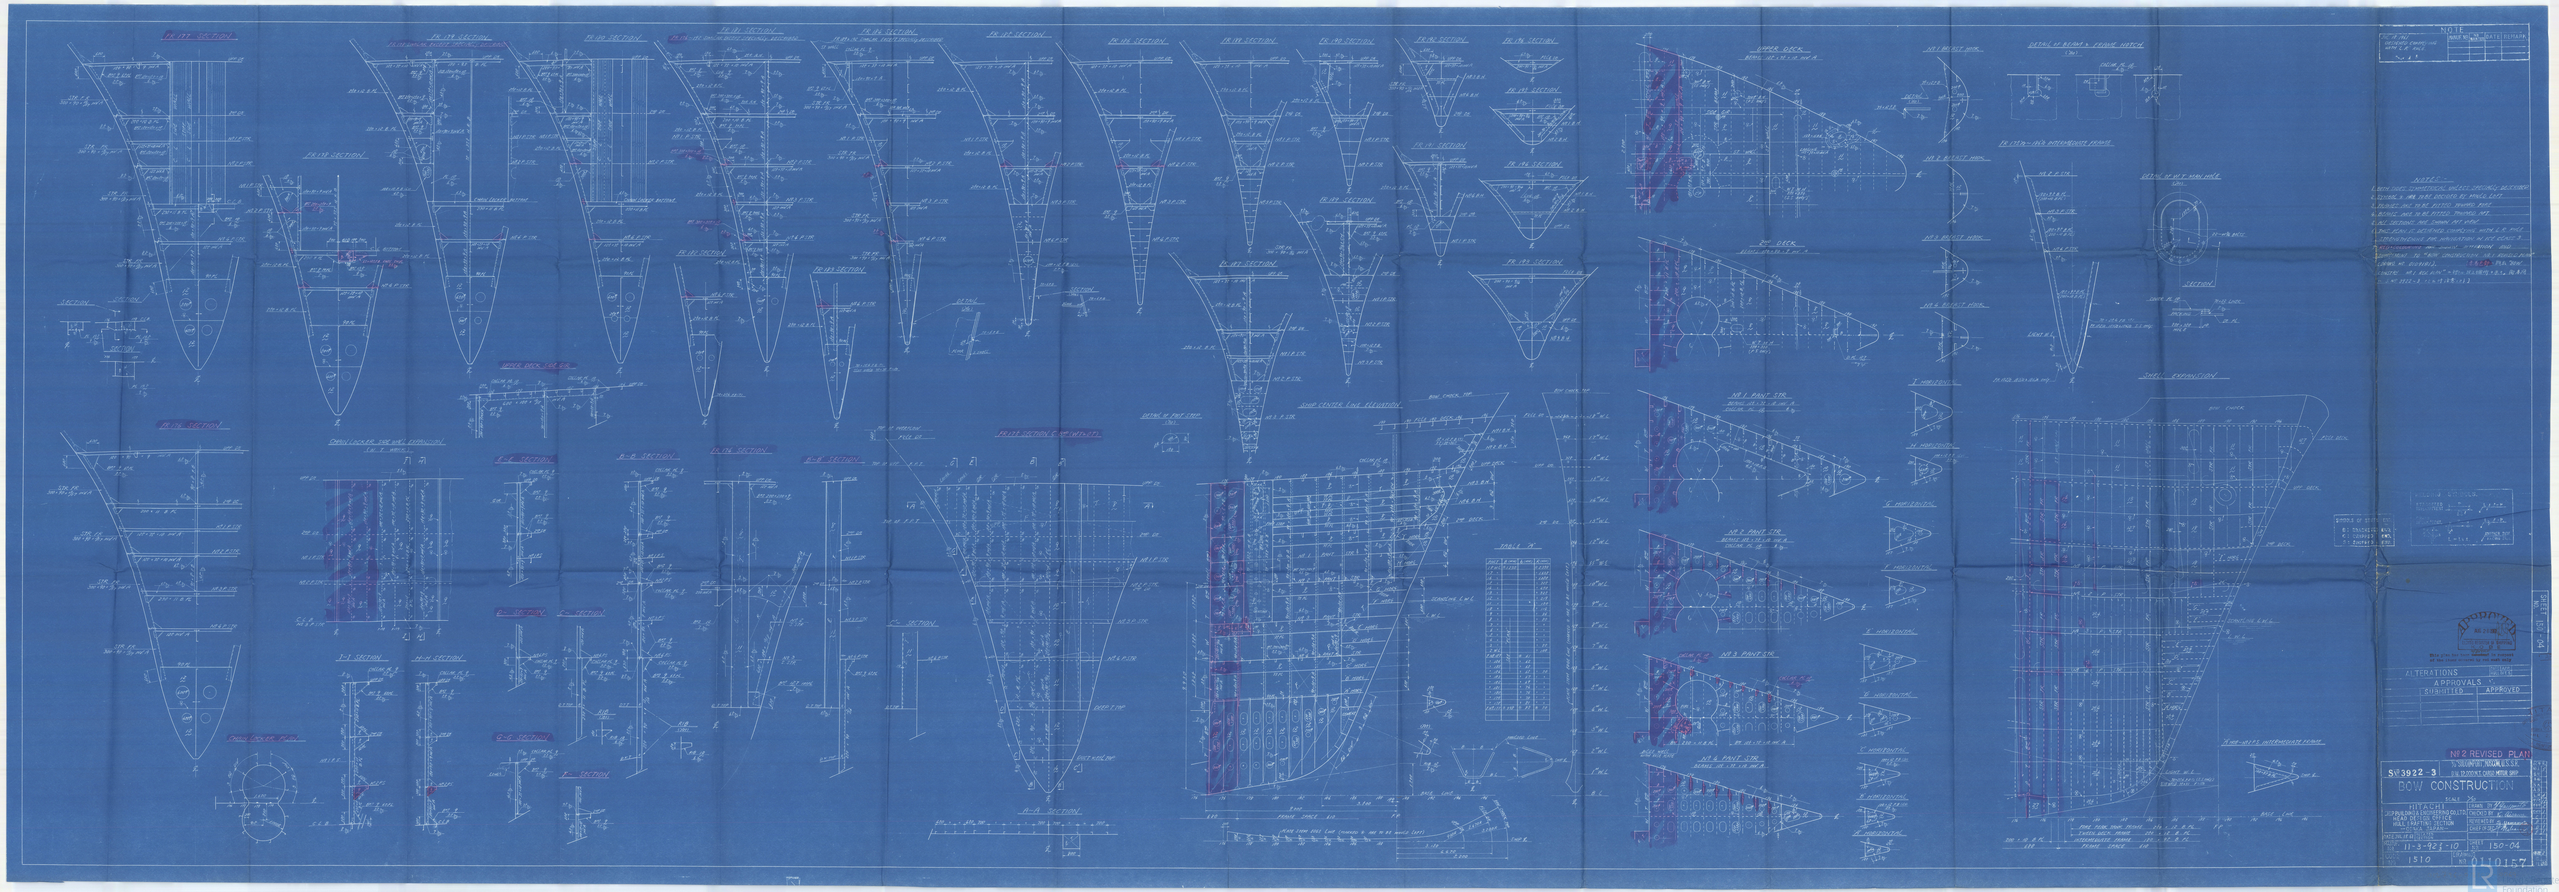
NOTE
NOTES:-
ALTERATIONS
APPROVALS
SUBMITTED
APPROVED
No 2 REVISED PLAN
SW 3922-3
BOW CONSTRUCTION
HITACHI
11-3-92
1510
150-04
0110157

Kobe Rpt. No.	10186
Port of Survey.	OSAKA, JAPAN
Name of Ship.	"OKHOTSK
Title of	BOW CONSTRUCTION

RECORDS DEPT.
LONDON.

4

012796-012800-0069

Kobe Rpt. No.	
Port of Survey.	KOBE
Name of Ship.	
Title of	

PROVAL

CHI
EERING CO., LTD.
OFFICE
JAPAN
1961
SECTION

© 2021
Lloyd's Register
Foundation

012796-012800-0069