


RUDDER STOCK



NOTES:

1. RED-COLORED PARTS ARE TO BE REVISED.
2. CAUSE OF REVISION: IMPROVEMENT OF DESIGN.

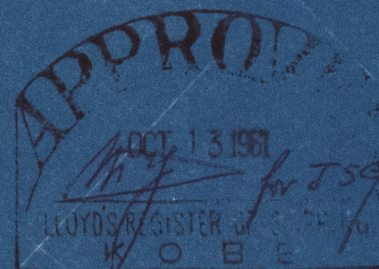

NOTE

JULY 21, 1961 DRAWN
AUG. 2, 1961 前同引換

FOR APPROVAL

MANUF. NO	NG WANTED	DATE	REMARK

NO. 1
REVISED PLAN

S NO 3921-3

1/2 "SUDDOIMPORT" MOSCOW, U.S.S.R.
D.W. 12,000 M.T. CARGO MOTOR SHIP

RUDDER

ALTERATION-3

SCALE 1/25

HITACHI
SHIP BUILDING & ENGINEERING CO. LTD.
HEAD DESIGN OFFICE
HULL DRAFTING SECTION
— OSAKA, JAPAN —

DATE JULY 21, 1961

DRAWN BY Y. Takagaki

CHECKED BY K. Aisawa

REVIEWED BY S. Yamamoto

CHIEF OF SECT. T. Nakamura

RELATED SECTION S. Tachiyama

SHEET NO 150-01-3


DRWG NO 556175

配付先	
船主	3
船政	
船政	10
船政	2
船政	10
船政	1
船政	1
船政	1
船政	1
船政	2
船政	2
船政	3

MANUF. NO 11-3-923-10 CODE NO 1540

012796-012800-0071

Handwritten red markings, possibly a signature or initials, located in the lower-left quadrant of the page.

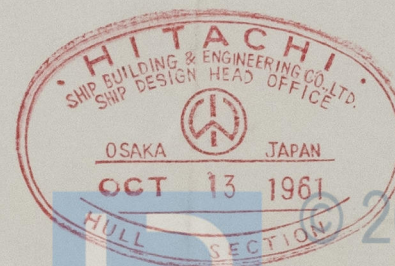

© 2021
Lloyd's Register
Foundation

012796-012800-0071