


# M.V. QUEENSGATE. PROFILE & DECKS.


SCALE: 1/4" = 1 FOOT.

CLELANDS YARD N. 229.  
DIMENSIONS - 110'-3" LBP x 25'-0" BMLD x 9'-2" DMLD  
CLASS - LLOYDS 100 A1


EQUIPMENT NUMERALS:	
1 (B-3) = 85L (D-3) = 110-28 (25 x 0-46) + 85-110 (25 x 0-46) = 3754	
POOP DECK.	22' 0" x 7' 0" = 84
FORECASTLE DECK.	16' 0" x 7' 0" = 84
CASING.	6' 0" x 7' 0" = 42

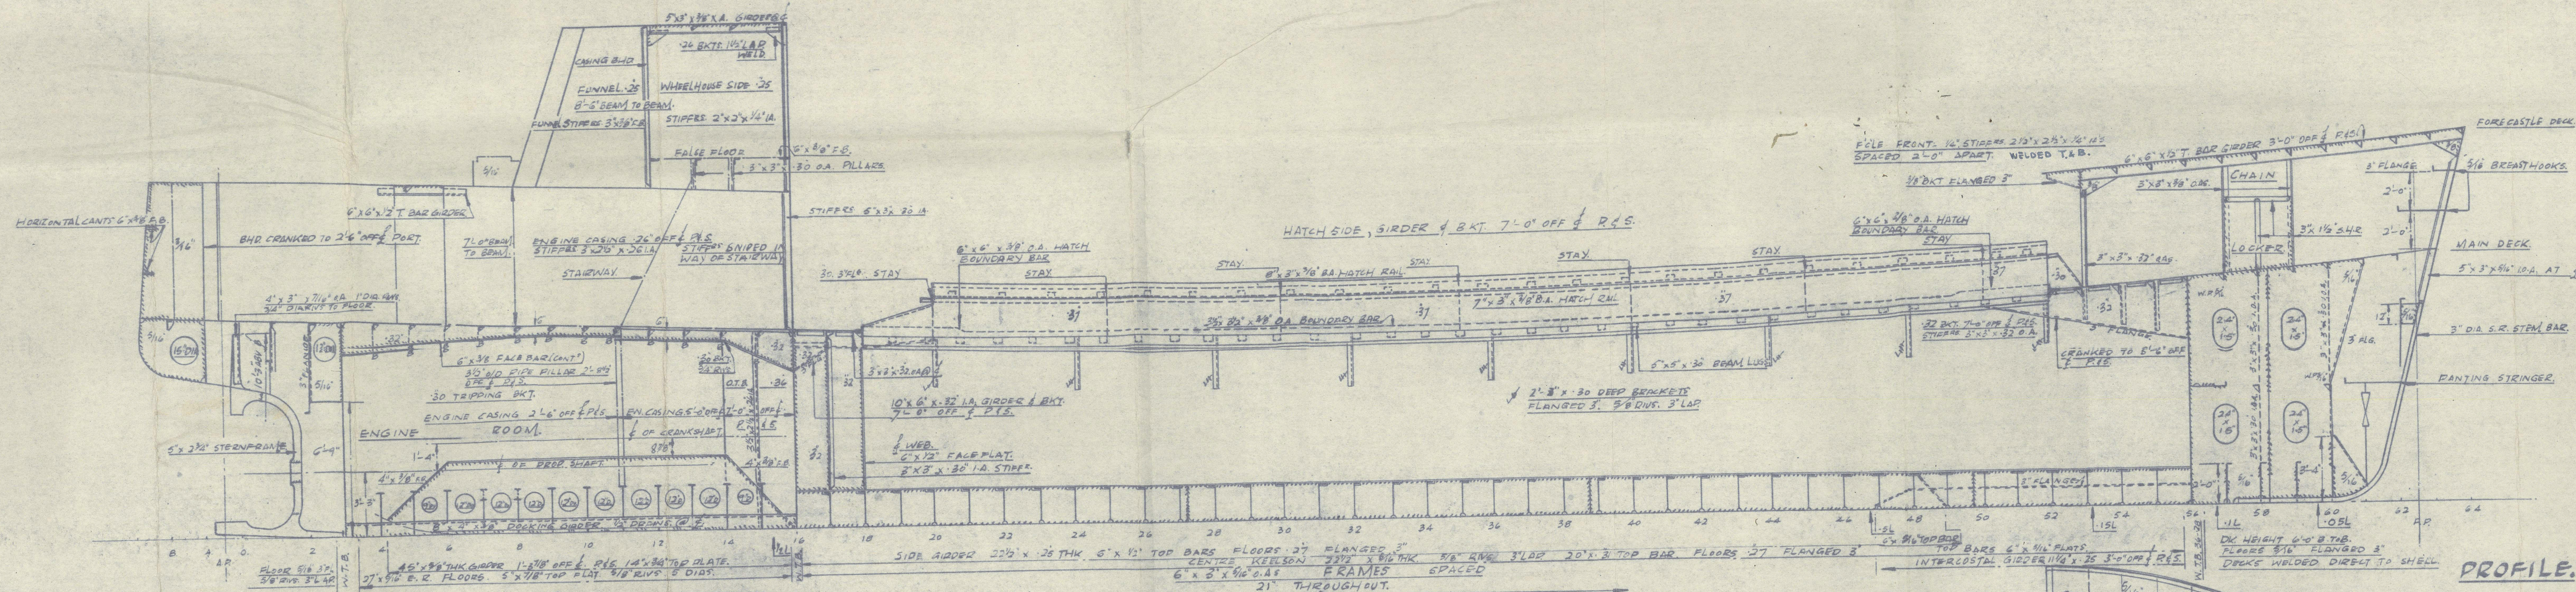


PROFILE.

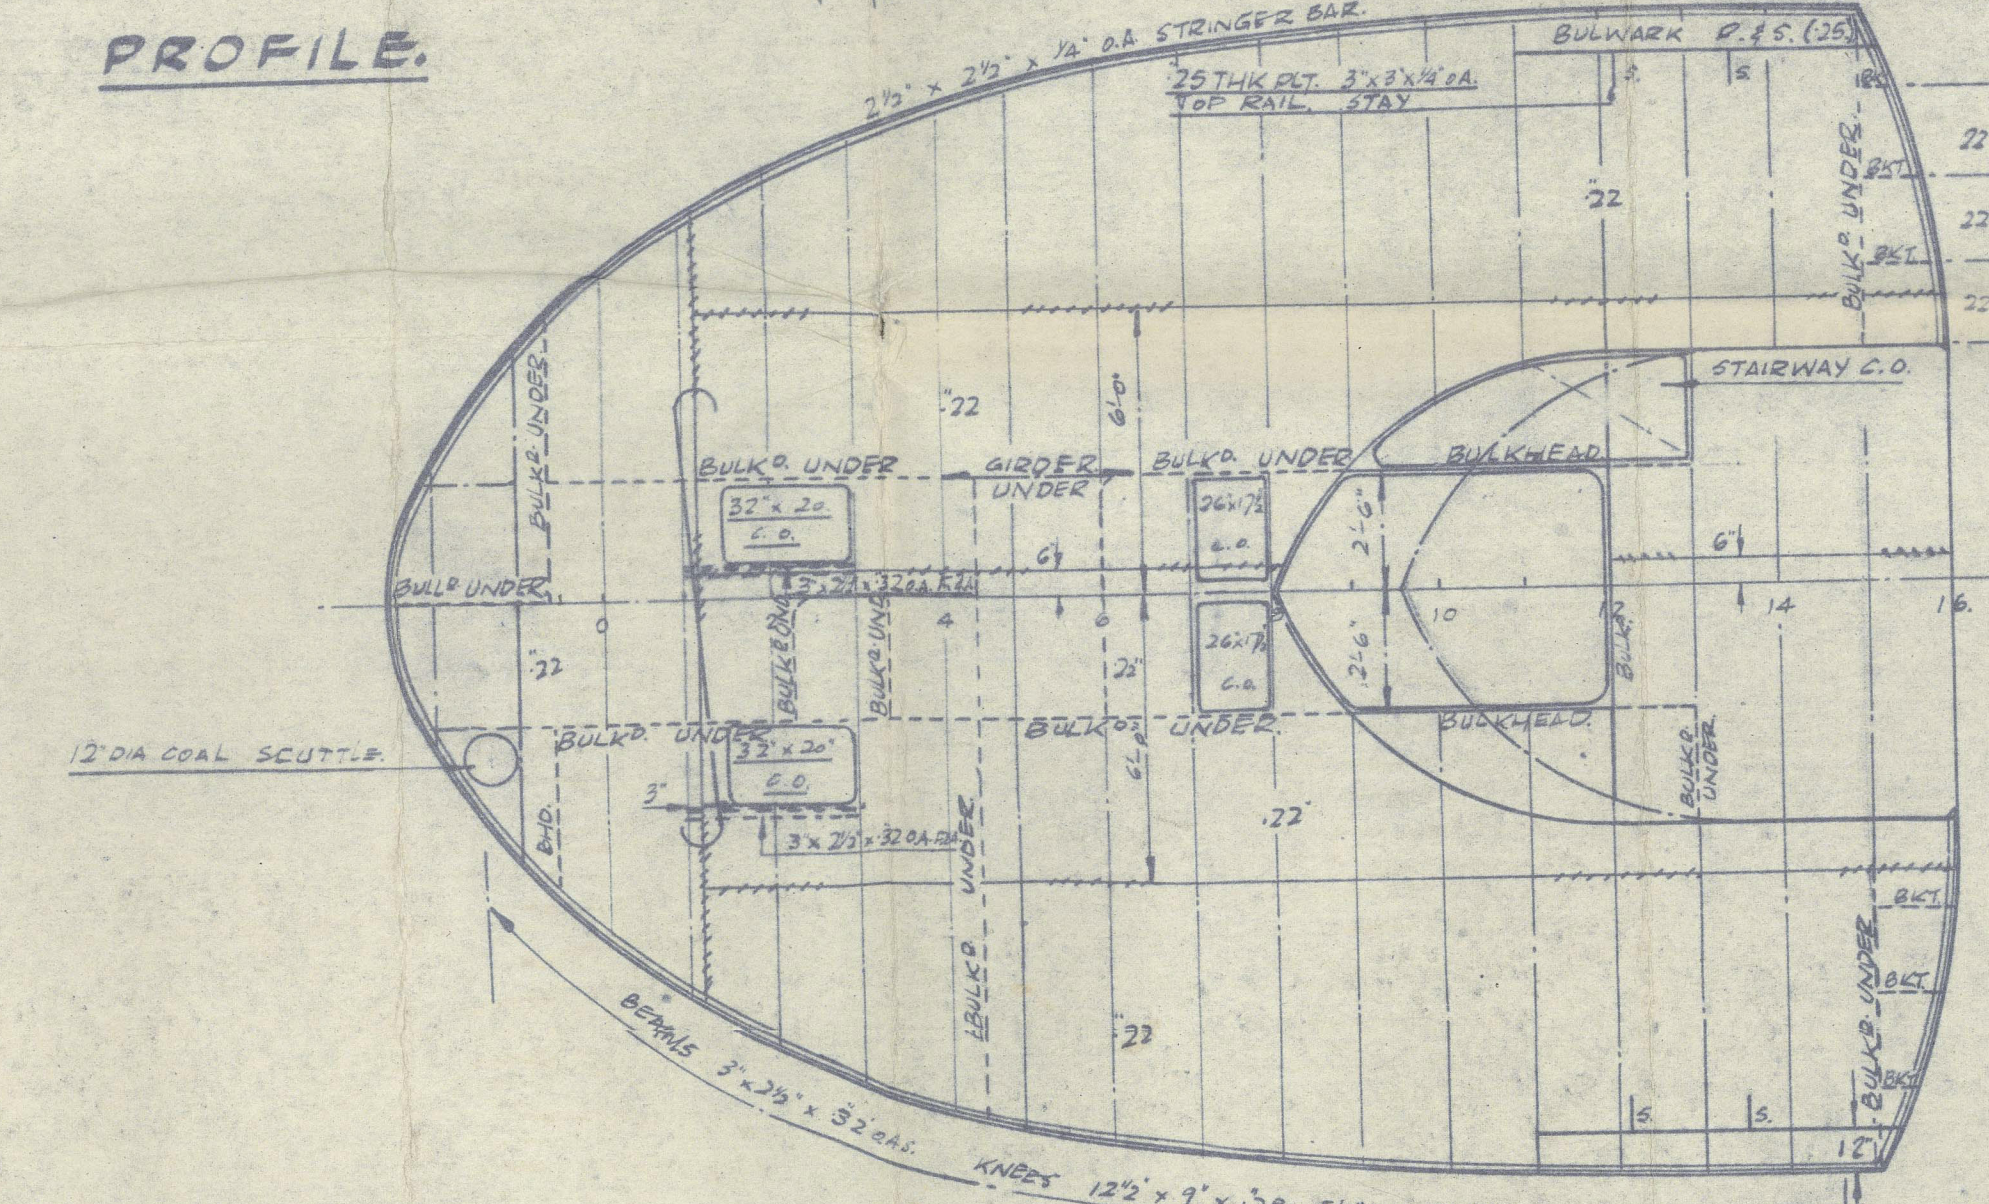


PLAN VIEW AT FALSE FLOOR.

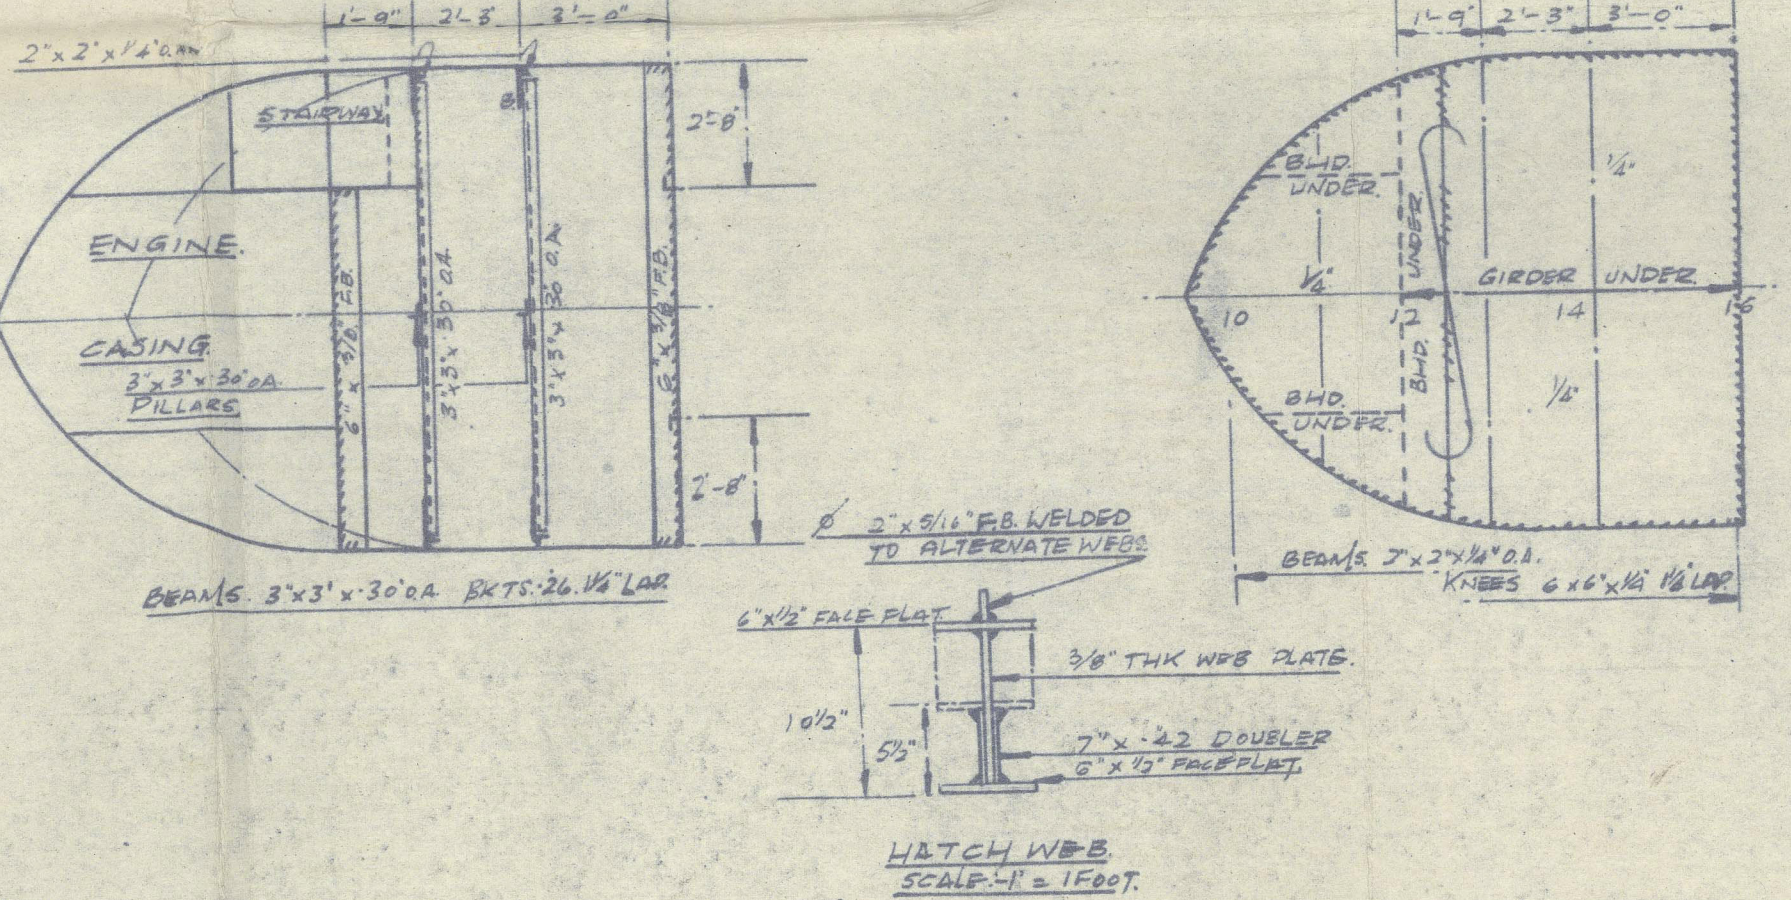


WHEELHOUSE TOP.

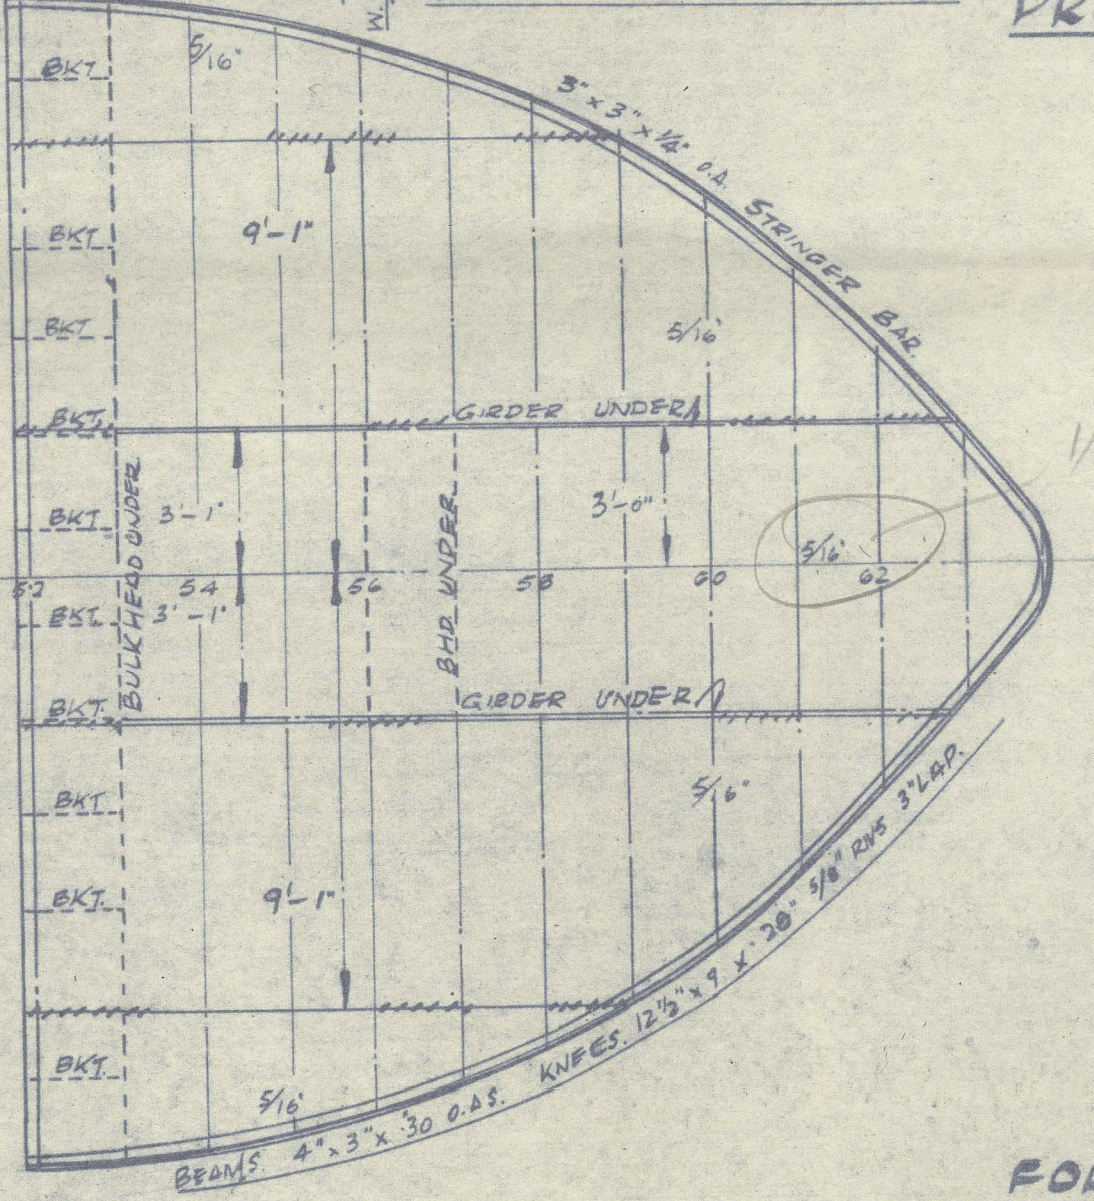


FORECASTLE DECK.

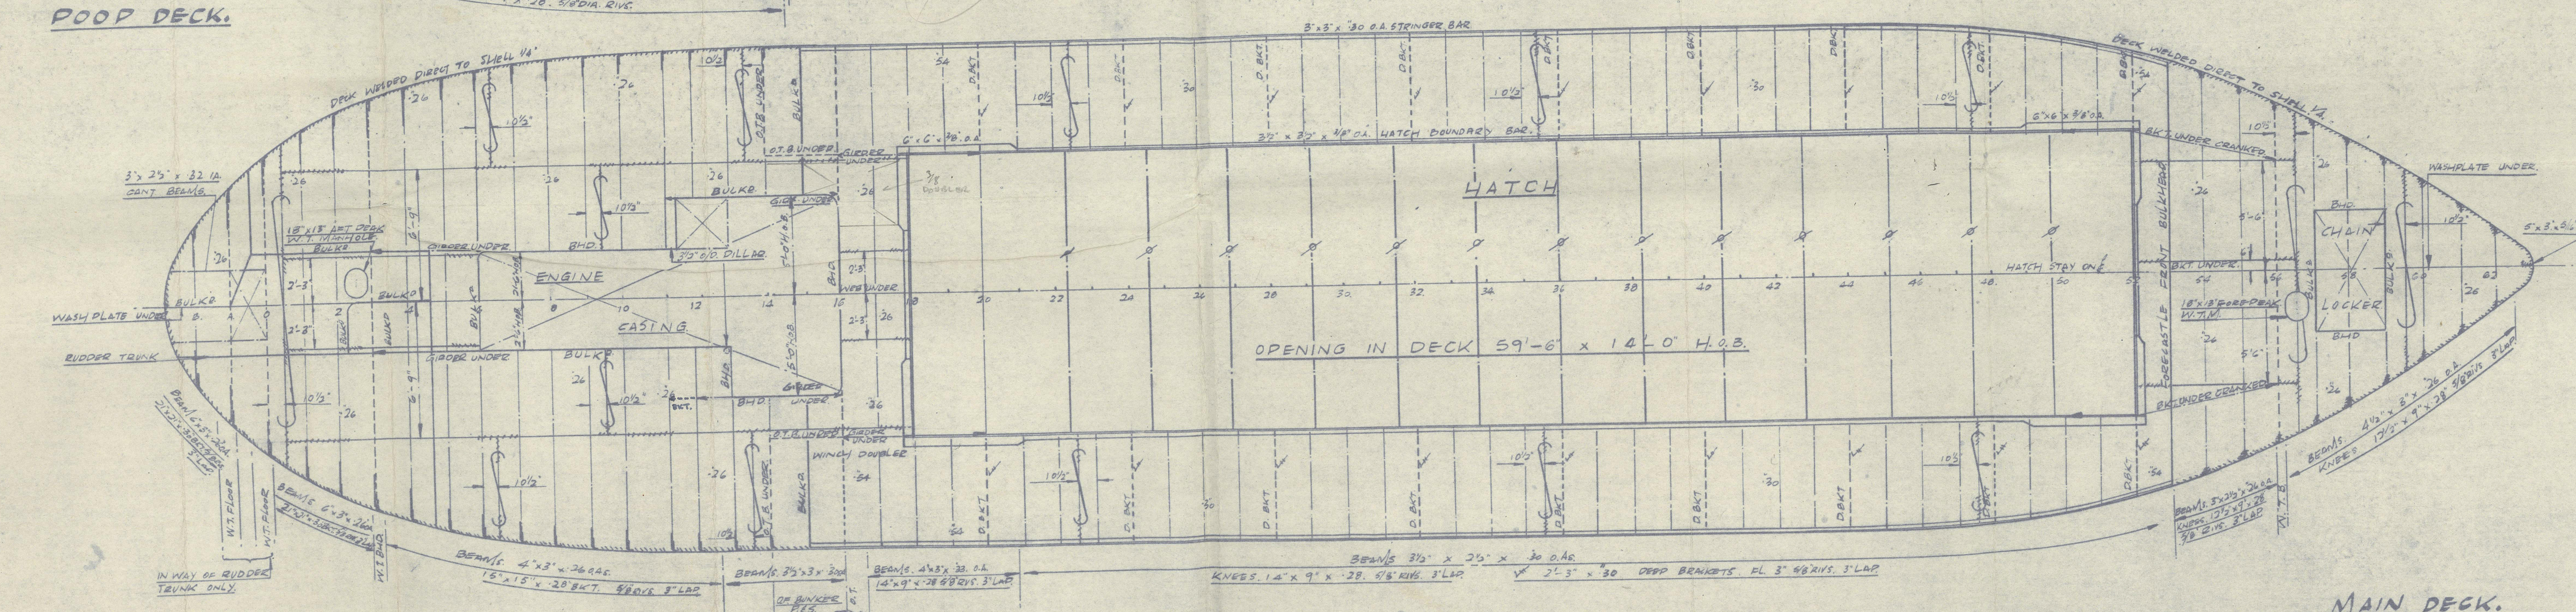


MAIN DECK.

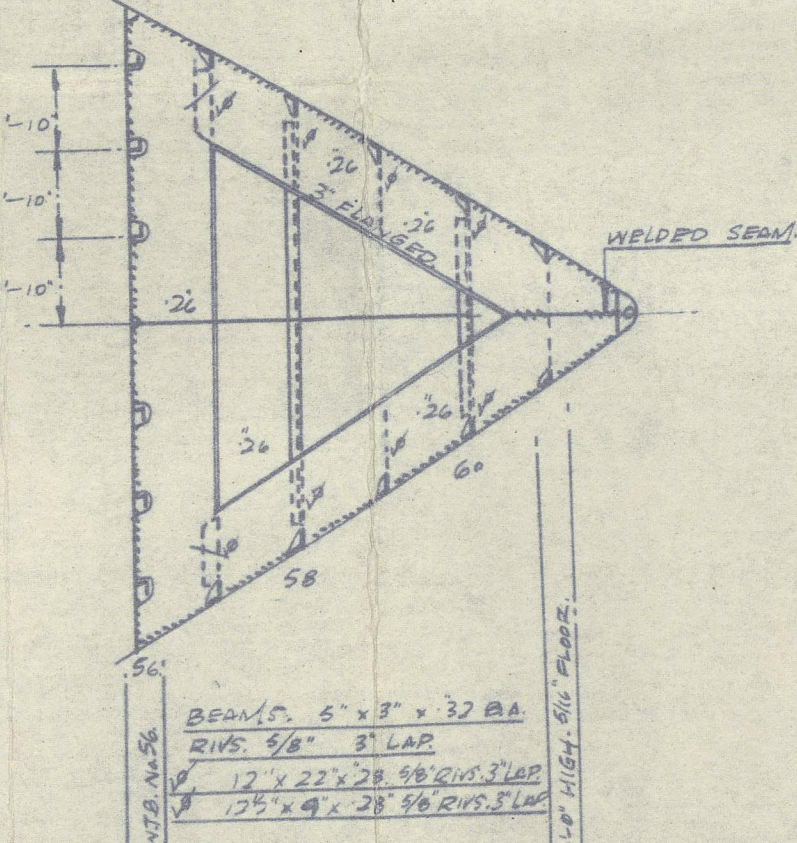


PANTING STRINGER.

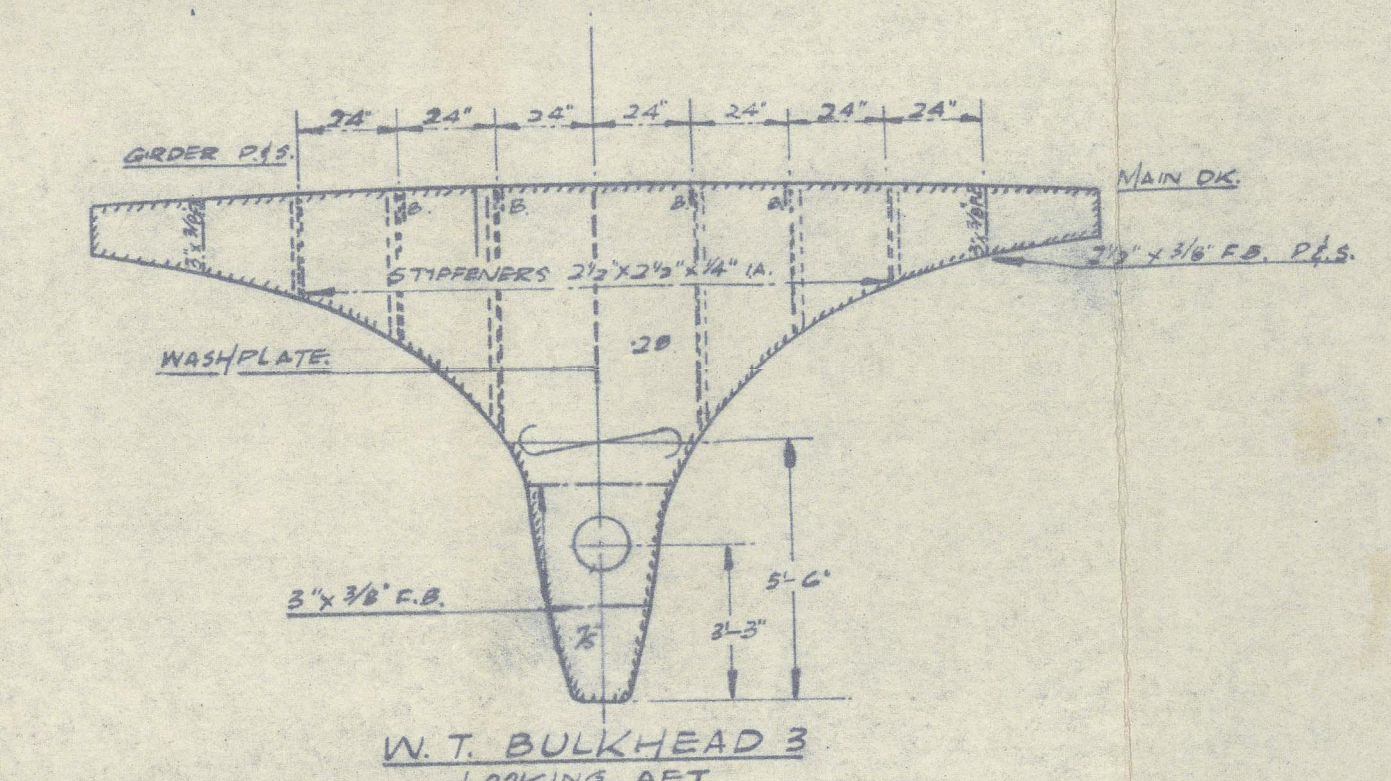


W.T. BULKHEAD 3  
LOOKING AFT.

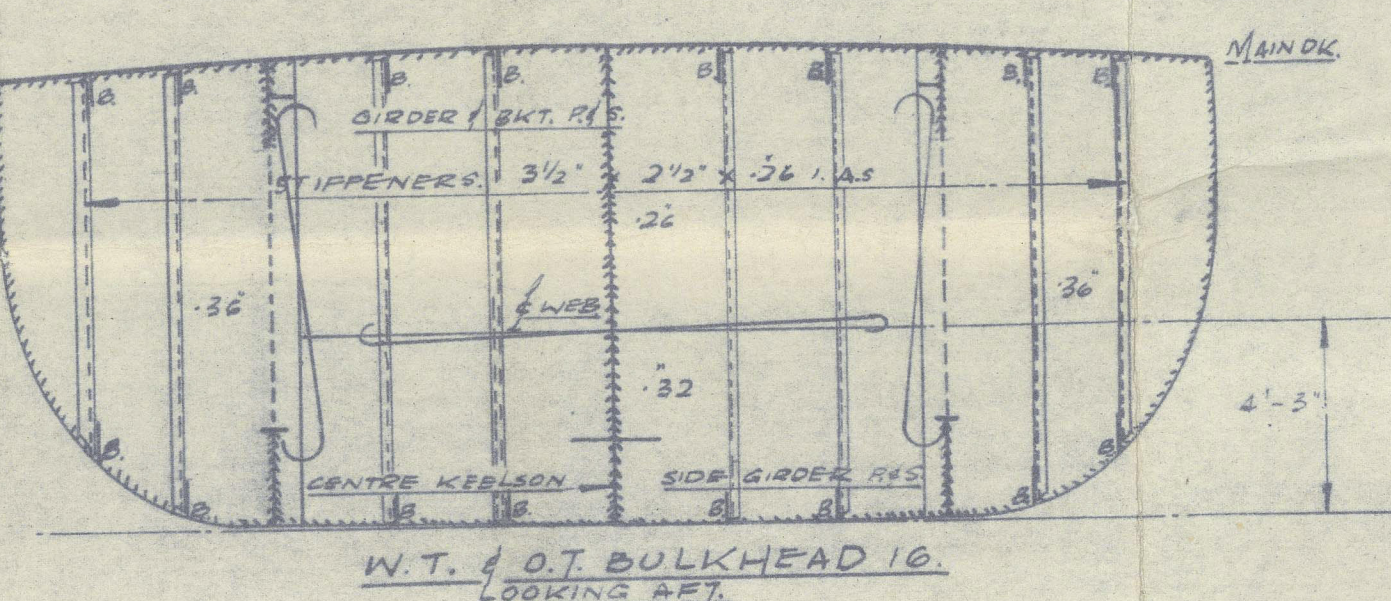


LOOKING AFT.

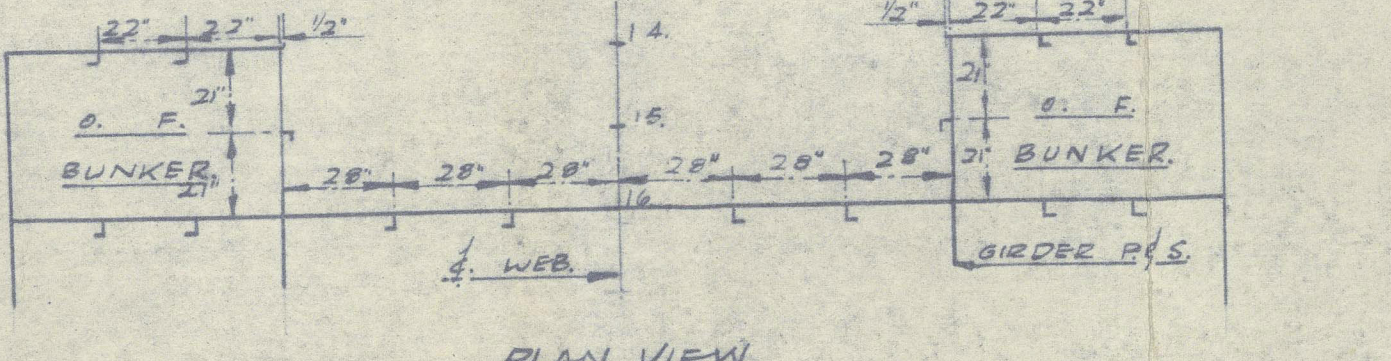

PLAN VIEW.

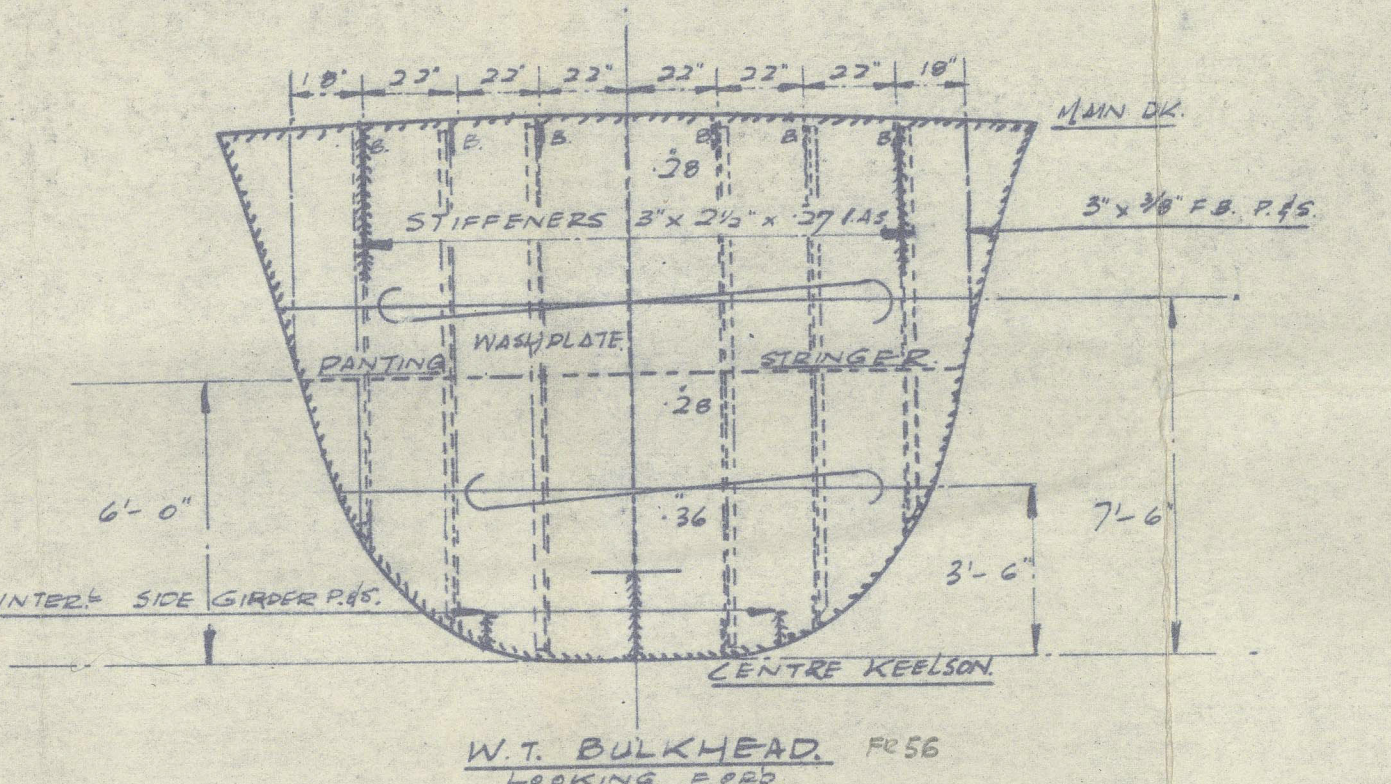

LOOKING FORWARD.

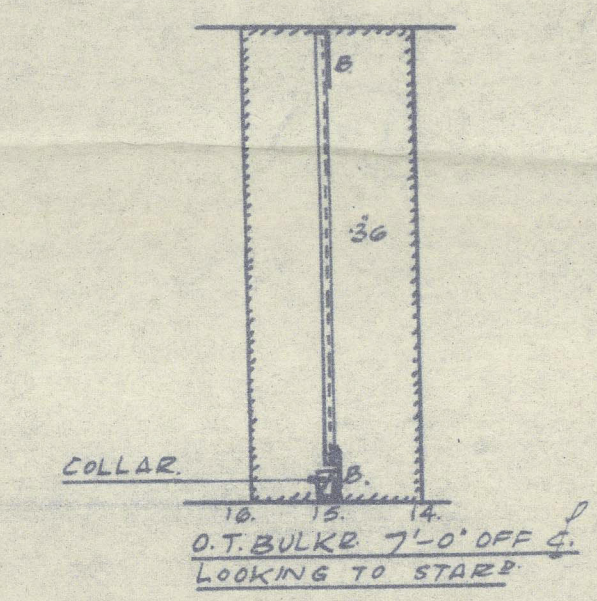




CLELANDS (SUCCESSORS) LTD.

QUEENFORD

EX

QUEENSGATE

(YARD NO 239)




PROFILE & DECK PLAN

(AS FITTED)

D/S

906

RECORDS DEPT.,  
LONDON.

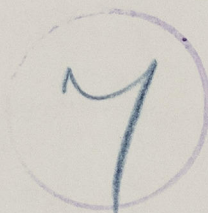

© 2021

Lloyd's Register  
Foundation

012818-012826-2003