


FRONT WALL	SIDE WALL	AFT WALL
PLATE 1/2" x 11' x 8'	1/2" x 11' x 8'	1/2" x 11' x 8'
SPACE 7'10" x 7'10"	7'10" x 7'10"	7'10" x 7'10"
END ATTACH FREE	FREE	FREE

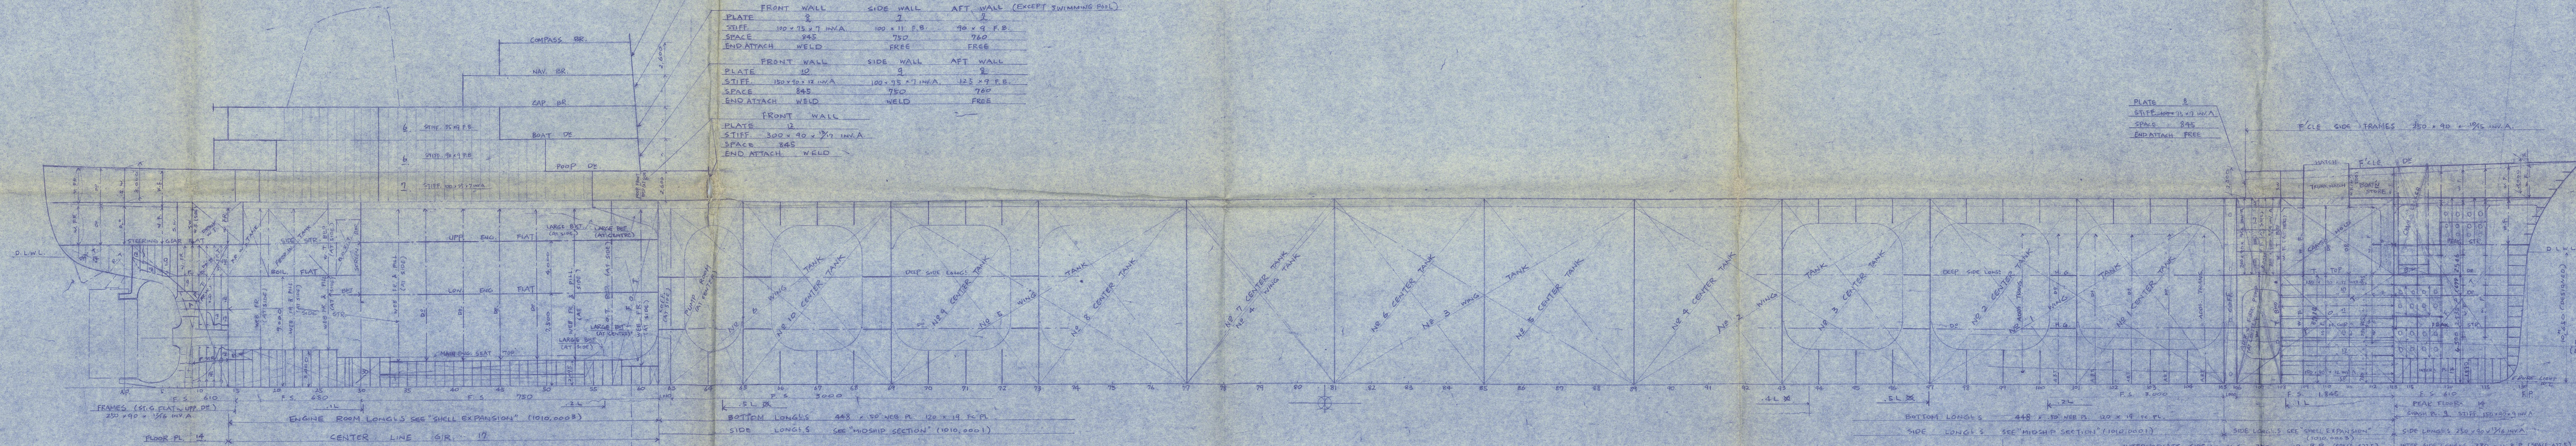

POOP DECK

BOAT DECK

CAPTAIN BR DECK

NAVIGATION BR DECK

COMPASS BR DECK

F/C DECK

BOILER FLAT

UPPER ENG FLAT

UPPER DECK

SEC. UNDER ENGINE

DOUBLE BOTTOM

STEERING ENG FLAT

CARGO TANK ARRANG.

DEEP TANK TOP

FINO 110

ALTERATION

DESCRIPTION

REVISIONS

## CLASS

LLOYD'S TOP AL OIL TANKER

LONGER FRAMES "SEA CLASS 3" STANDARD

FRAME 100

## PRINCIPAL DIMENSIONS

LENGTH (LOA) 140'0" (42.68)

BREADTH (MAX) 27'0" (8.23)

DEPTH (MAX) 14'6" (4.43)

DRAFT (DESIGNED) 10'0" (3.05)

## NOTES

- 1) MATERIAL TO BE IN ACCORDANCE WITH L.R. S.
- 2) ALL DIMENSIONS TO CENTER OF STEEL

APPROVED BY

NUMBER

DATE

FINISHED PLAN

S. No. 615

DW 35000 DIESEL DRIVEN

PETROLEUM TANKER

CONSTRUCTION PROFILE

DECK PLAN

鋼材配置

SCALE 1/2" = 1' (1:24)

SHIMIZU MARINE ENGINEERING CO. LTD.

SHIP DESIGN DEPARTMENT

DESIGNED BY

CHECKED BY

DATE










This plan has been verified with the approved plans, and includes any modifications and/or additions to the original approved arrangements made during construction which have been approved locally as being in accordance with or equivalent to Rule requirements.

Signature

*Victor McGean*

Surveyor(s) to Lloyd's Register of Shipping.


Date

*9th Oct 1963*

Kobe Rpt. No.	11838
Port of Survey	BIOI
Name of Ship.	LOZOVAYA *
Title of Plan.	CONSTRUCTION. PROFILE + DECK.

RECORDS DEPT.  
LONDON.

3

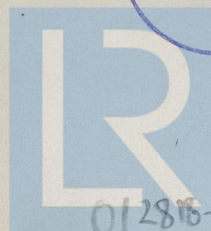

© 2021

Lloyd's Register  
Foundation