


THE DISPOSITION DIAGRAM OF CRANKSHAFT MATERIAL

Takasago Inspection Section
Inspection Department
KOBE STEEL WORKS, LTD.

Engine Builder: ISHIKAWAJIMA HARIMA HEAVY INDUSTRIES CO., LTD. AIOI
Eng. No.: 225 (Ship No. 615)
Item: Semi built-up crankshaft for 9RD90 type diesel engine
Identification marks on the crankshaft: KOB KT-CK 543

Material used:

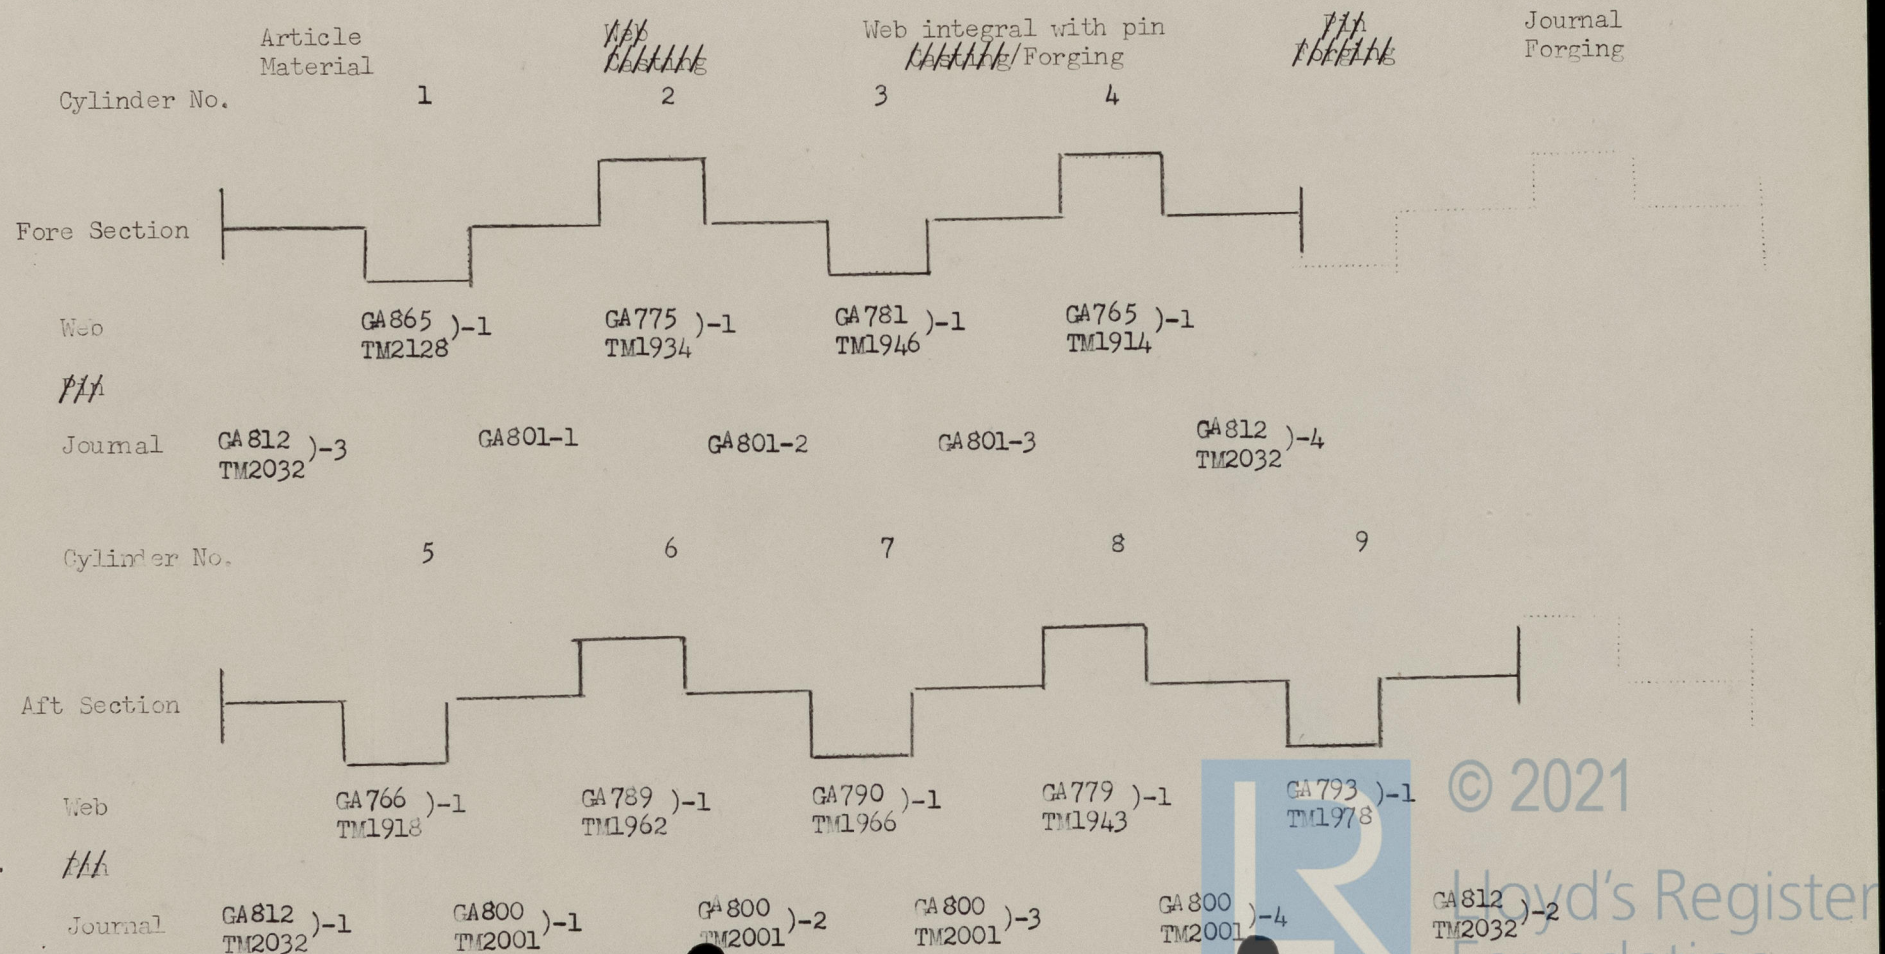

© 2021

Lloyd's Register
Foundation

012818-012926-0071