

S.S. BIOGRAPHER.



DIMENSIONS :- 44'-11" B.P. ON L.W.L. 58'-0" EXT. x 57'-9" M-D x 33'-0" M-D TO UPPER DECK
TO CLASS 100A.1 AT LLOYDS SPECIAL SURVEY.


SHEER FORWARD	=	120
SHEER $\frac{1}{8}$ LENGTH FORWARD	=	66
SHEER AFT.	=	69
SHEER $\frac{1}{8}$ LENGTH AFT.	=	38
ROUND OF BEAM.	=	14 $\frac{1}{2}$
TUMBLE HOME AT BRIDGE DECK	=	6
TUMBLE HOME AT UPPER DECK.	=	0

PLANS OF CARGO HATCHES, GIRDERS AND QUARTER PILLARS, BUILT
BEAMS, CRUISER STERN, WATERTIGHT BULKHEADS, SHAFT TUNNEL AND
BOTTOM STRENGTHENING FORWARD WILL BE SUBMITTED LATER.

ALL BULB ANGLE AND CHANNEL SECTIONS GIVEN HEREON ARE NEW BRITISH STANDARD

SCANTLINGS AND DETAILS OF CONSTRUCTION NOTED HEREON ARE SUBMITTED ON THE UNDERSTANDING THAT THEY ARE THE MINIMUM WHICH WILL BE ACCEPTED FOR CLASS AND IF NOT THEY ARE TO BE AMENDED ERRORS AND OMISSIONS EXCEPTED.

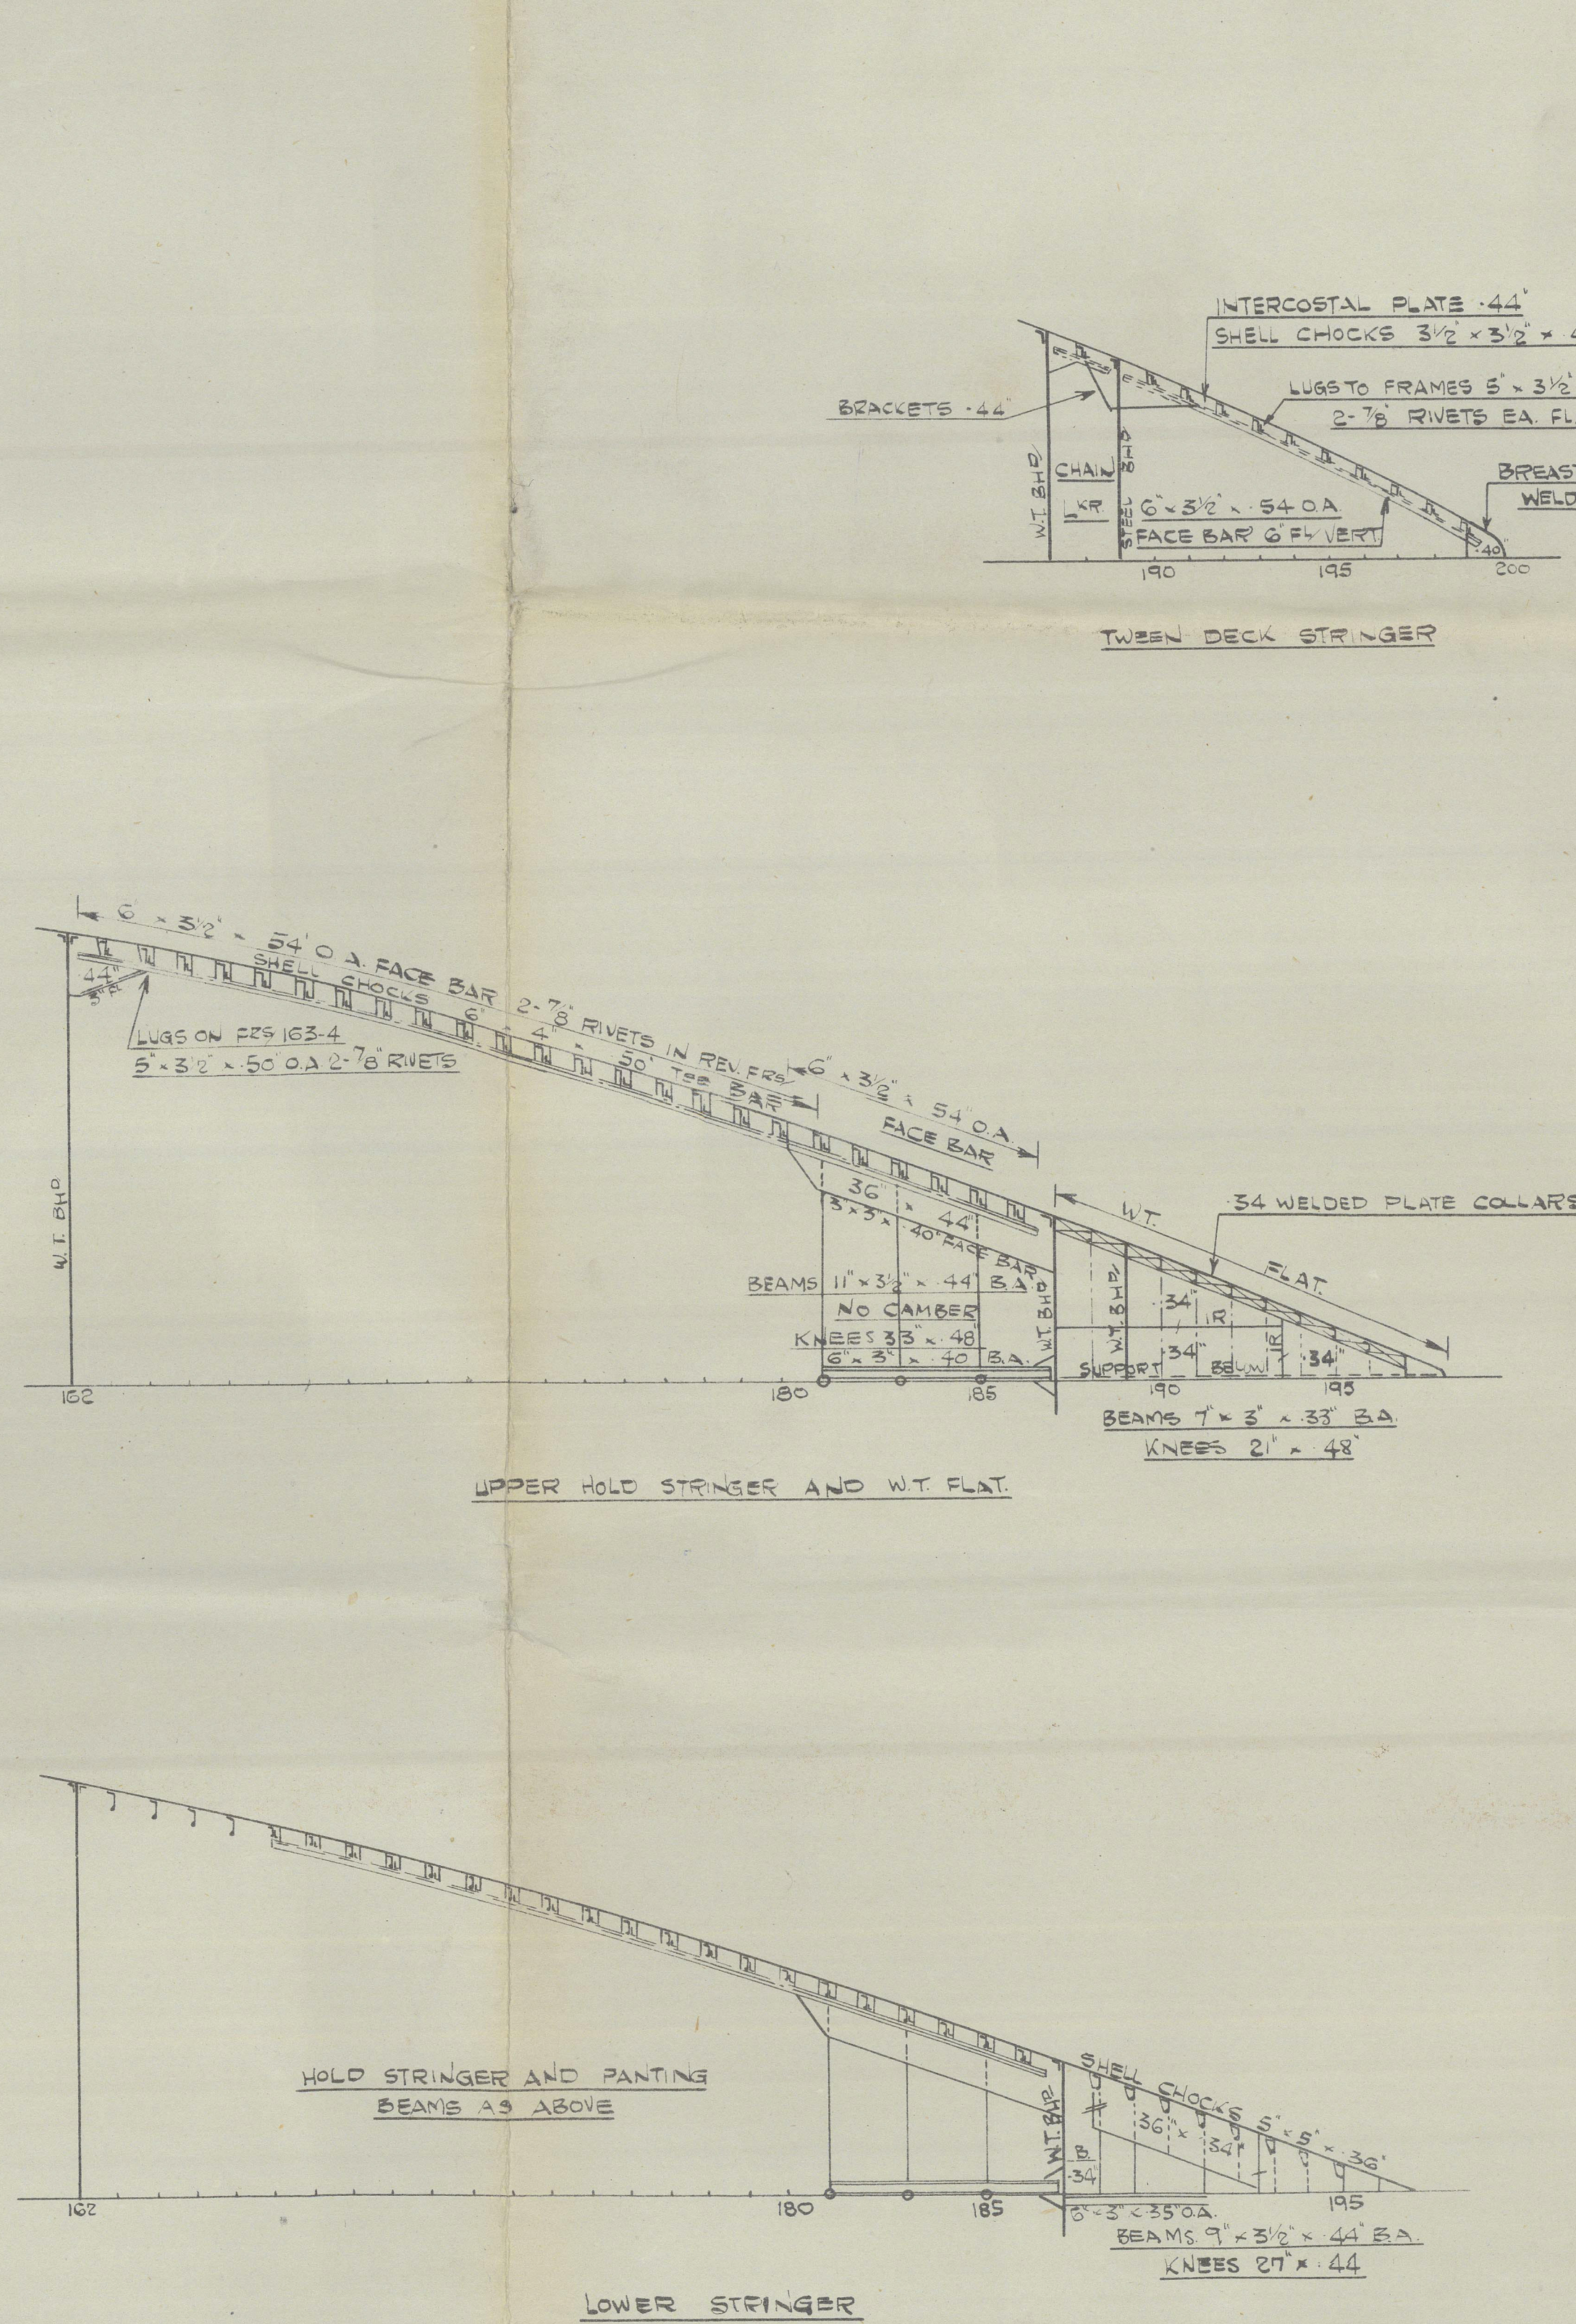 

S, S BIOGRAPHER. 


LITHGOWS NO 1029

PROFILE & DECKS

AS BUILT

GREENOCK FIRST ENTRY REPORT N° 23942

RECORDS DEPT.:
LONDON

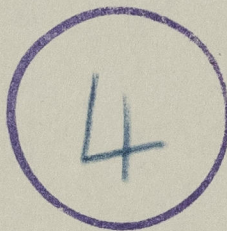

© 2021

012875-012887-0170

Lloyd's Register
Foundation