
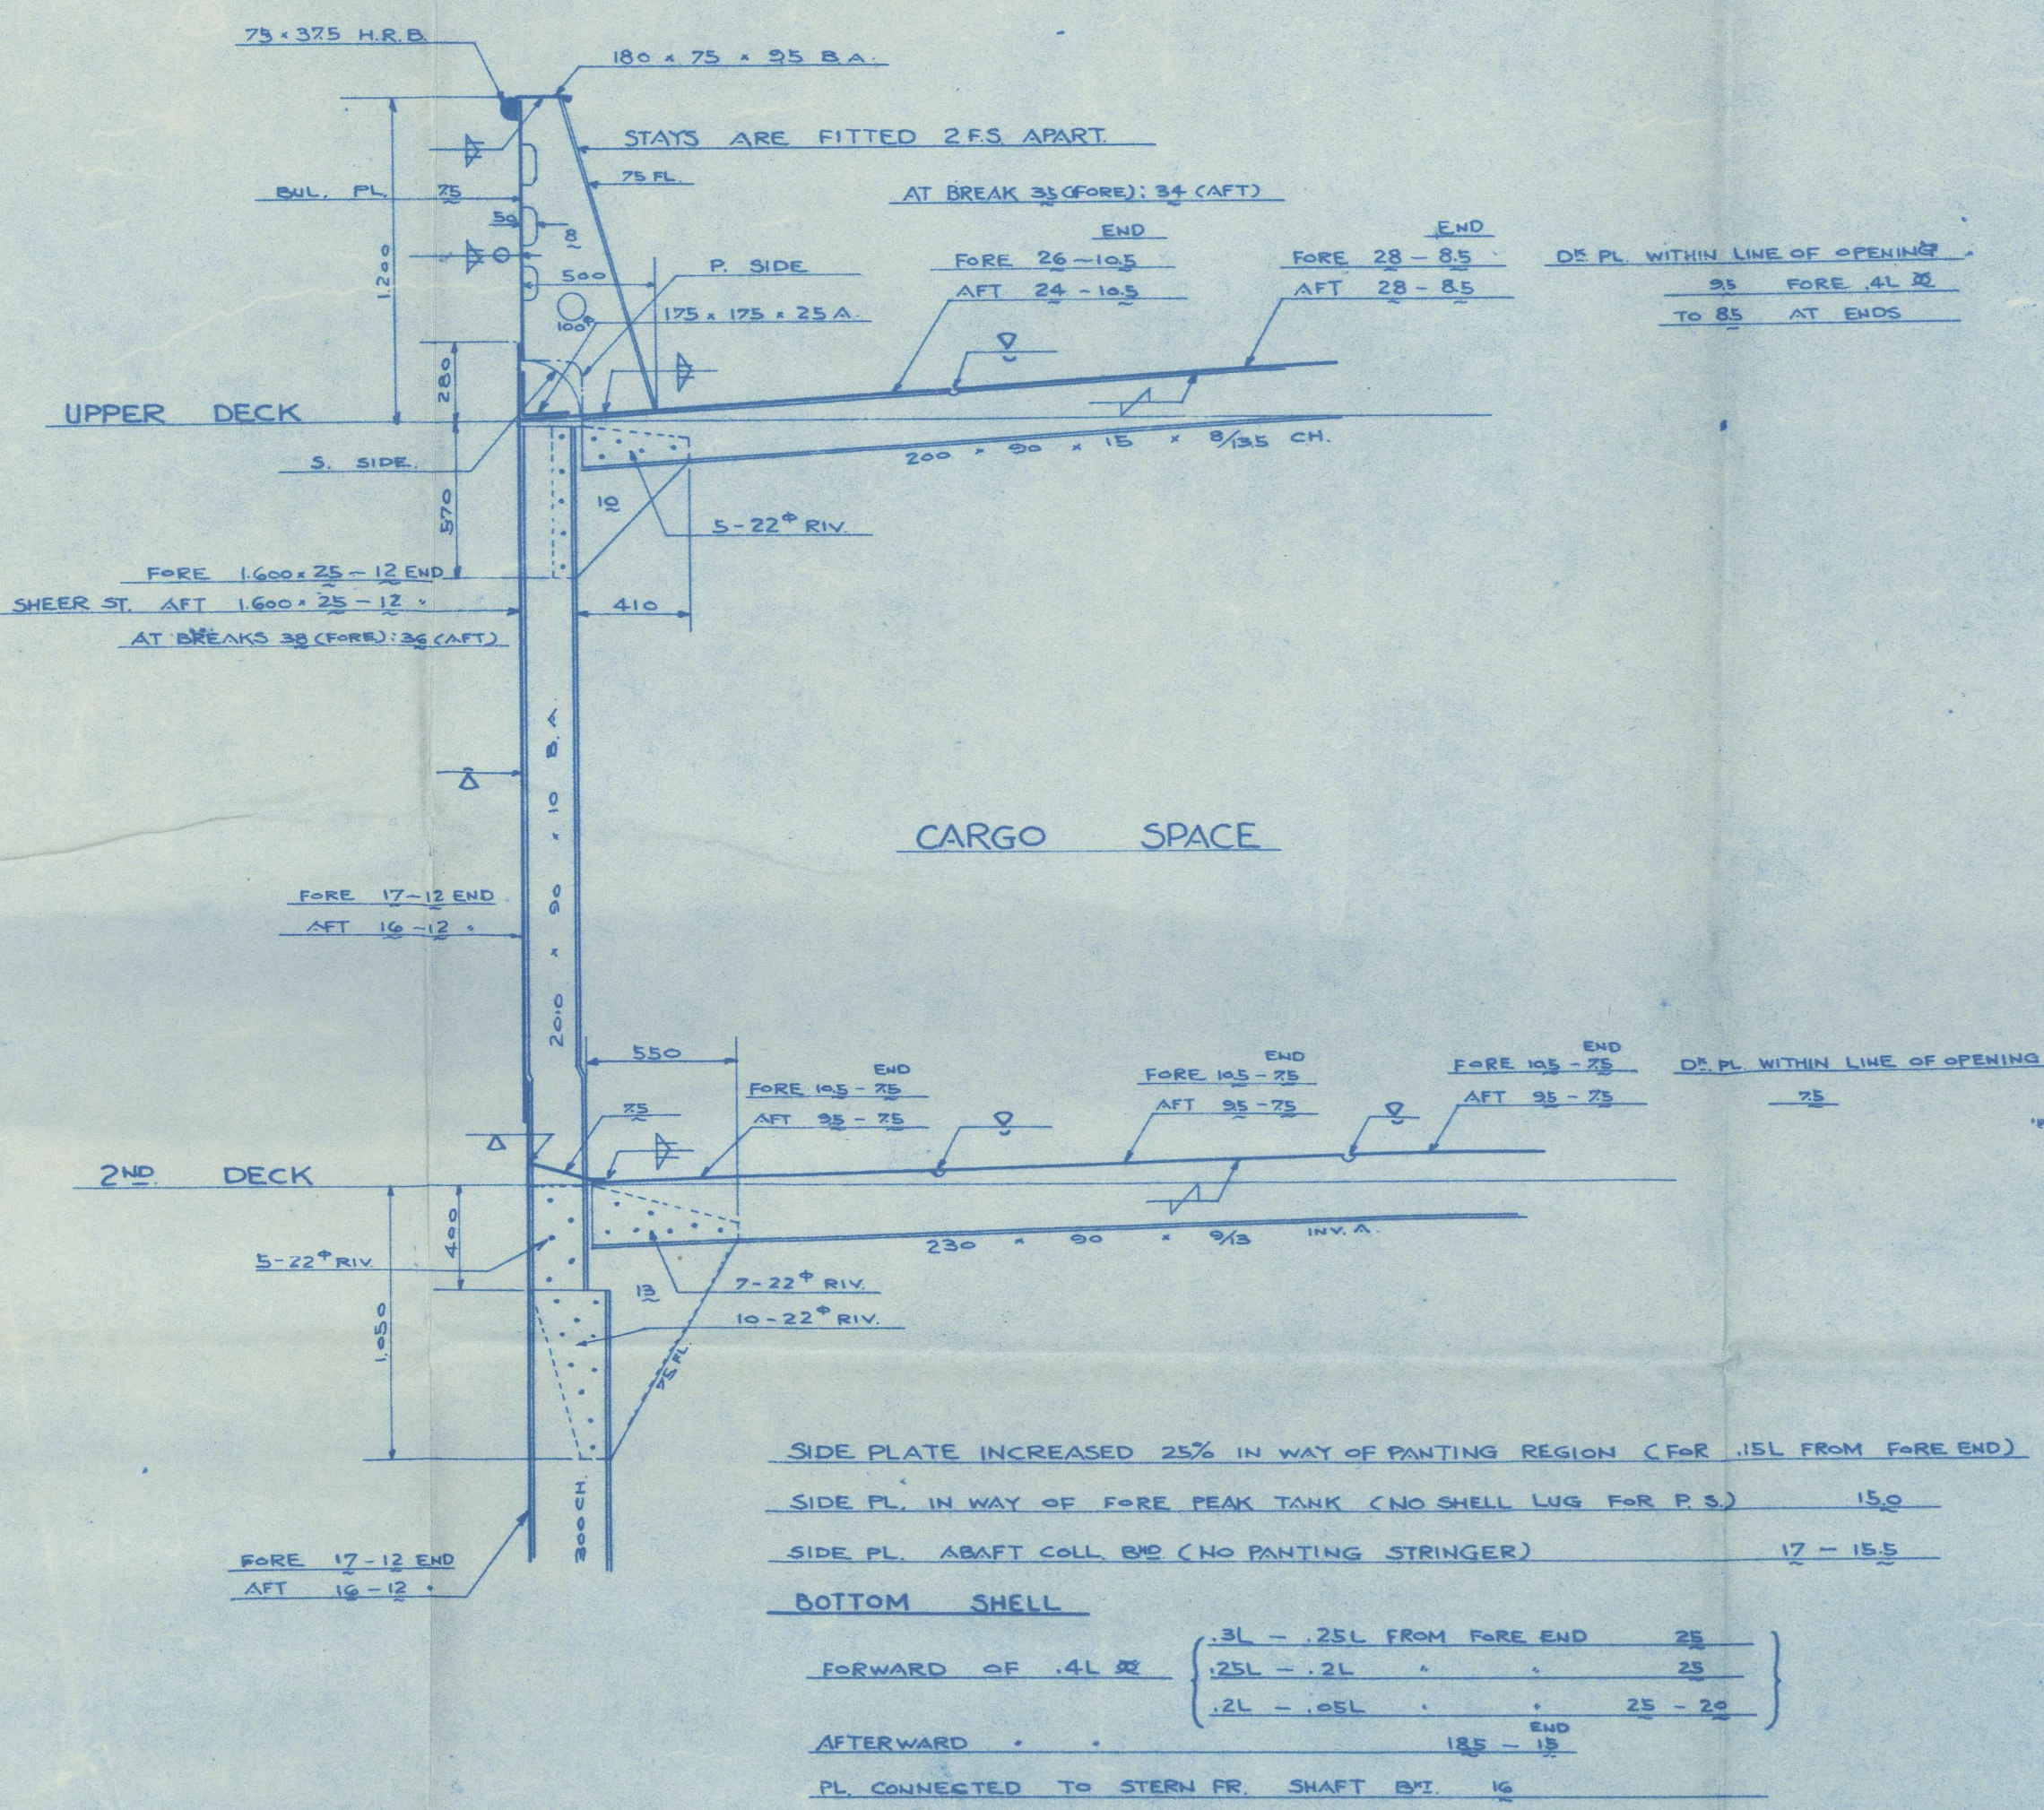


L.R. CLASS	✦	100A1
N.K. CLASS		N.S. ✧

<u>EQUIPMENT</u>		
3 - BOWER	ANCHORS	STOCKLESS
1 - STREAM	ANCHOR	ORDINARY
CHAIN	CABLE	CAST TEST
STREAM	STEEL WIRE	(6-24 716 ORAD 2)
TOW LINE	STEEL WIRE	
HAWKERS	2 MANILA	
WARRPS	2 MANILA	



<u>EQUIPMENT</u>	<u>NUMBER</u>	
L. (B. + D)	140 + (10 + 105)	430.00
FELW	11.23, 23, 75	4.37
	1.40, 2.45, .80	4.72
REIDGE	61.69, 2.45, .72	118.19
POOP	7.07, 2.30, 7.2	12.20
REIDGE D2 HOUSE	28.60, 236, 70	89.37
UPP RW D2 HOUSE	28.60, 245, 30	34.30
BOAT D2 HOUSE	27.60, 2.45, 5.20	33.81
		METRIC UNIT = 377.96

<u>PRINCIPAL</u>		<u>DIMENSIONS</u>	
LENGTH	PP	M	152.00 (497' 3.4")
BREADTH	WIP	M	19.00 (62' 3.4")
DEPTH	TO UPPER DECK	M	10.50 (34' 4.5")
DEPTH	TO BRIDGE DECK	M	12.95 (42' 4.9")
DRAFT	(FROM TOP OF KEEL)	M	8.34 (27' 5.3")
*			
<u>FRAME</u>		<u>SPACE</u>	
BOTH PEAKS		M	0.00
2L FROM FORE END	- COLL. STD	M	0.00
ELSEWHERE		M	0.00

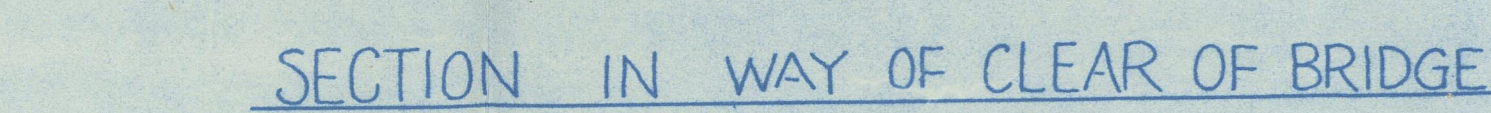

(SECTION AT F.NR 46)

HEIGHT OF OVER FLOW PIPE ABOVE CROWN OF TANK 8.M

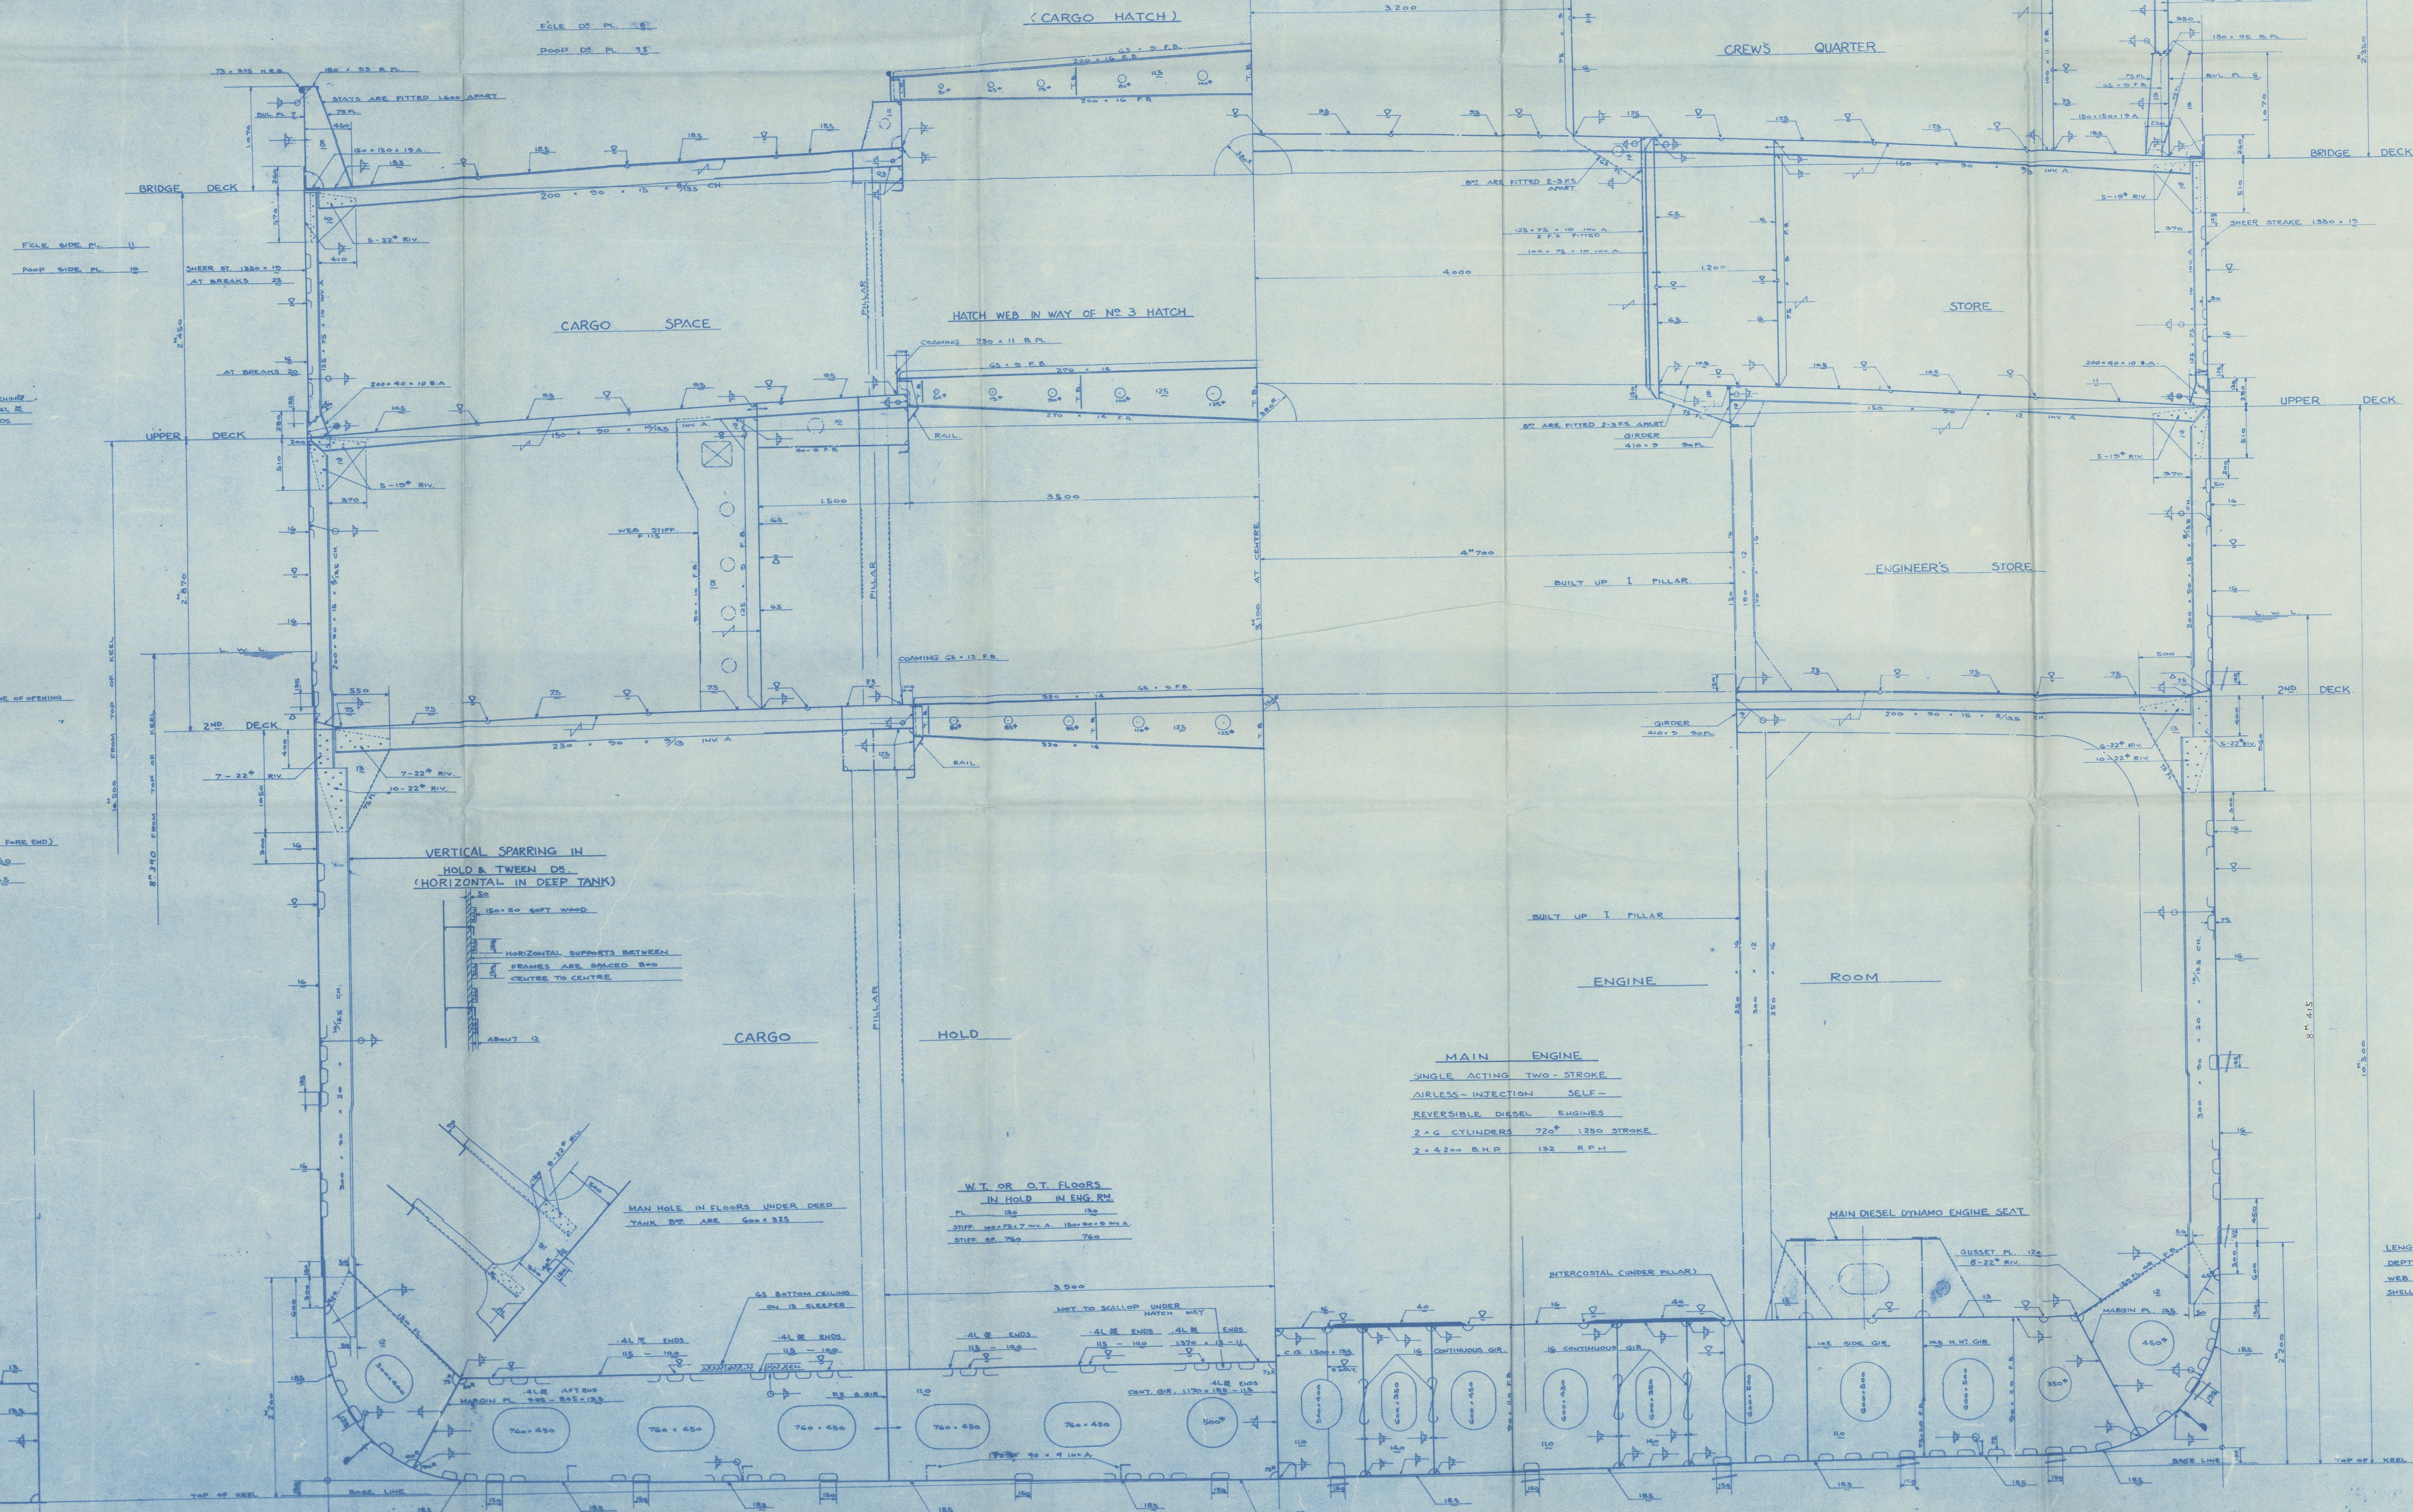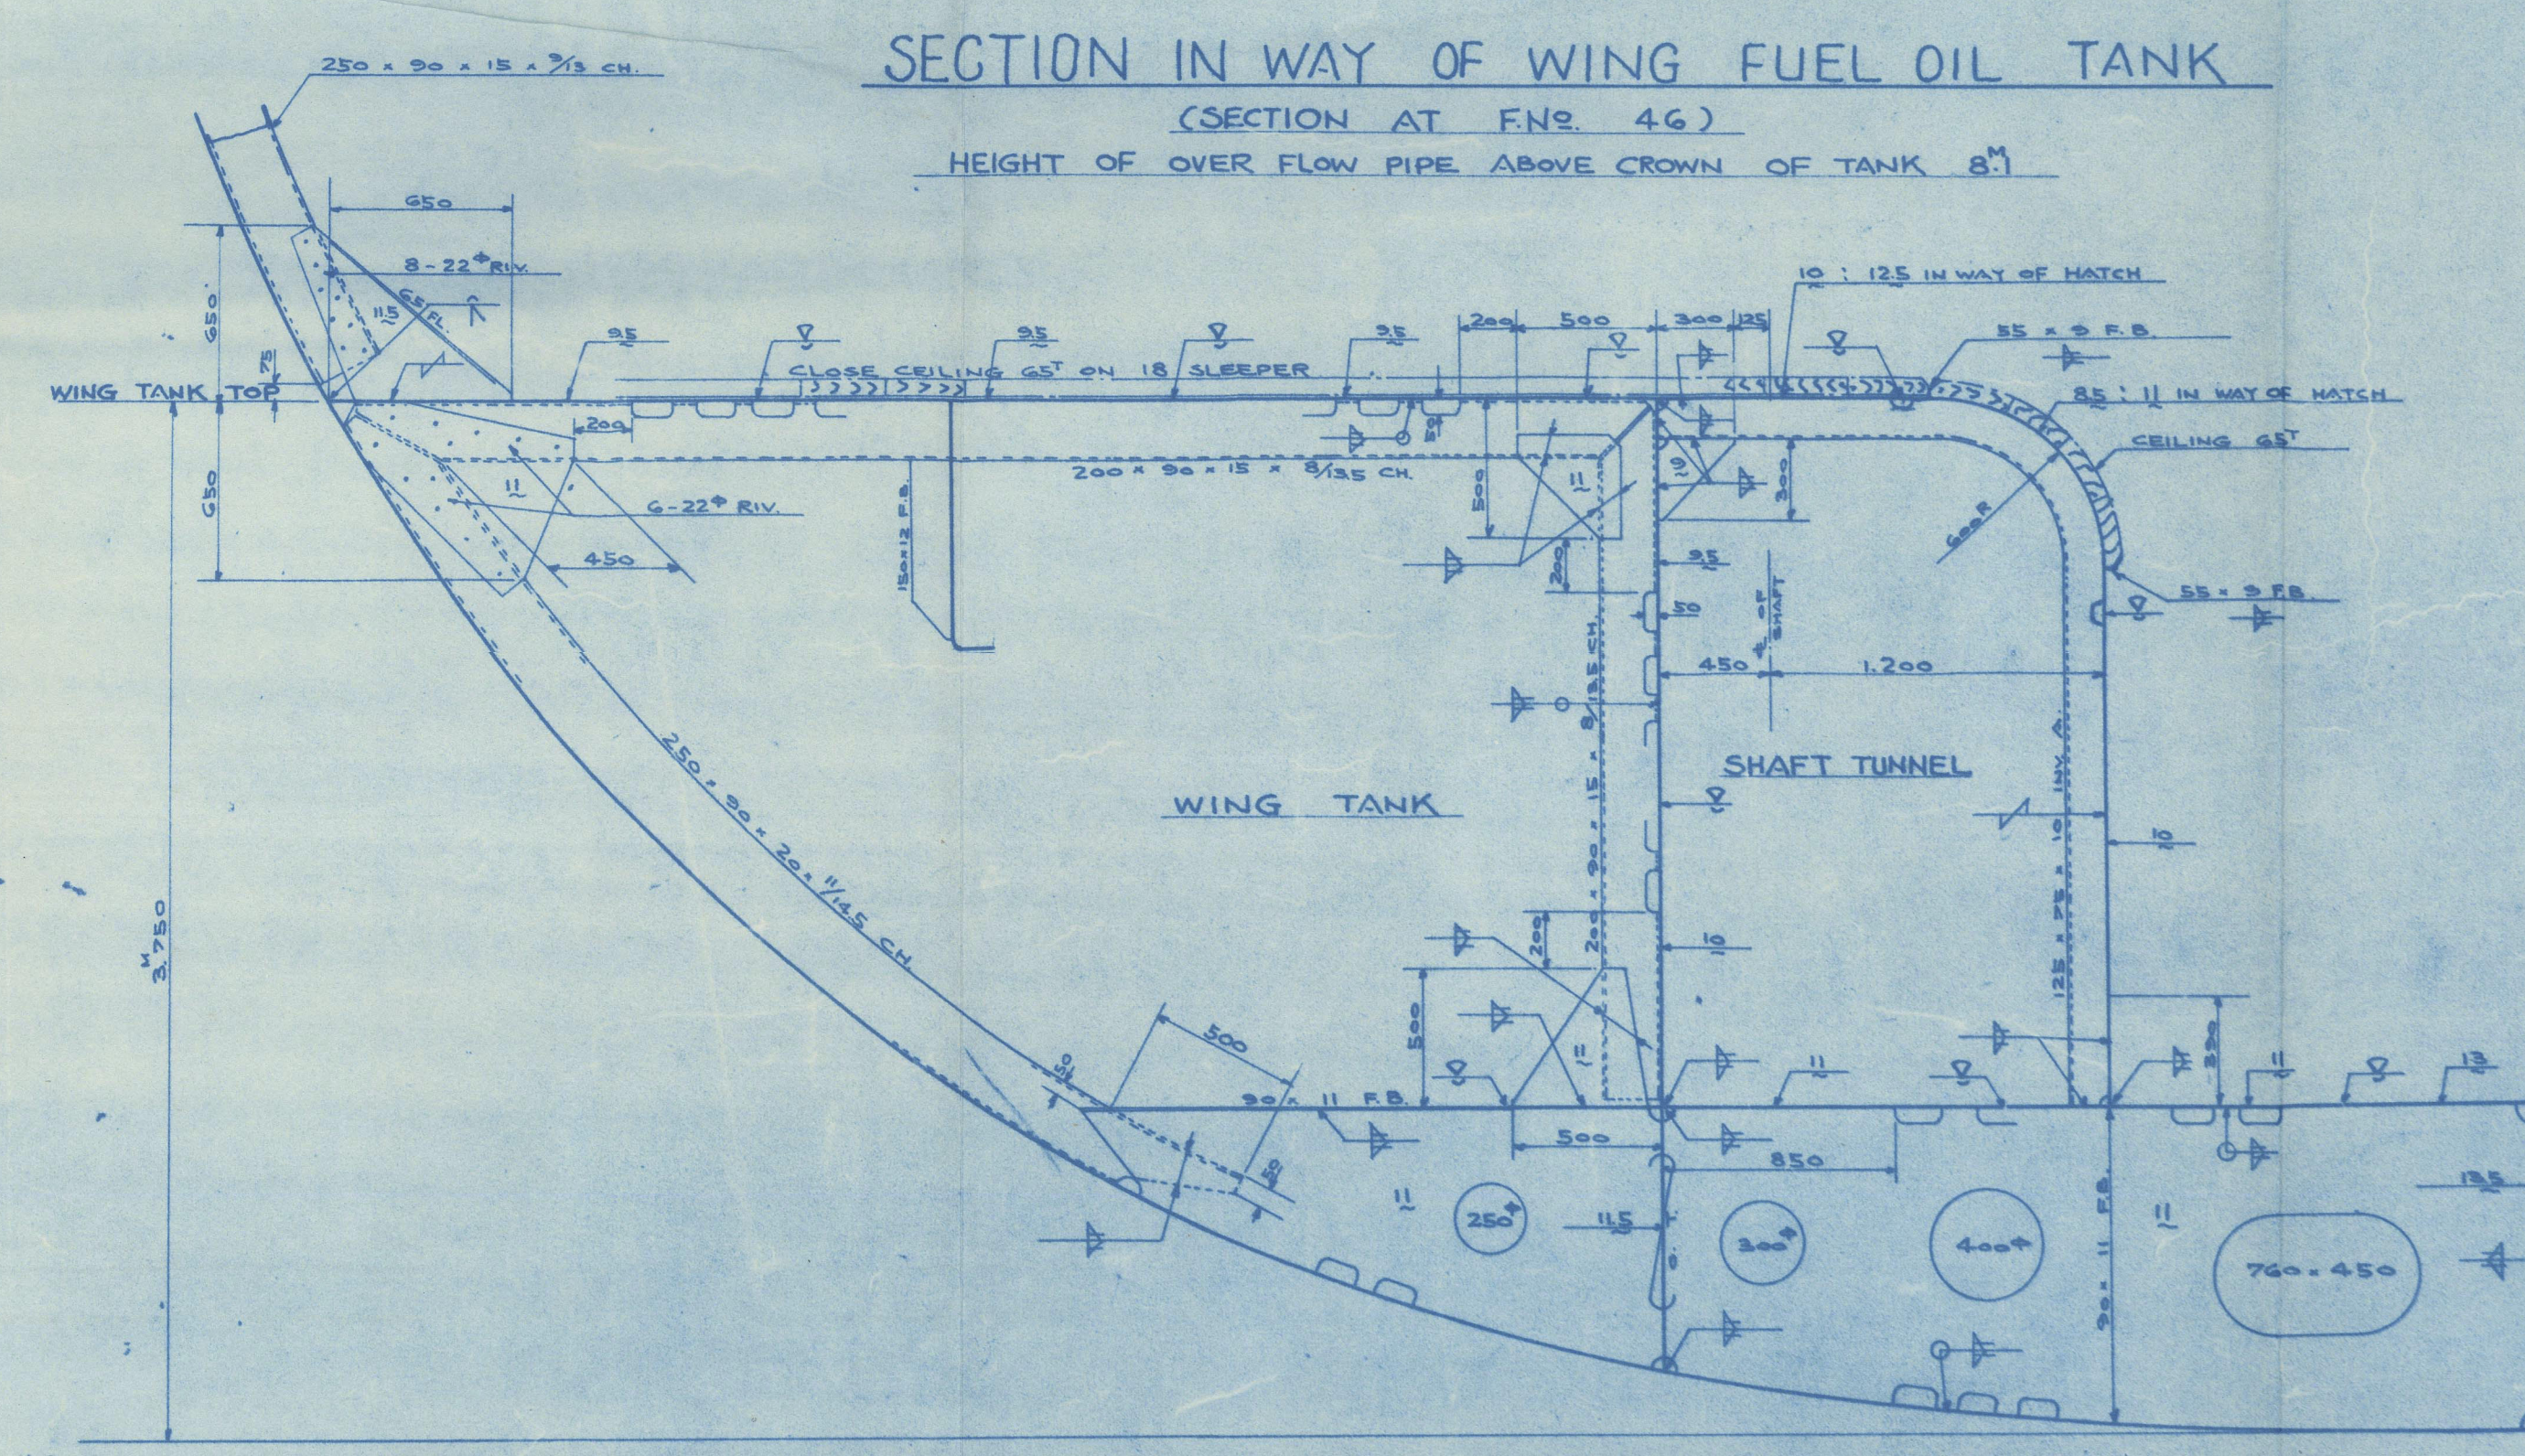

MITSUBISHI	KAIUN
VICTORIA	MARU

MIDSHIP SECTION

(FINISHED PLAN)

DIMENSION 14 00x190x105

SCALE	1 : 25	CLASS	L N	R K
-------	--------	-------	--------	--------

HULL DESIGNING SECTION
SHIP DESIGNING DEPARTMENT
NABASAKI WORKS

CHIEF OF DEPT. _____
CHIEF T. Kabane

HEAD Y. Matsuta
CHECKED Y. Matsuta

CHECKED
DRAWN
DATE REG NO

MITSUBISHI ZOSEN KABUSHIKI KAISHA
TOKYO JAPAN



SHIP No. 1437

012888-012897-0182

"VICTORIA TARU" ★

Midship section
(as fitted)

RECORDS DEPT.
LONDON.

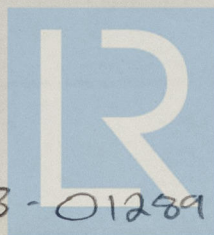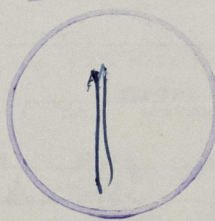

© 2021

Lloyd's Register
Foundation

012888-012897-0182

1
2
VICTORIA MARU

MIDSHIP SECTION

(FINISHED PLAN)

DIMENSION 14 00 x 19 0 x 10 5

SCALE 1 : 25 CLASS L.R.

HULL DESIGNING SECTION
SHIP DESIGNING DEPARTMENT
NAGASAKI WORKS

CHIEF OF DEPT. *T. Okabe*

CHIEF *T. Okabe*

HEAD *Y. Matsuda*

CHECKED *Y. Matsuda*

DRAWN

DATE REG NO.



1
2
SHIP NO. 1437

DSN NO. H-101

Sunk.
Rpt. No. 791

AS FITTED

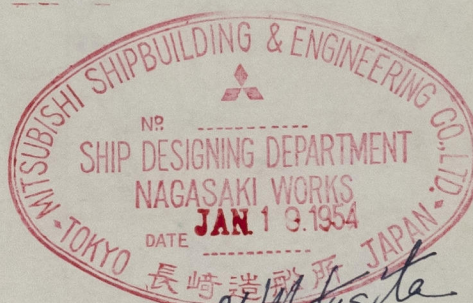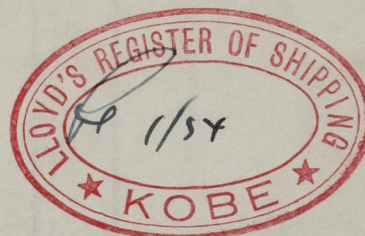

©2021

Lloyd's Register
Foundation

012888-012997-0182