

DRAWING N° 1304/10

TWIN SCREW FERRIES-BIRKENHEAD

GENERAL ARRANGEMENT




PROFILE & PROMENADE DECK

SCALE: $\frac{1}{4}$ = 1 FOOT

LONDON COPY



SHOWING COAMINGS FOR
CONSIDERATION OF
FREEBOARD

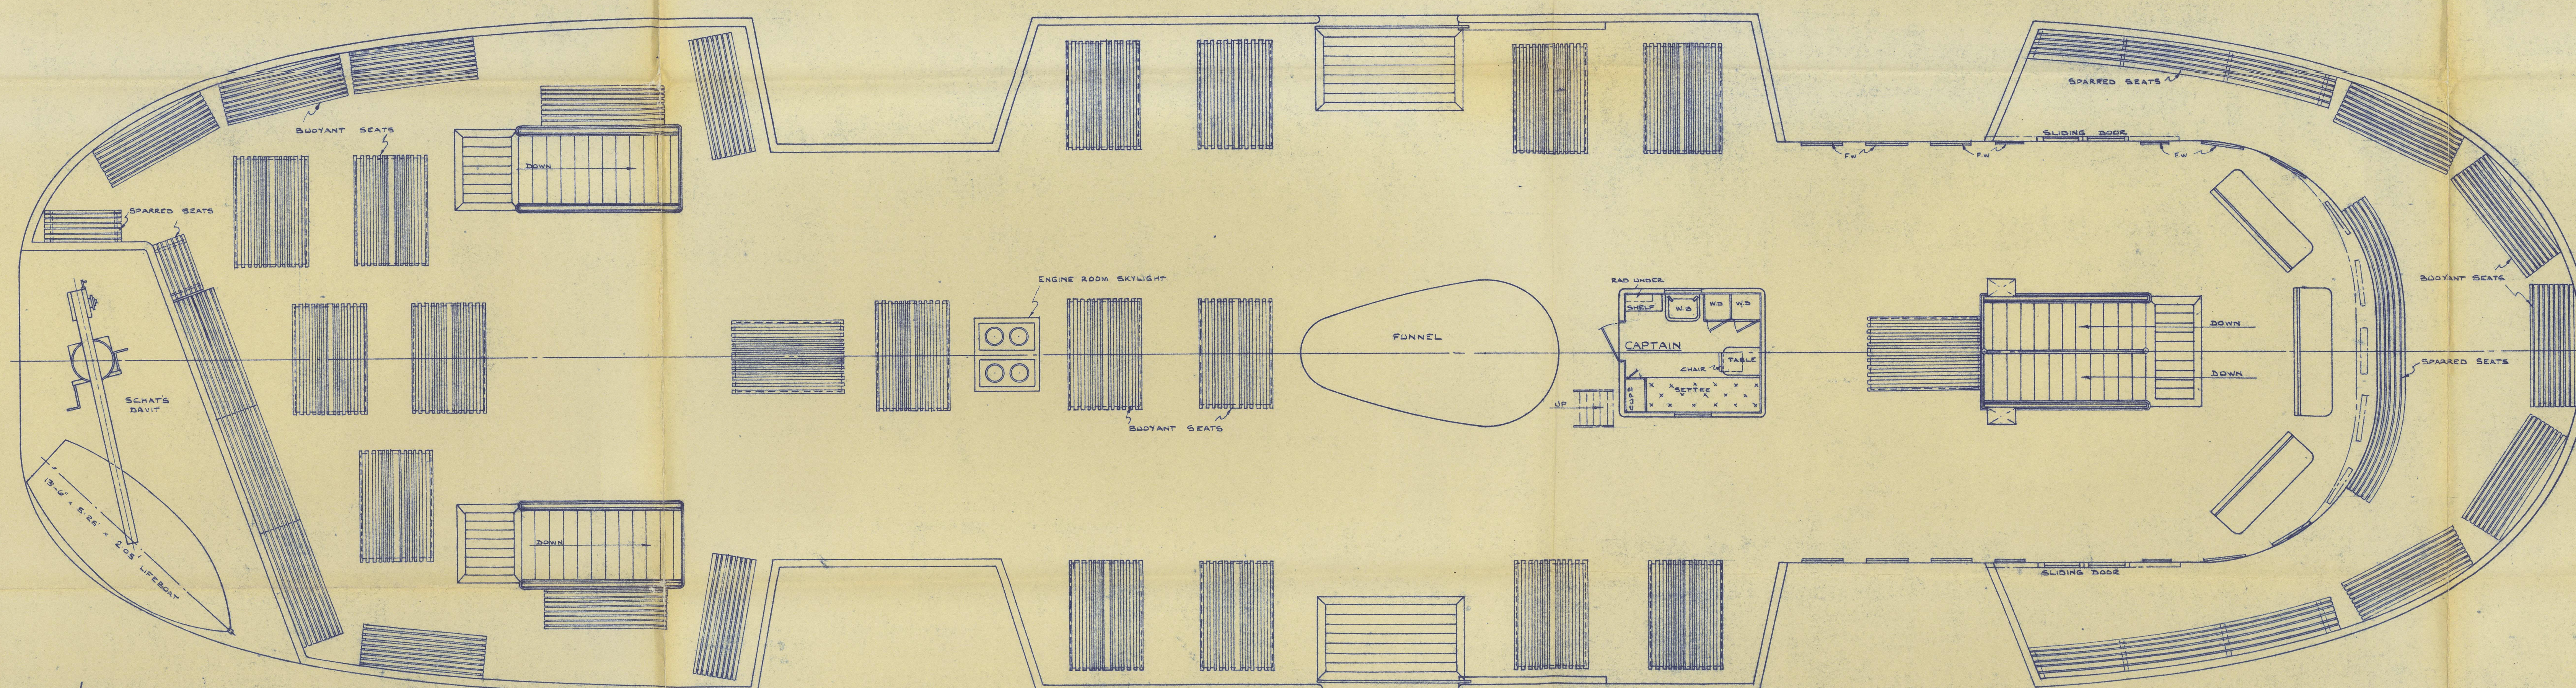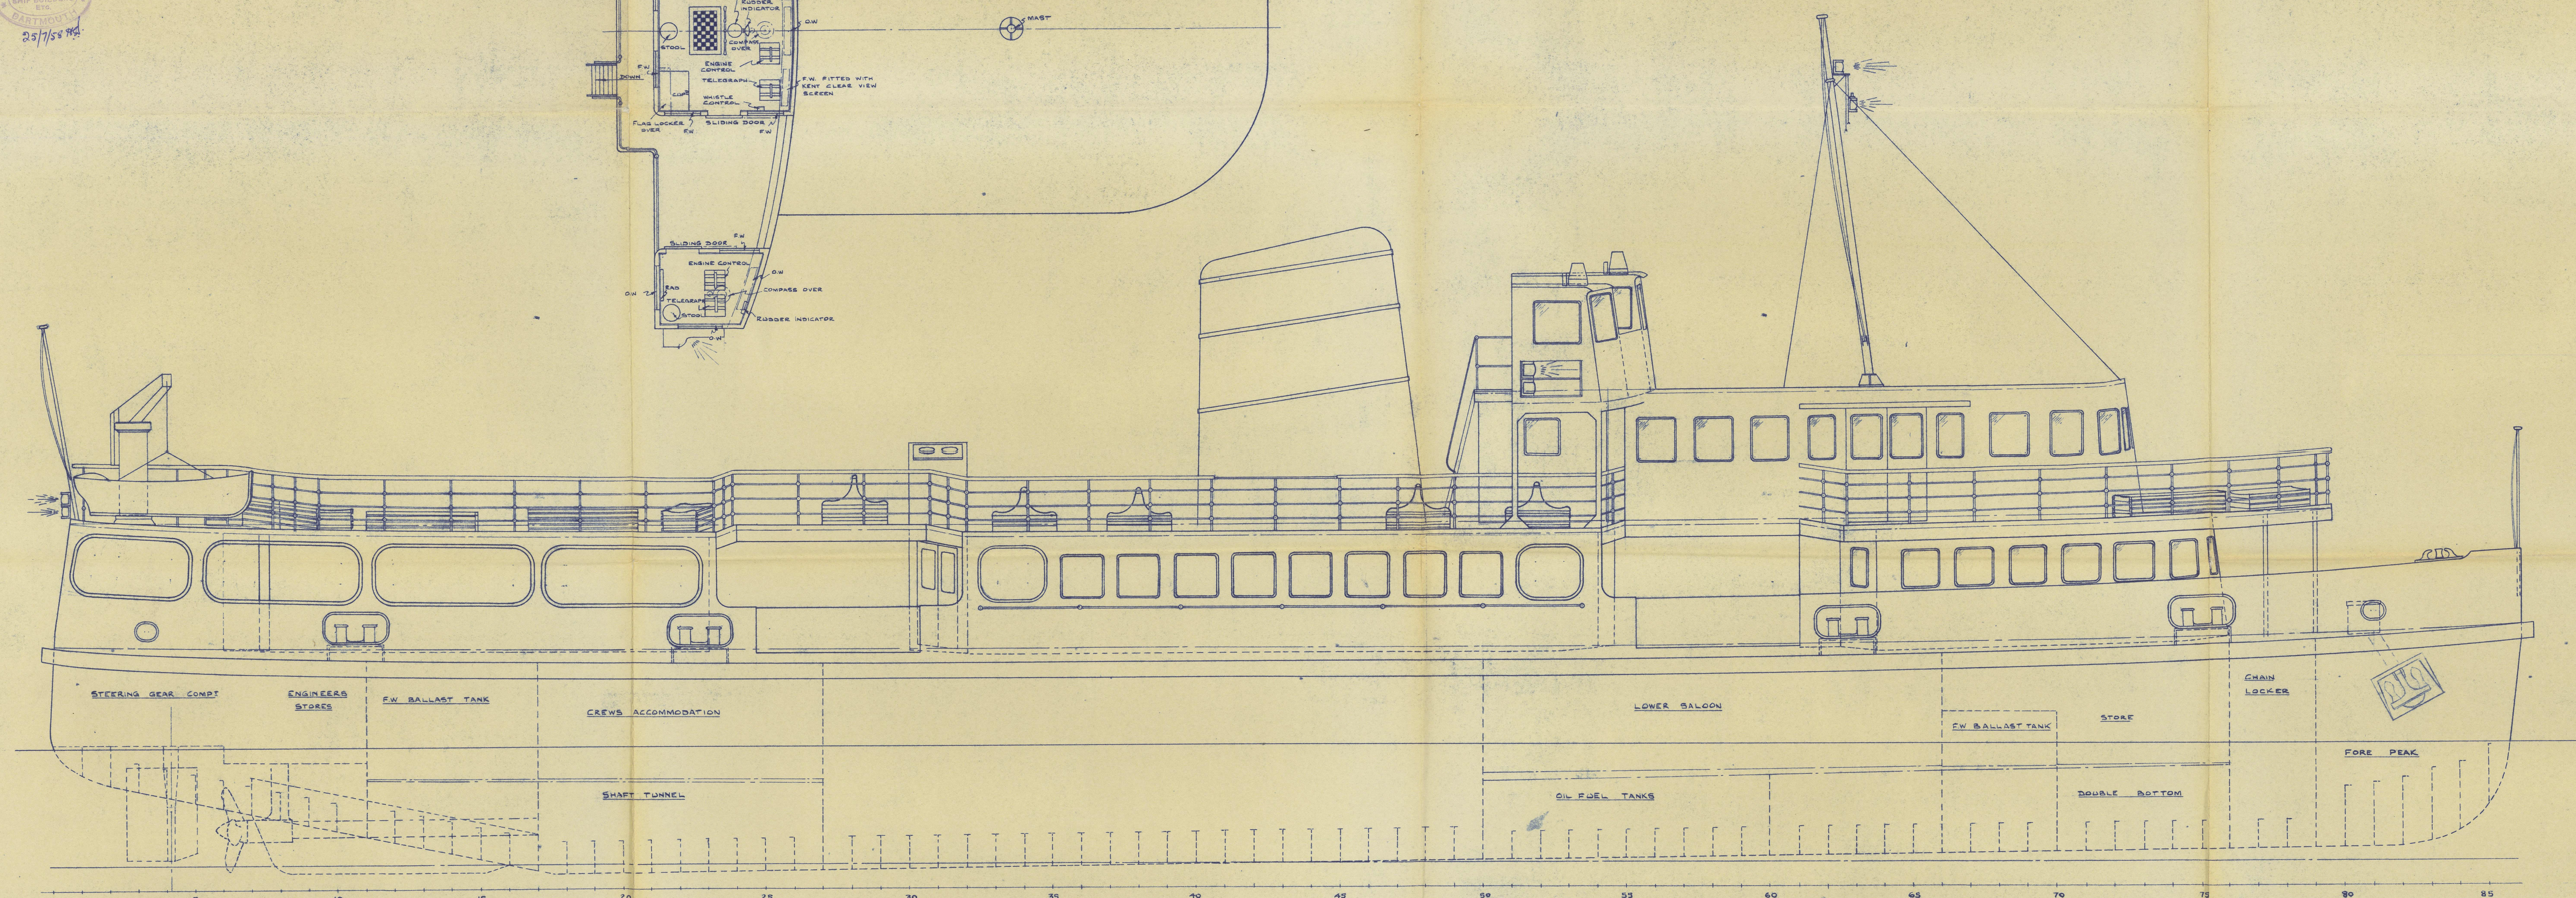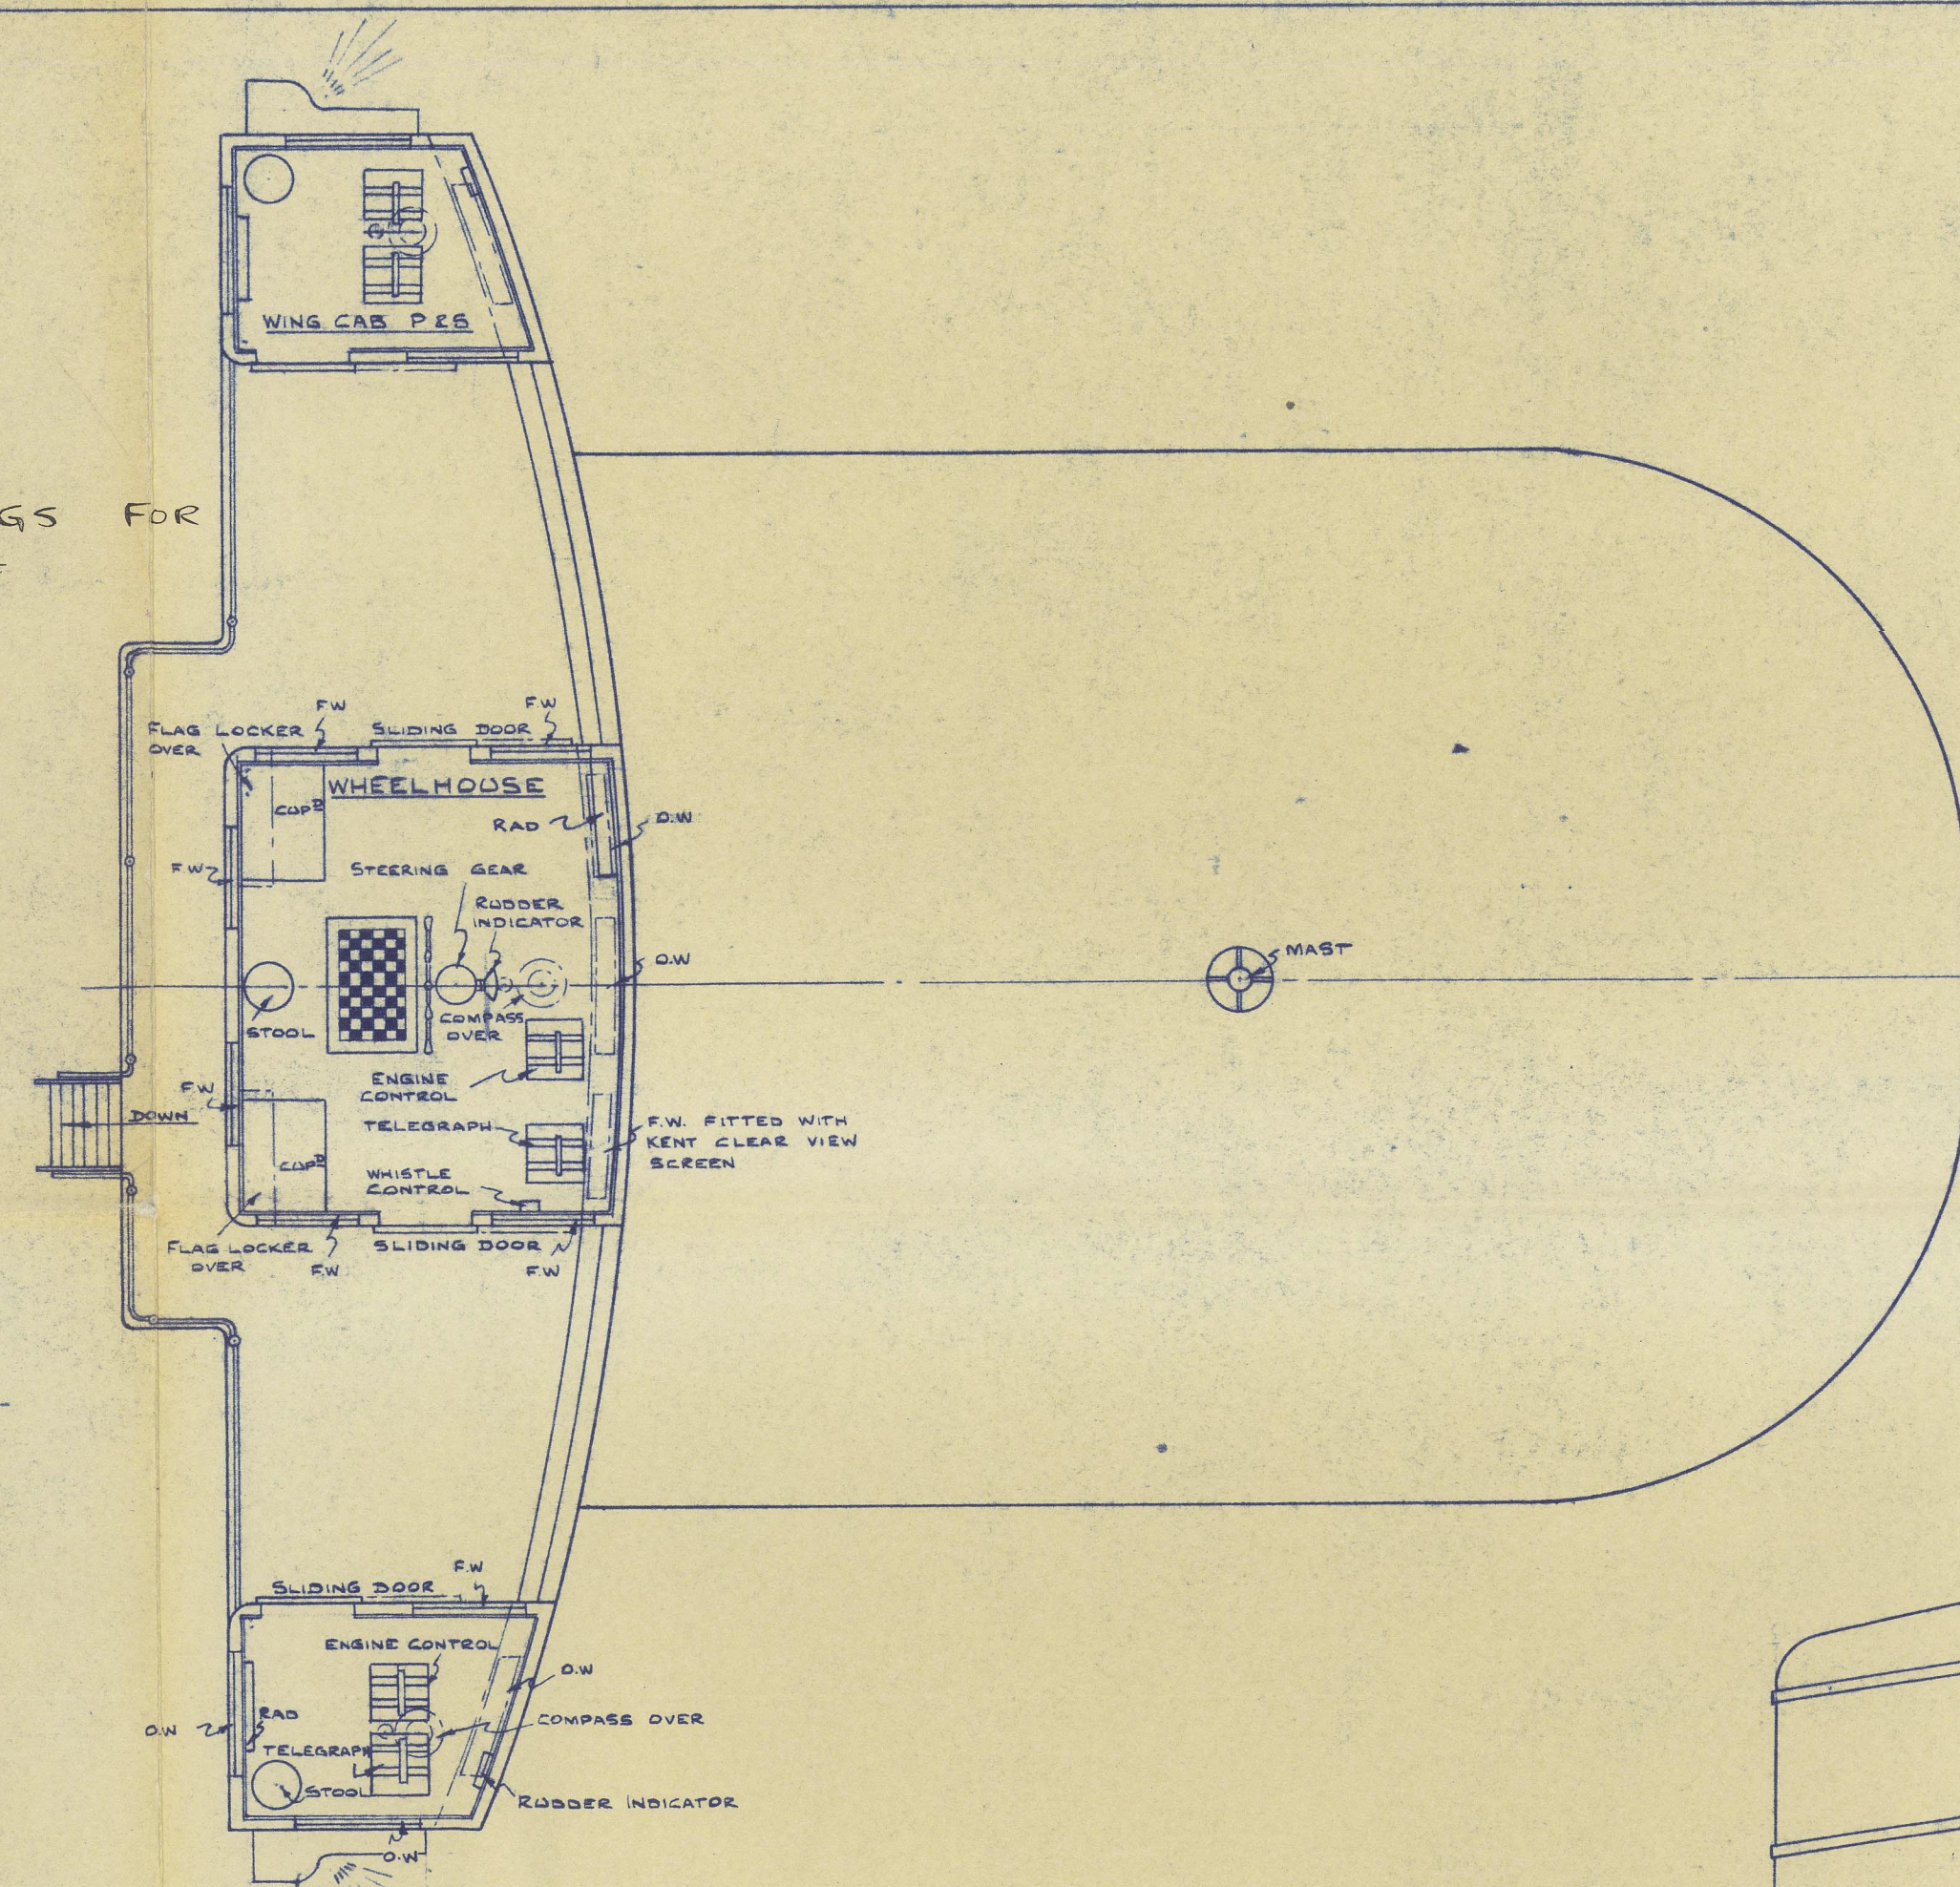

ar
P.P.58

YARD N° 1304/5

013027-013039-0046