

DRAWING N° 1304/11.



TWIN SCREW FERRIES - BIRKENHEAD.

GENERAL ARRANGEMENT.

MAIN & LOWER DECKS, SHOWING COAMINGS FOR CONSIDERATION OF FREEBOARD

SCALE: $\frac{1}{4}$ " = 1 FOOT.
LONDON COPY

NOTE! HEIGHTS OF COAMINGS ARE GIVEN ABOVE WOOD DECK
AIR PIPES TO HAVE 36" COAMINGS ABOVE STEEL DECK
ALL AIR PIPES KEPT IN WATERWAYS
Efficient means to be provided for closing of openings of all air pipes

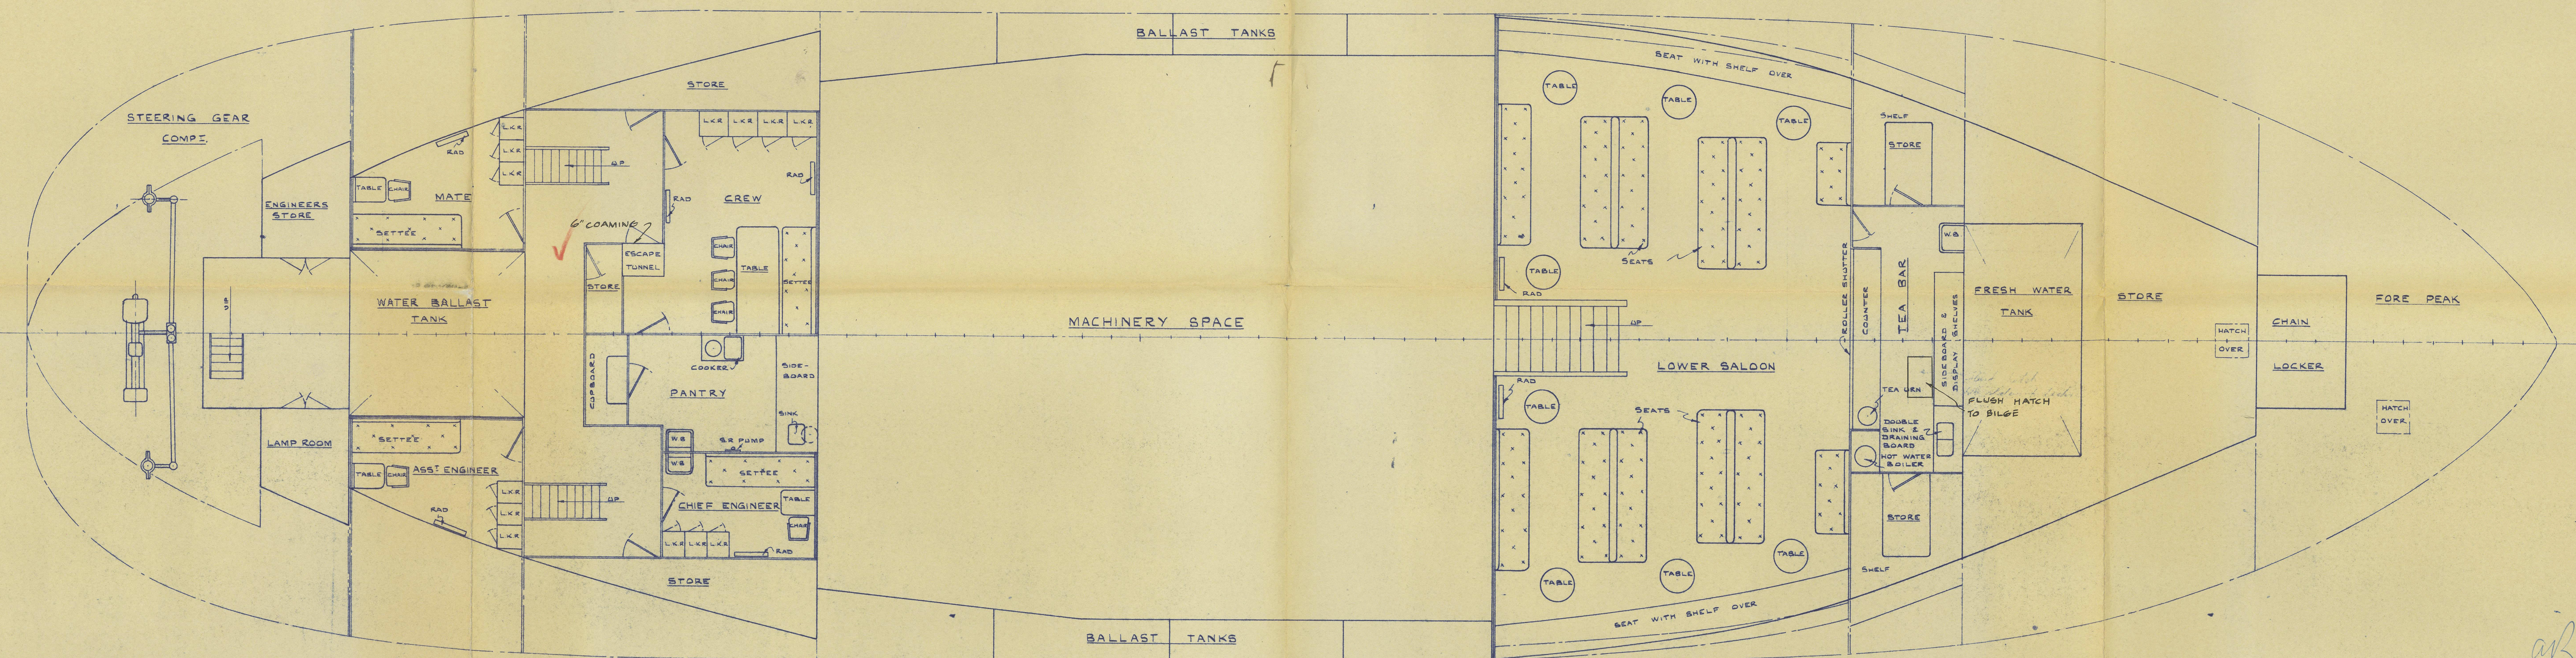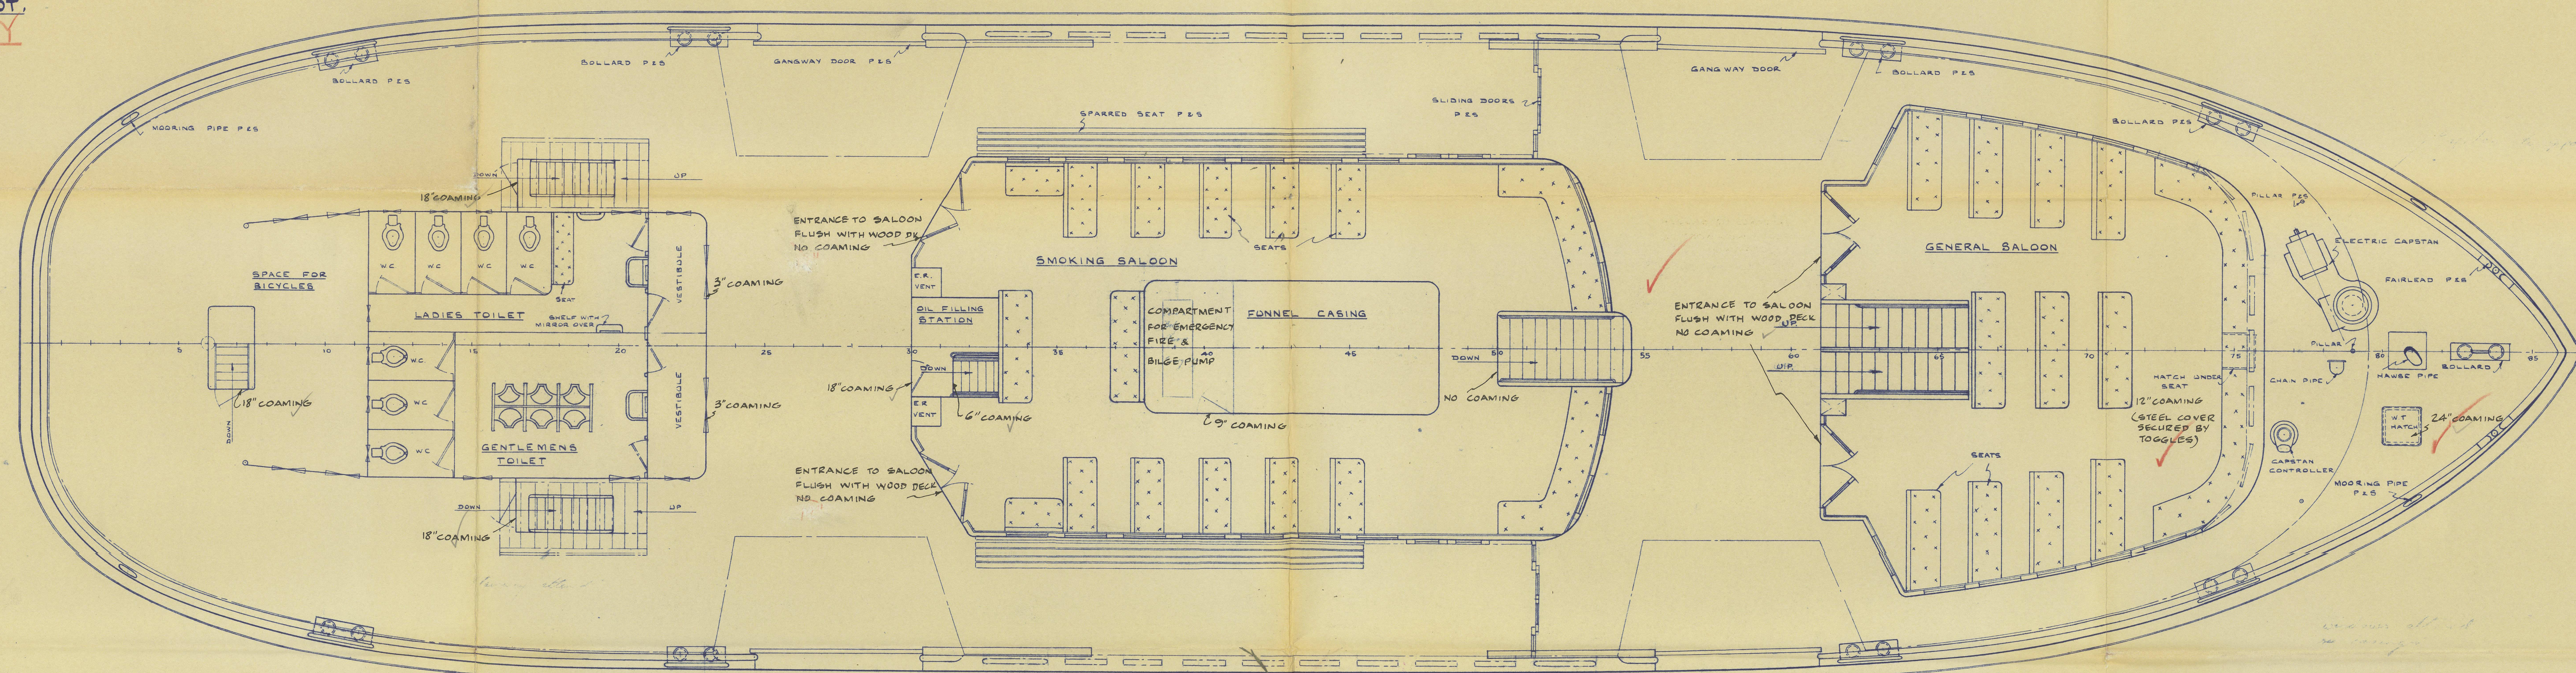

YARD N° 1304/5

ar
8.8.58