

20 NOV 1999

32998

Rpt. C. 11 (Contd.)

Index No.

Lloyd's Register of Shipping.


Ship's Name M.V. " PORT WAIKATO "

Official No. 160675

Memorandum of alterations reported since ship was surveyed for assignment of Load Lines in Port of DUNEDIN, N.Z.

ALTERATIONS & ADDITIONS:- Crew's Quarters, Forecastle,

On Main Deck, Forecastle
Accommodation was altered on Starboard side to increase space in way of Crew's Messroom, being extended inboard a distance of 2'-3¹/₂" as shown by shaded portion of sketch. Original steel door for Messroom on Starboard side of recess being refitted.

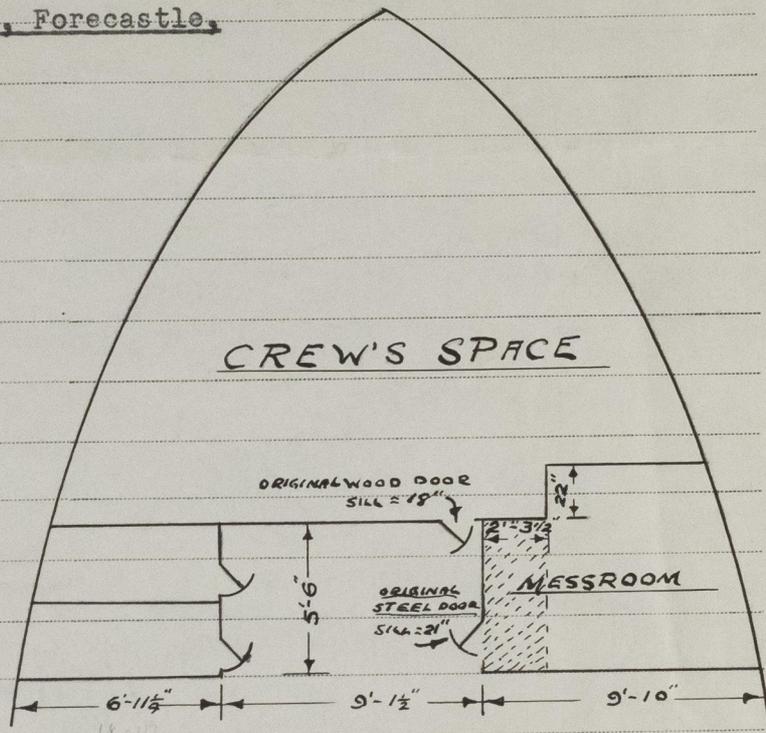

W. W. Martin

SURVEYOR.

012057-1012062-0263



© 2021

Lloyd's Register Foundation