


SCALE 1" = 1 FOOT.




~~DRAFT M.L.D. 9'-2 $\frac{1}{2}$ ". FULL 9'-8 $\frac{1}{2}$ ".~~

FRAME SPACING	
0-3	1'-7"
3-17	1'-7½"
17-35	1'-7¾"
35-For ⁰	1'-7½"

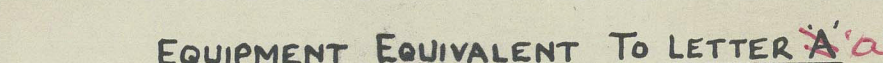


- ### OWNER'S REQUIREMENTS.

FOR U.K. & EIRE SERVICE

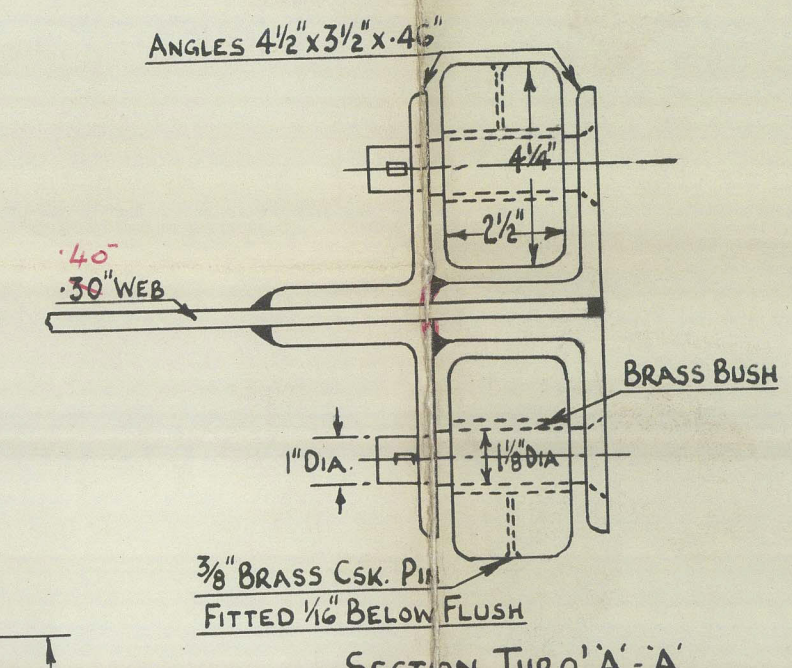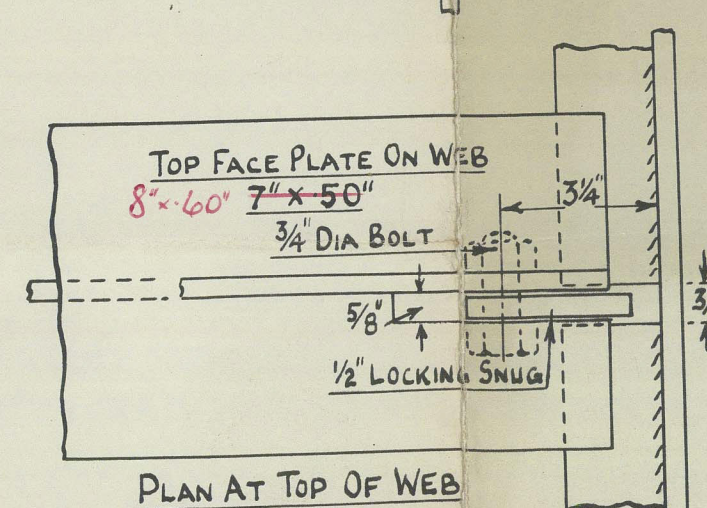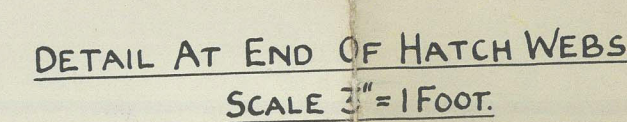

SECTION THRO' 'A' - 'A'

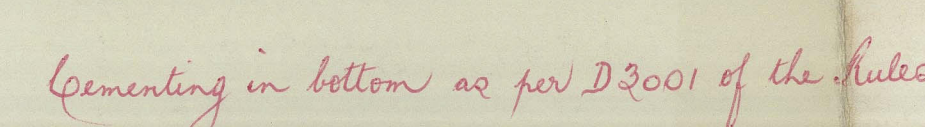

4" x 5 1/4" F.B. bottom shell stiffeners
Fitted as per D708 of the Rule

APPROVED
LLOYDS REGISTER OF SHIPPING

Date 27/12/62

013224-013231-0179

SCOTTS N° 695


M/V. "RAYLIGHT"

MIDSHIP SECTION

F.E. REPORT N° 27431

James H. Young

RECORDS DEPT
LONDON

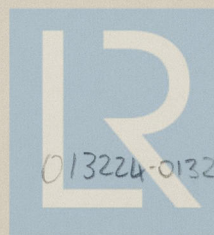

© 2021

Lloyd's Register
Foundation

013224-013231-0178