

SHIP No 695.  
SINGLE SCREW MOTOR COASTER.  
STEEL STRUCTURE.

SCALE  $\frac{1}{4}$ " = 1 FOOT.

DIMENSIONS:- 88'-0" x 20'-10" x 10'-1"


DRAFT TO TOP OF BAR KEEL = 9'-2 1/2"

Approved for  
To LLOYDS CLASS 100 A1 FOR SERVICE BETWEEN  
GREENOCK, DUBLIN & SHEEHAVEN (IN IRELAND)  
& BETWEEN GREENOCK & THE WESTERN ISLES.  
U.K. & SIDE SERVICE



This plan has been verified with the approved  
plans, and includes any modifications and/or  
additions to the original plans, and is hereby  
approved for use in accordance with the  
requirements of the LLOYDS REGISTER OF SHIPPING  
Date 27th Decr. 1922.

Approx. 9' 38"  
See letter re  
service limits

 


Any openings not shown on this approved plan  
which may be cut in the hull or shell plating are to  
be properly framed and adequate compensation  
provided to the structural resistance. The loss of structural  
area of longitudinal material is to be restored by  
doubling or increasing thickness of plating in way of  
and around such openings. Adequate compensation is  
also to be fitted for the cutting of other strength  
members in the structure as may be necessary.

APPROVED  
LLOYDS REGISTER OF SHIPPING  
Date 27/12/22



2

SCOTTS NO 695

M/V. "RAYLIGHT" 


STRUCTURAL ARRANGEMENTS

F.E. REPORT NO 27341

*James K. Young*

RECORDS DEPT.  
LONDON

2

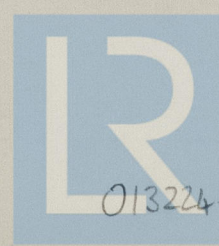

© 2021

Lloyd's Register  
Foundation

013224-013231-0179