


SHIP N° 695.

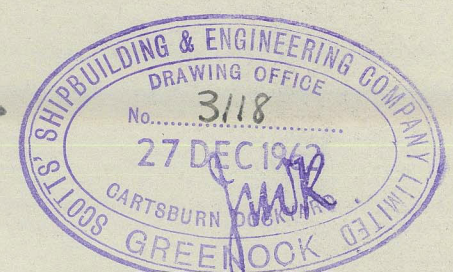

STERNFRAME, RUDDER

AND RUDDER STOCK.

SCALES AS MARKED.

A = 20.25 (INCLUDING BALANCED PORTION)

D = 1.23'

A X D = 24.50

SPEED OF VESSEL 8 1/4 KNOTS.

RADIUS OF RUDDER QUADRANT - $\frac{2-9}{2}$

DIA OF CHAINS - 5/8"

DIA OF RODS - 1 1/16"

DIA OF PROP - 3 1/2"

LENGTH O.A. - 97'-2"

LENGTH B.P. - 88'-0"

BREADTH MLD - 20'-10"



DEPTH MLD - 10'-1"

This plan has been verified with the approved plans and includes any modifications and/or additions to the original plans and arrangements made during construction in accordance with Lloyd's Register of Shipping requirements.
Signature: *[Signature]*
Surveyor to Lloyd's Register of Shipping
Date: 7th OCT. 1963


ALL MATERIALS AND WORKMANSHIP AND TESTS

TO LLOYD'S REQUIREMENTS.


CERTIFICATES TO BE SUPPLIED

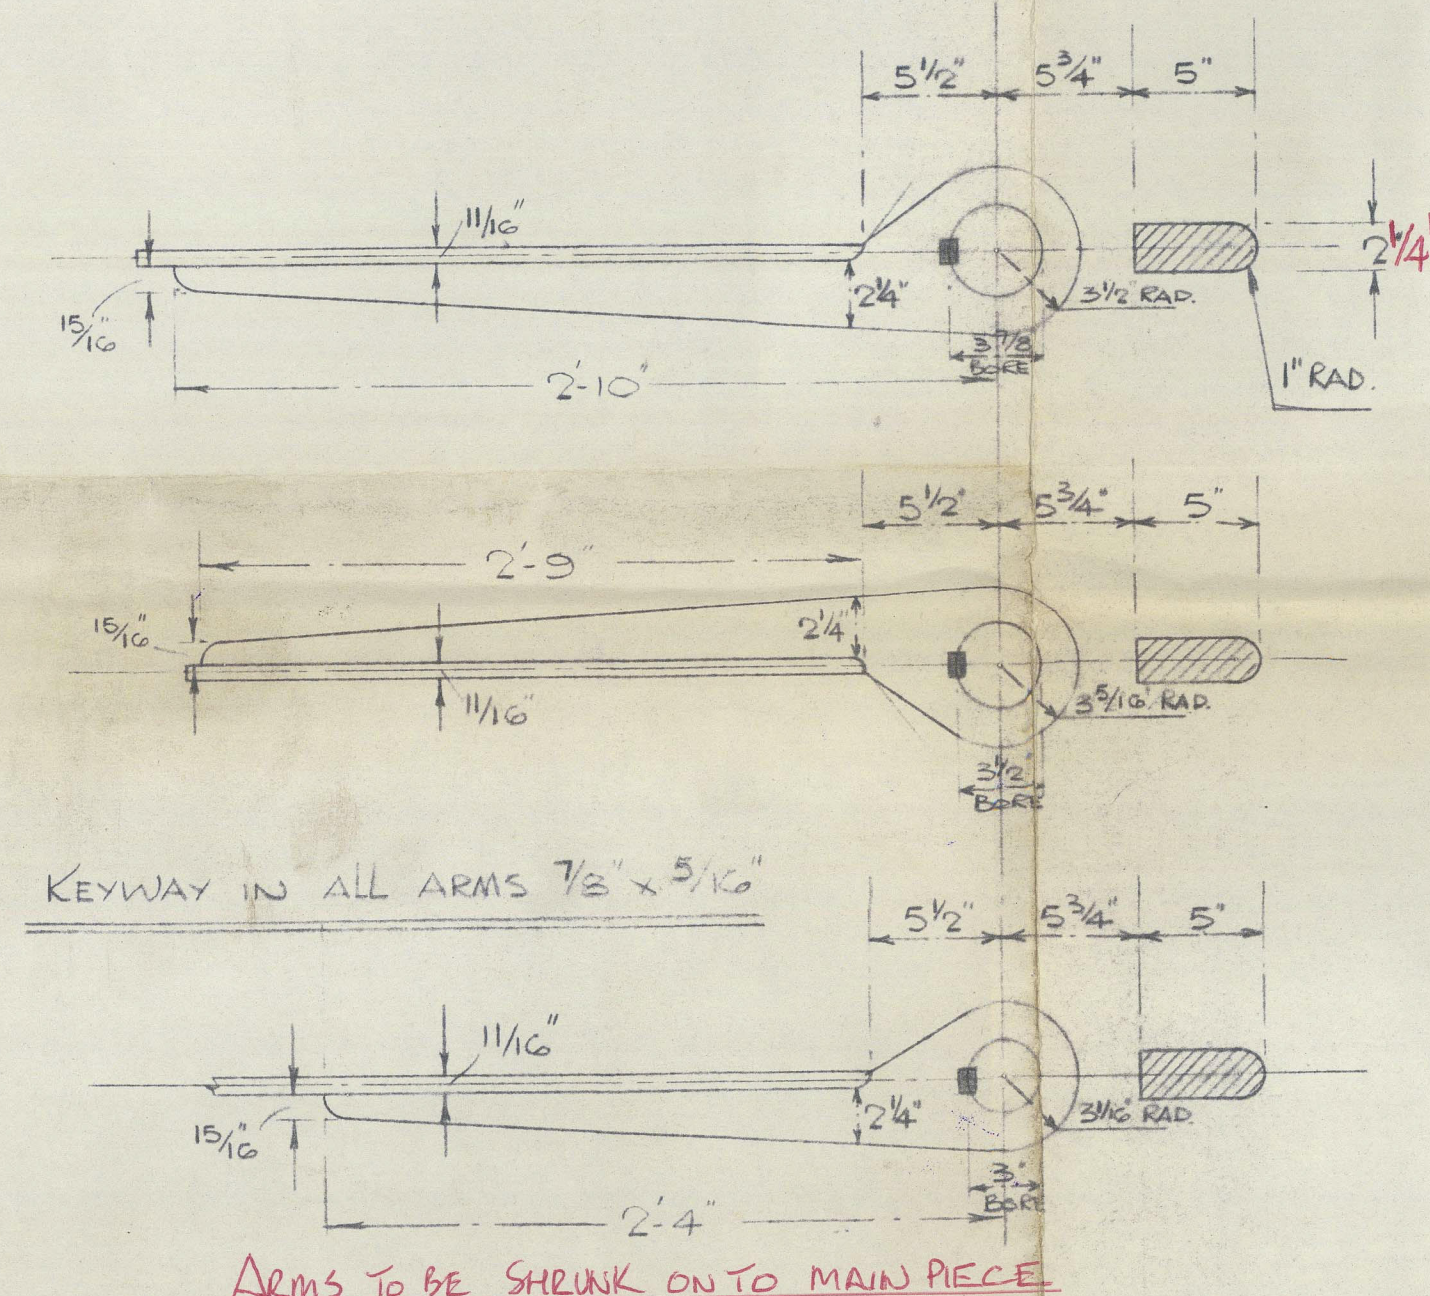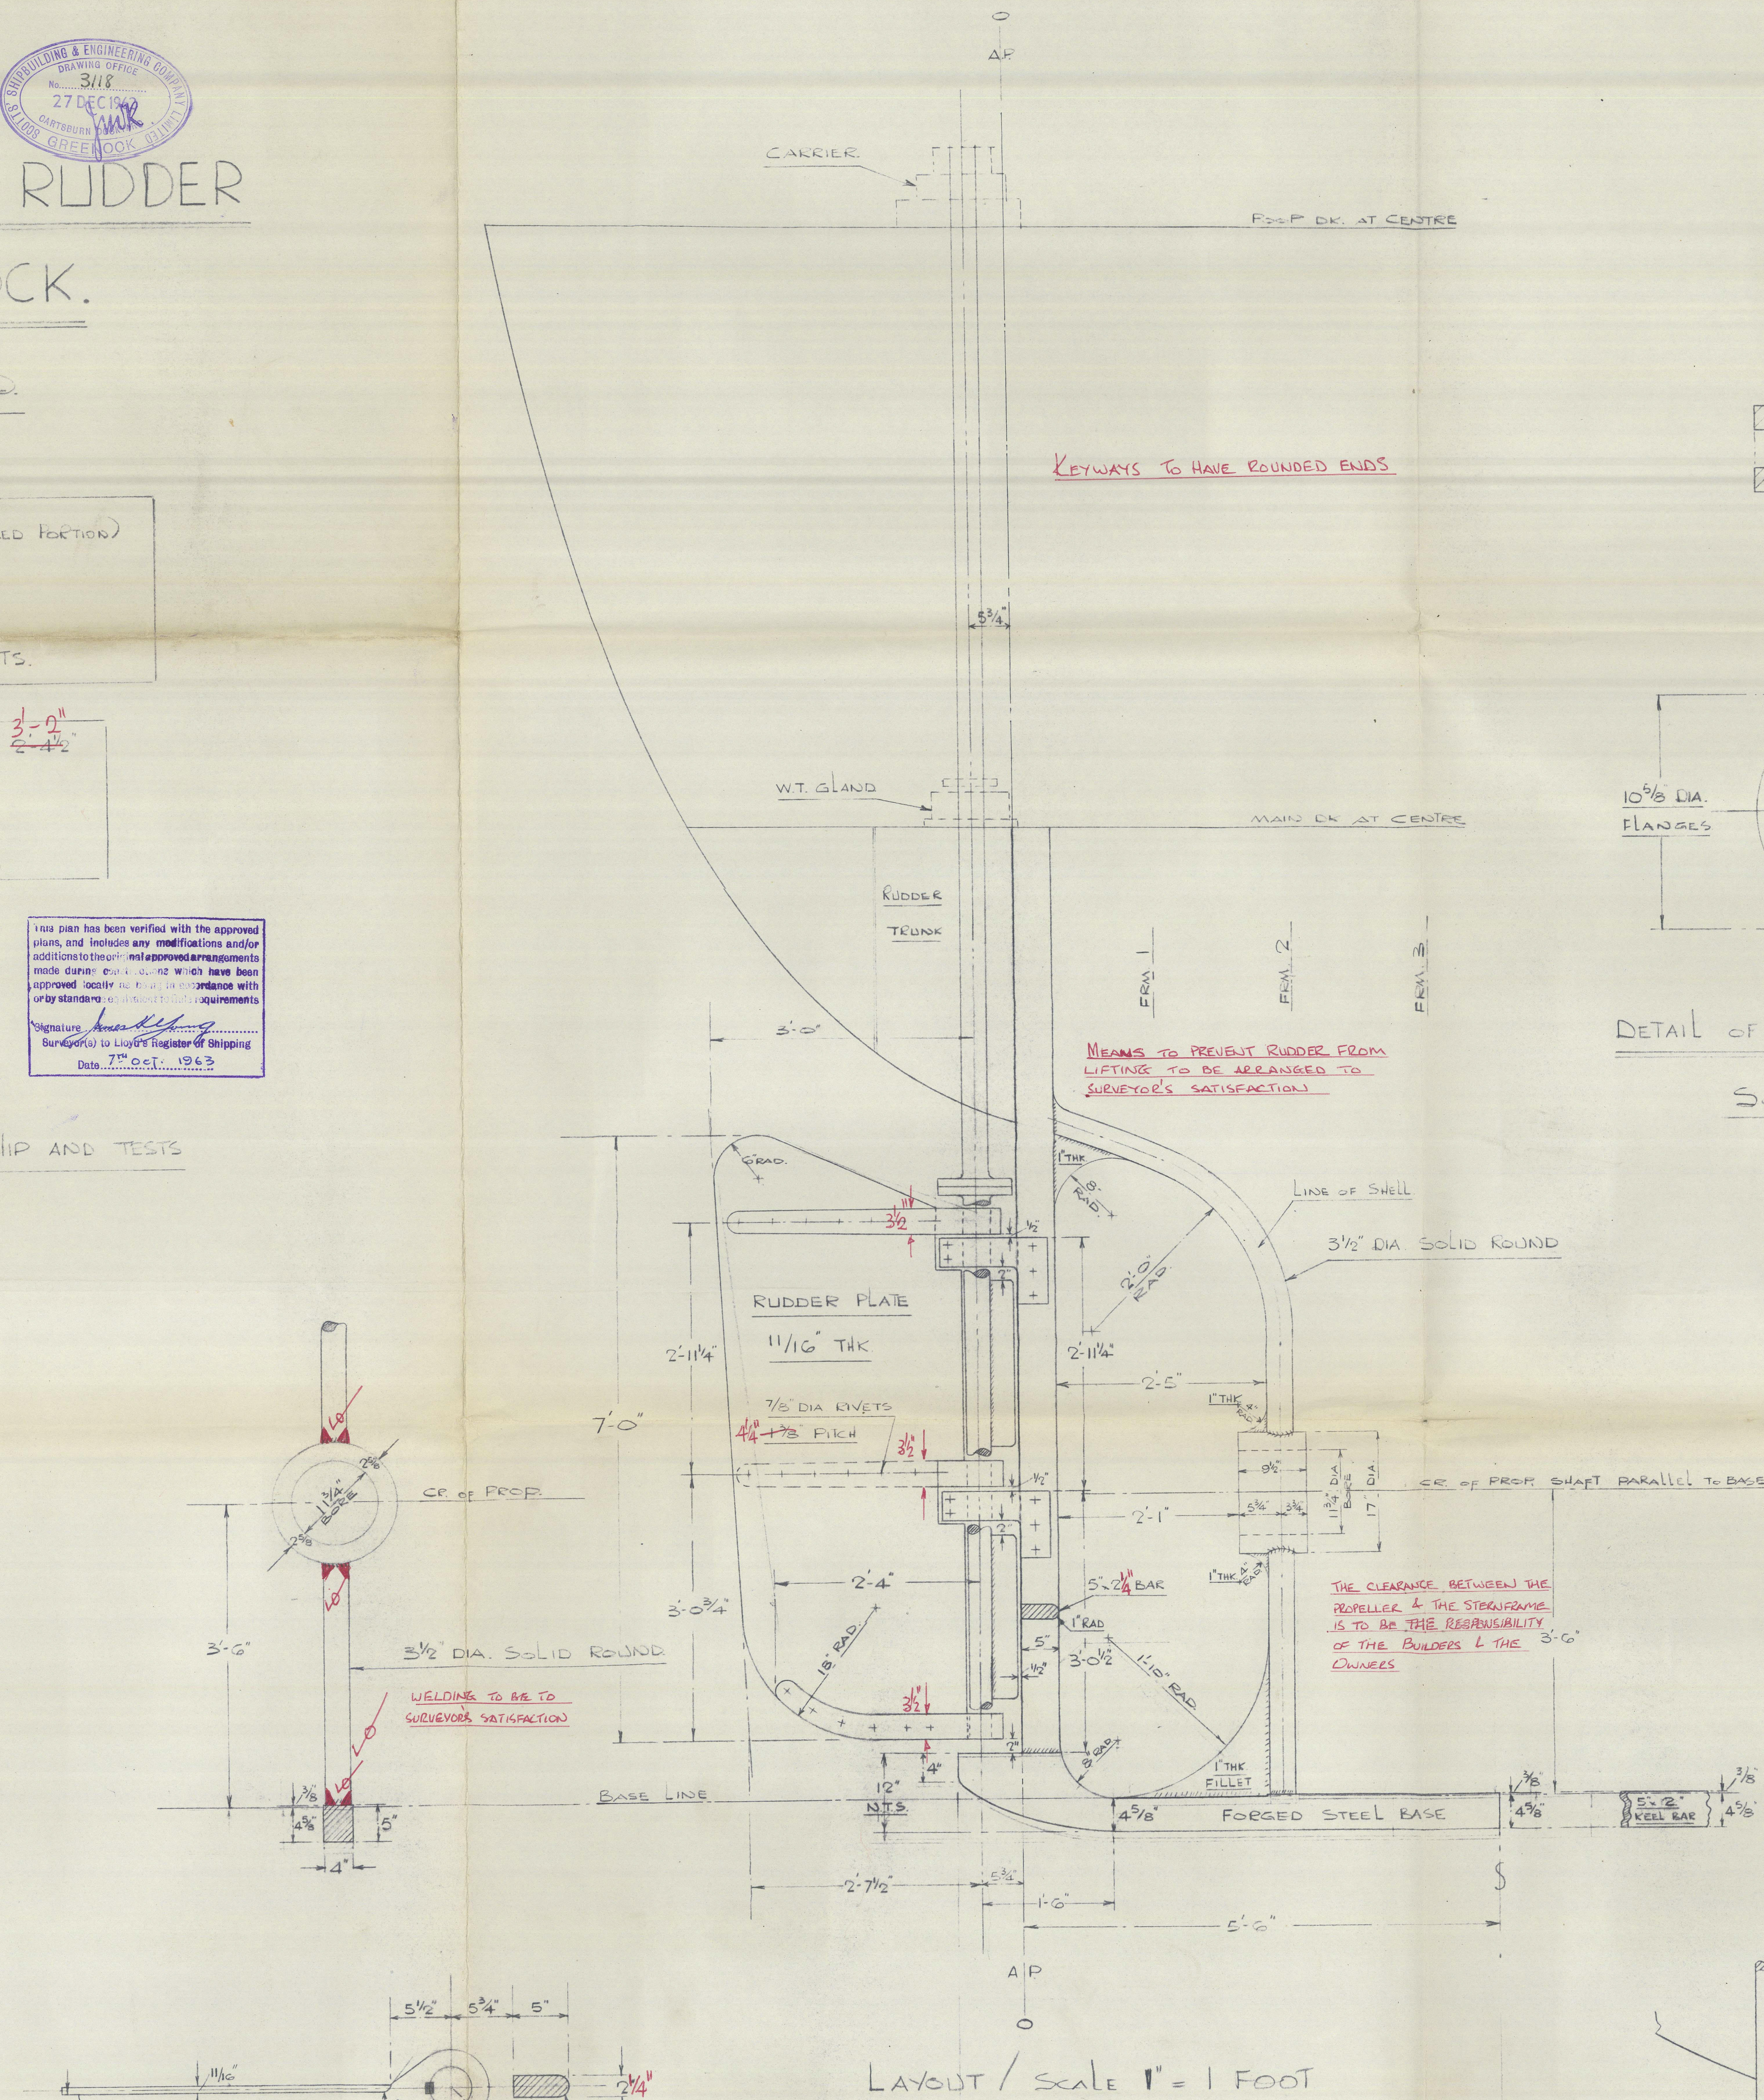

LAYOUT / SCALE 1" = 1 FOOT

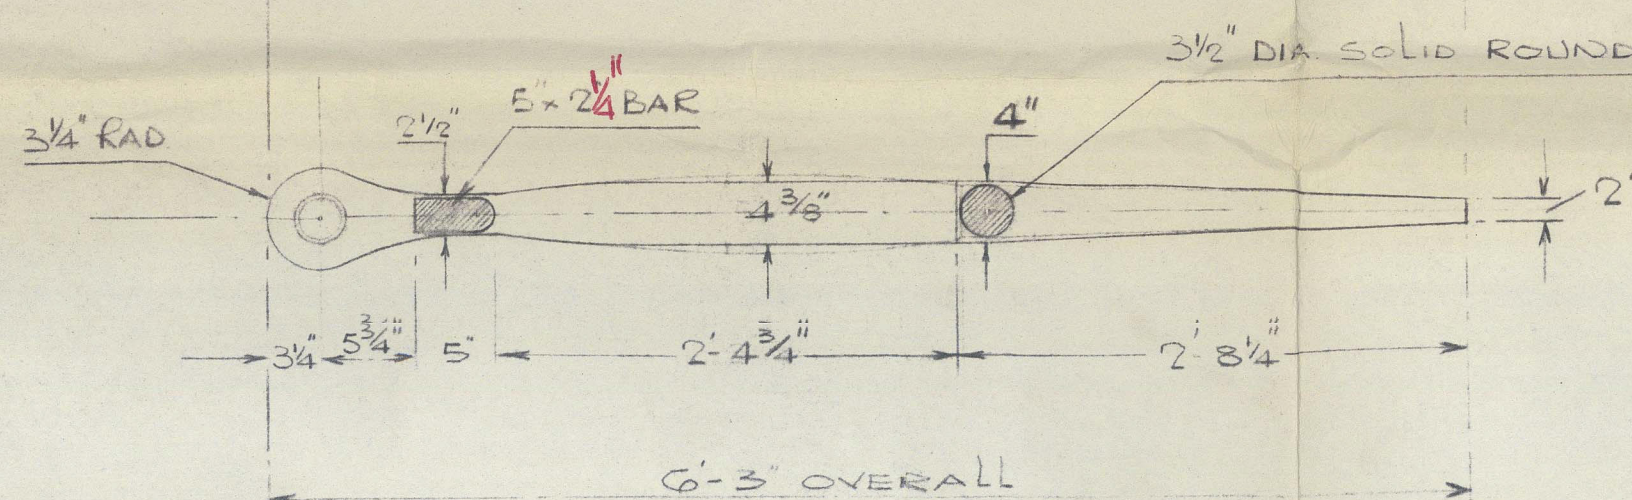


BASE OF STERNFRAME.
(FORGED STEEL)

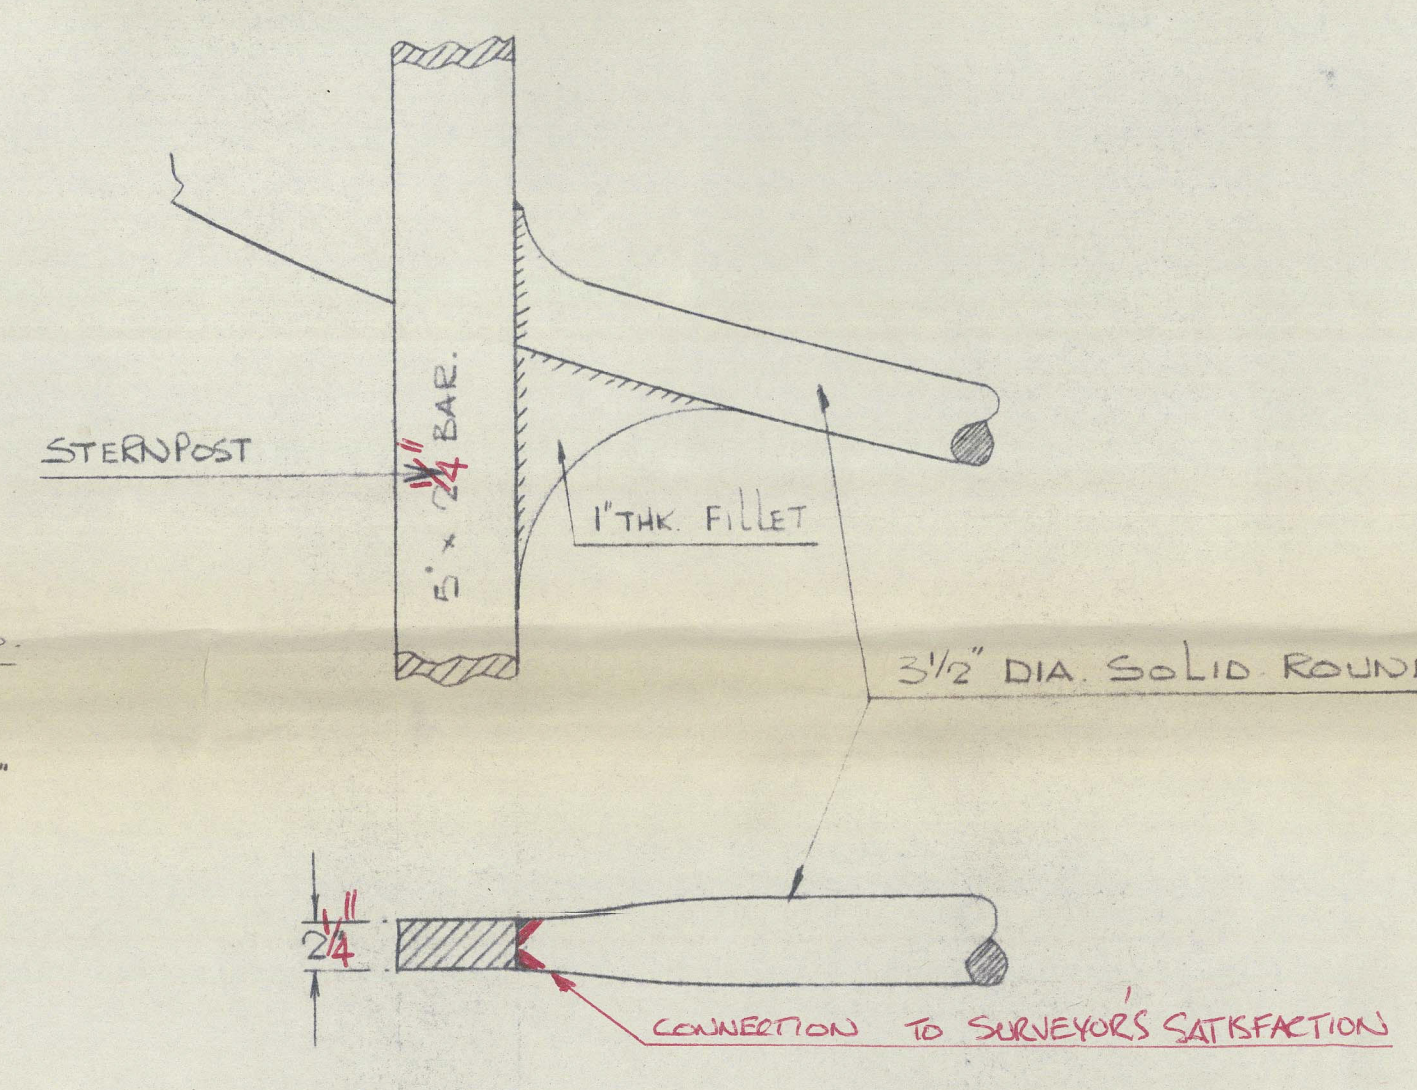


DETAIL SHOWING CONN.
OF 3 1/2 DIA ROUND TO STERNPOST.

SCALE: 1 1/2" = 1 FT.

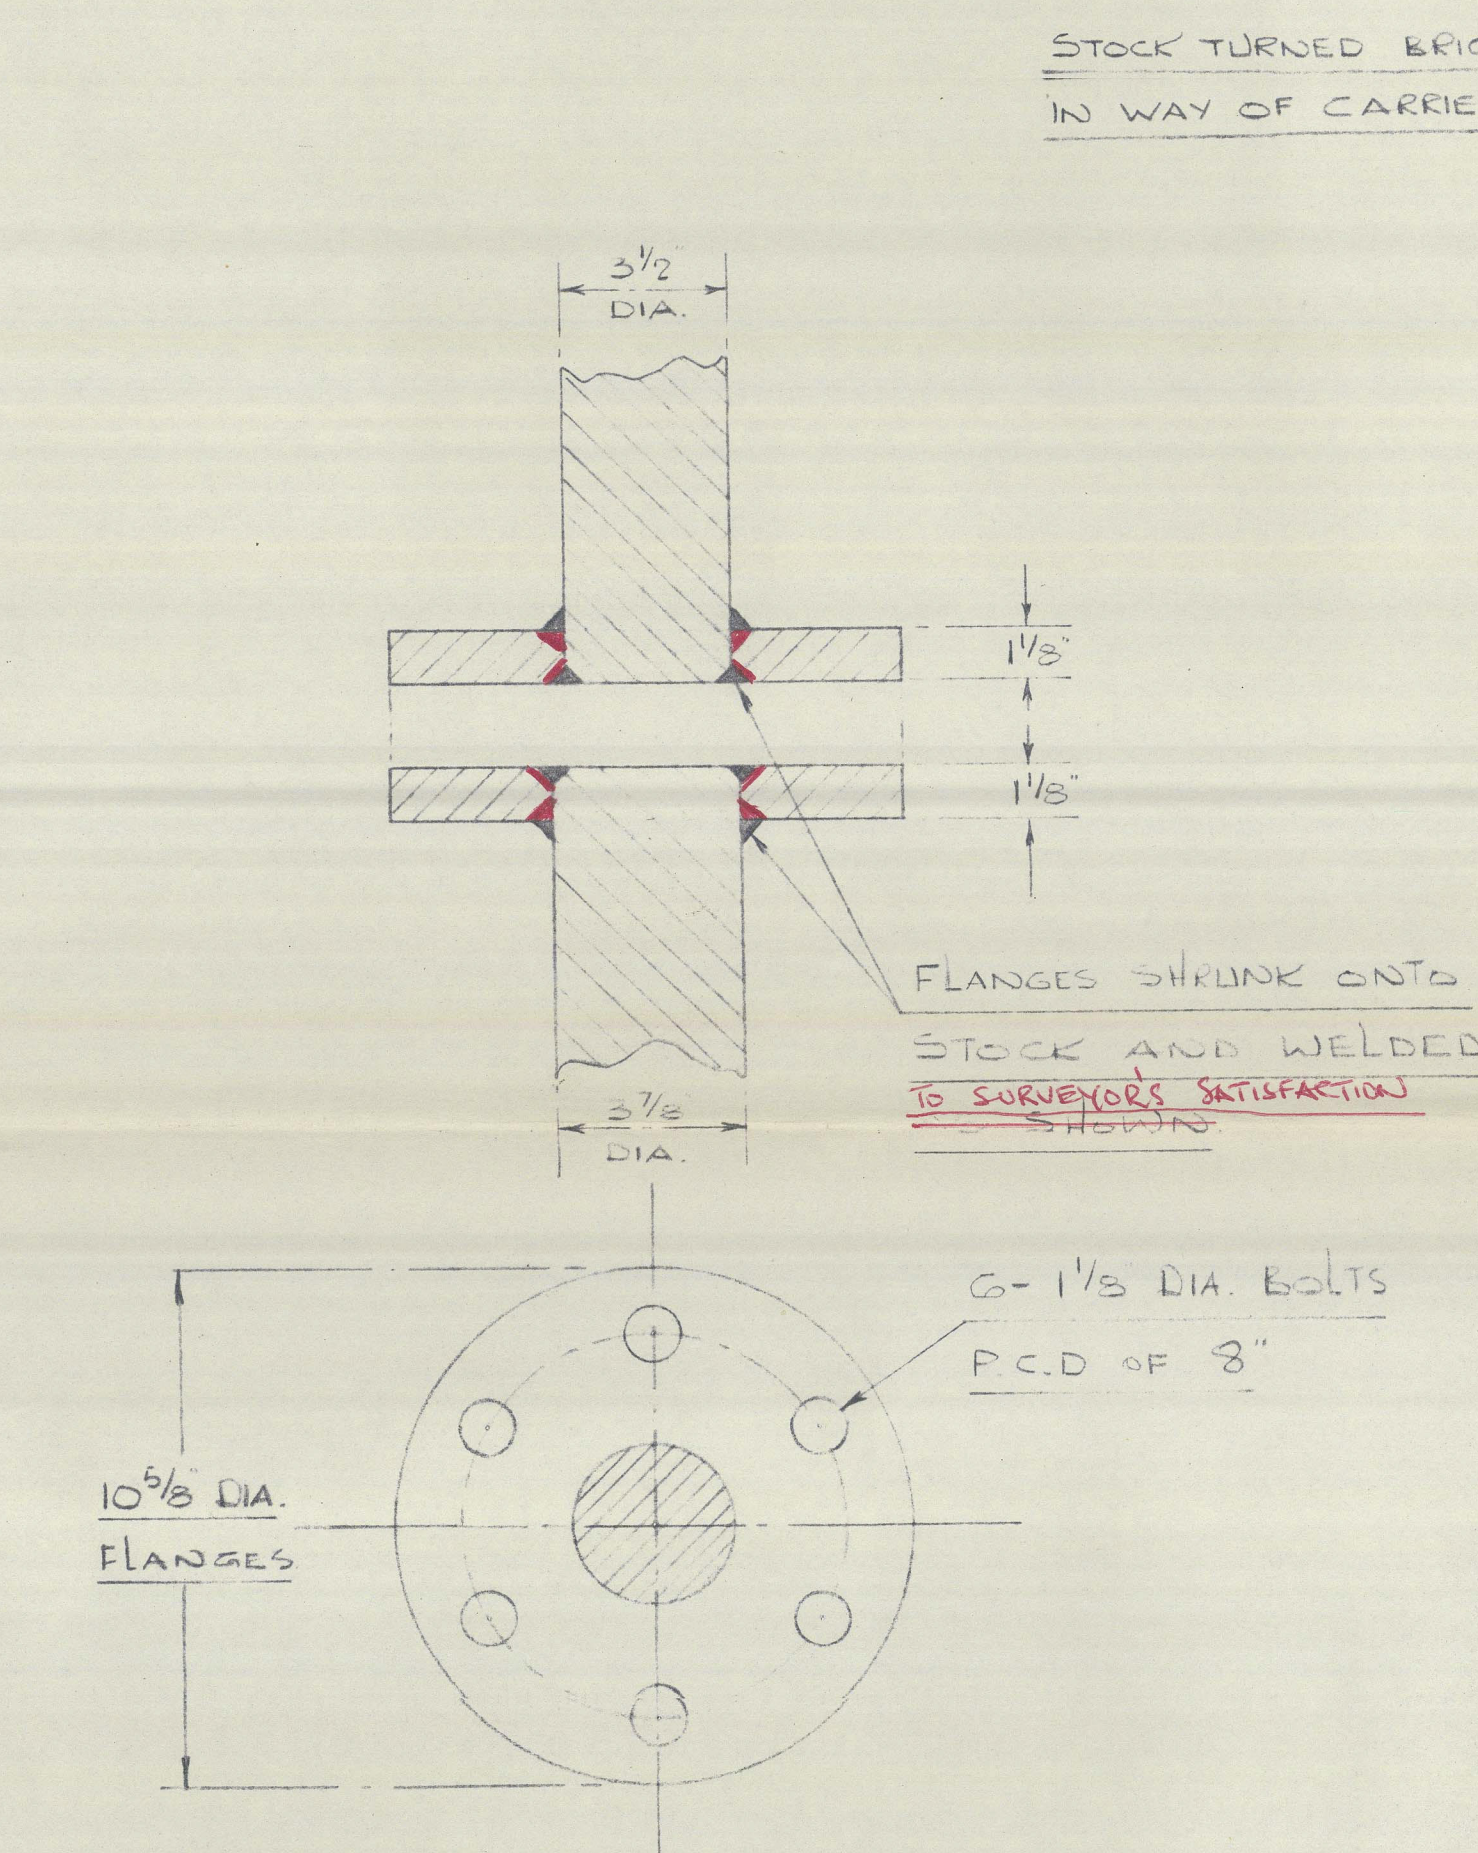


DETAIL OF RUDDER STOCK FLANGES.

SCALE: 3" = 1 FOOT.

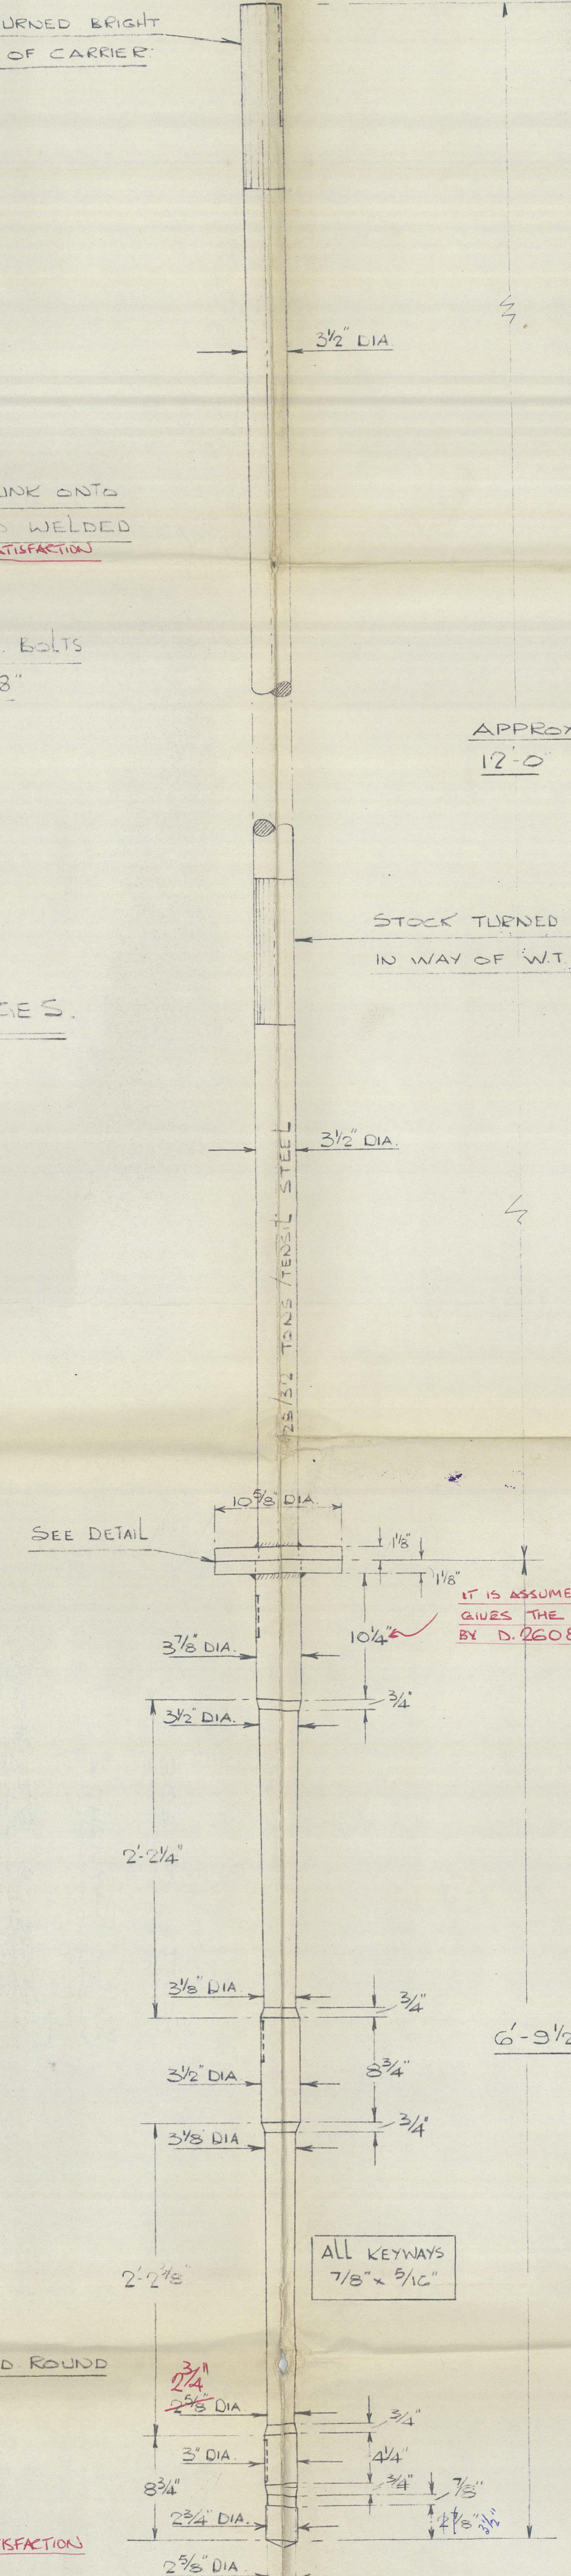


DETAIL OF RUDDER STOCK.

SCALE: 1 1/2" = 1 FT.

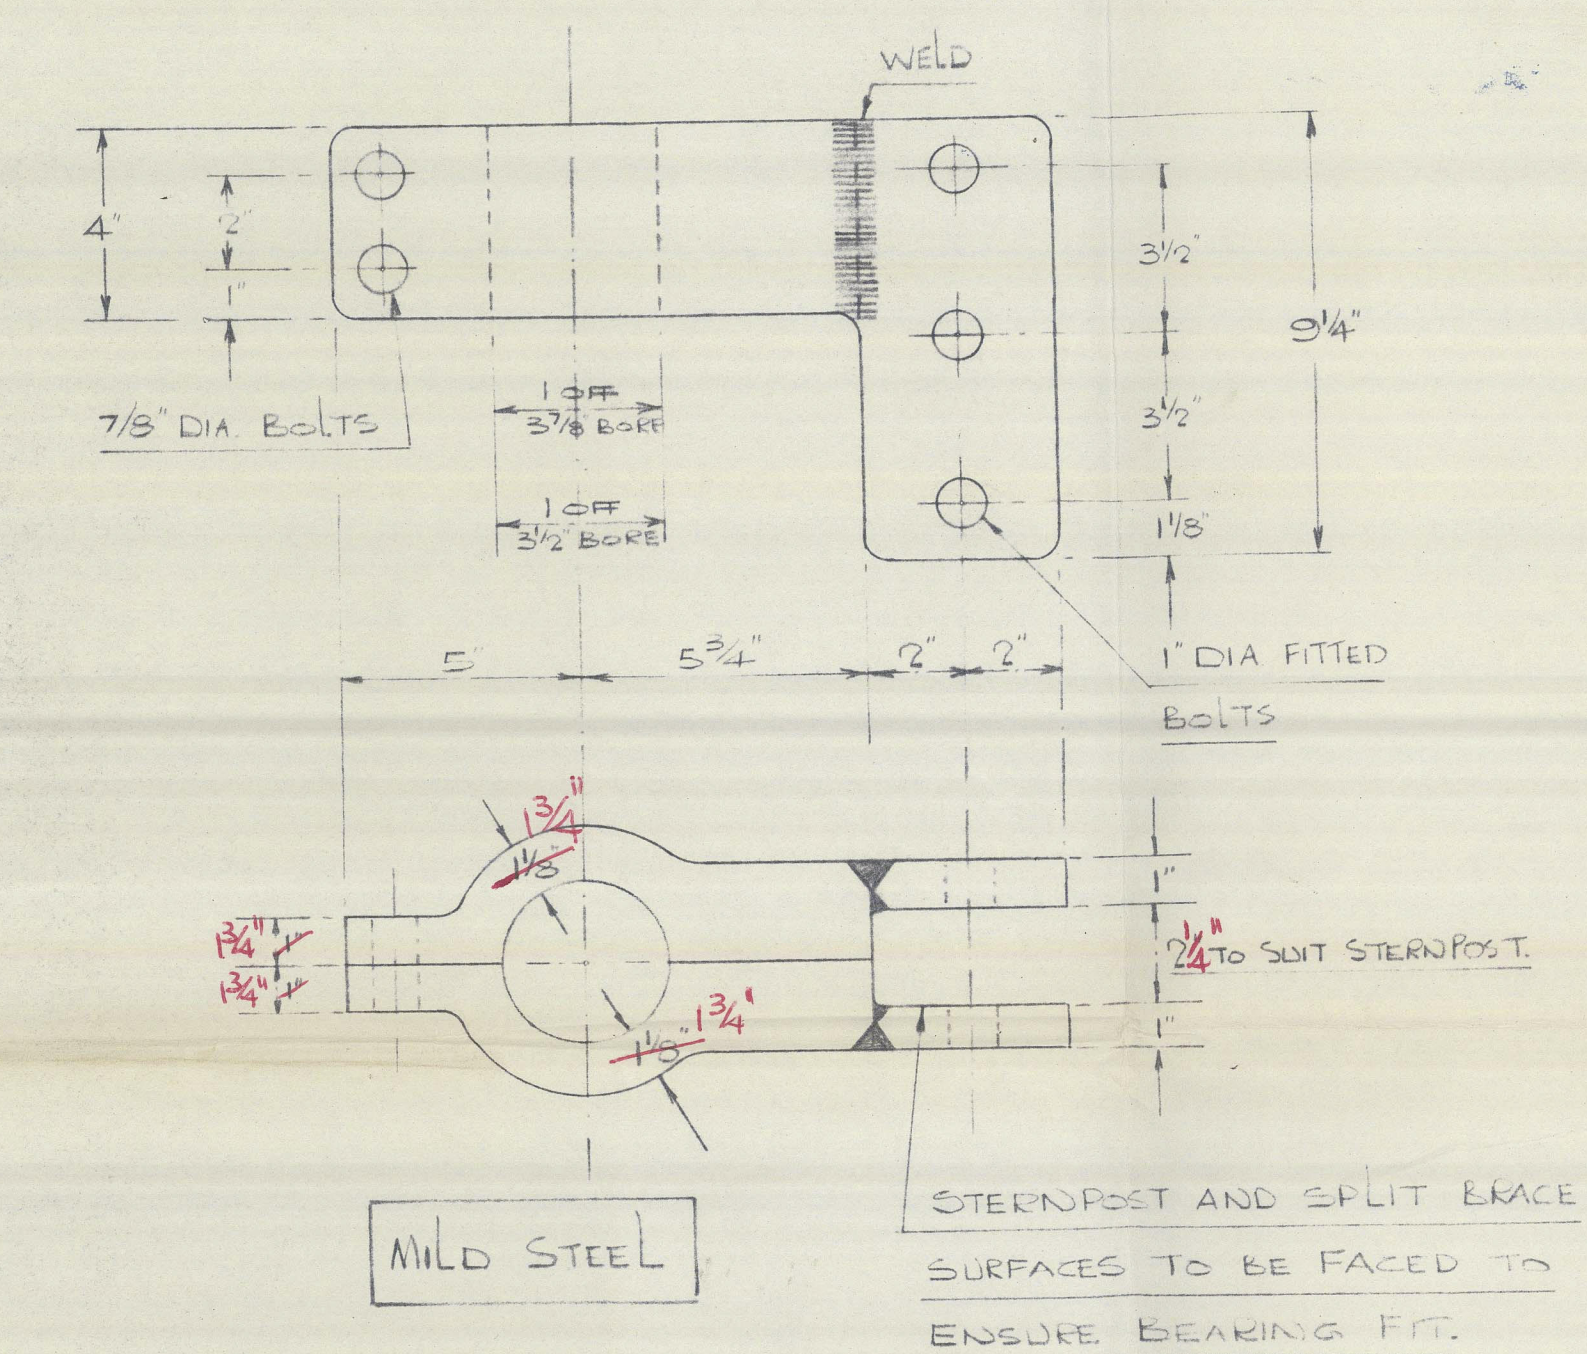


DETAIL OF SPLIT LEACES

SCALE: 3" = 1 FOOT.

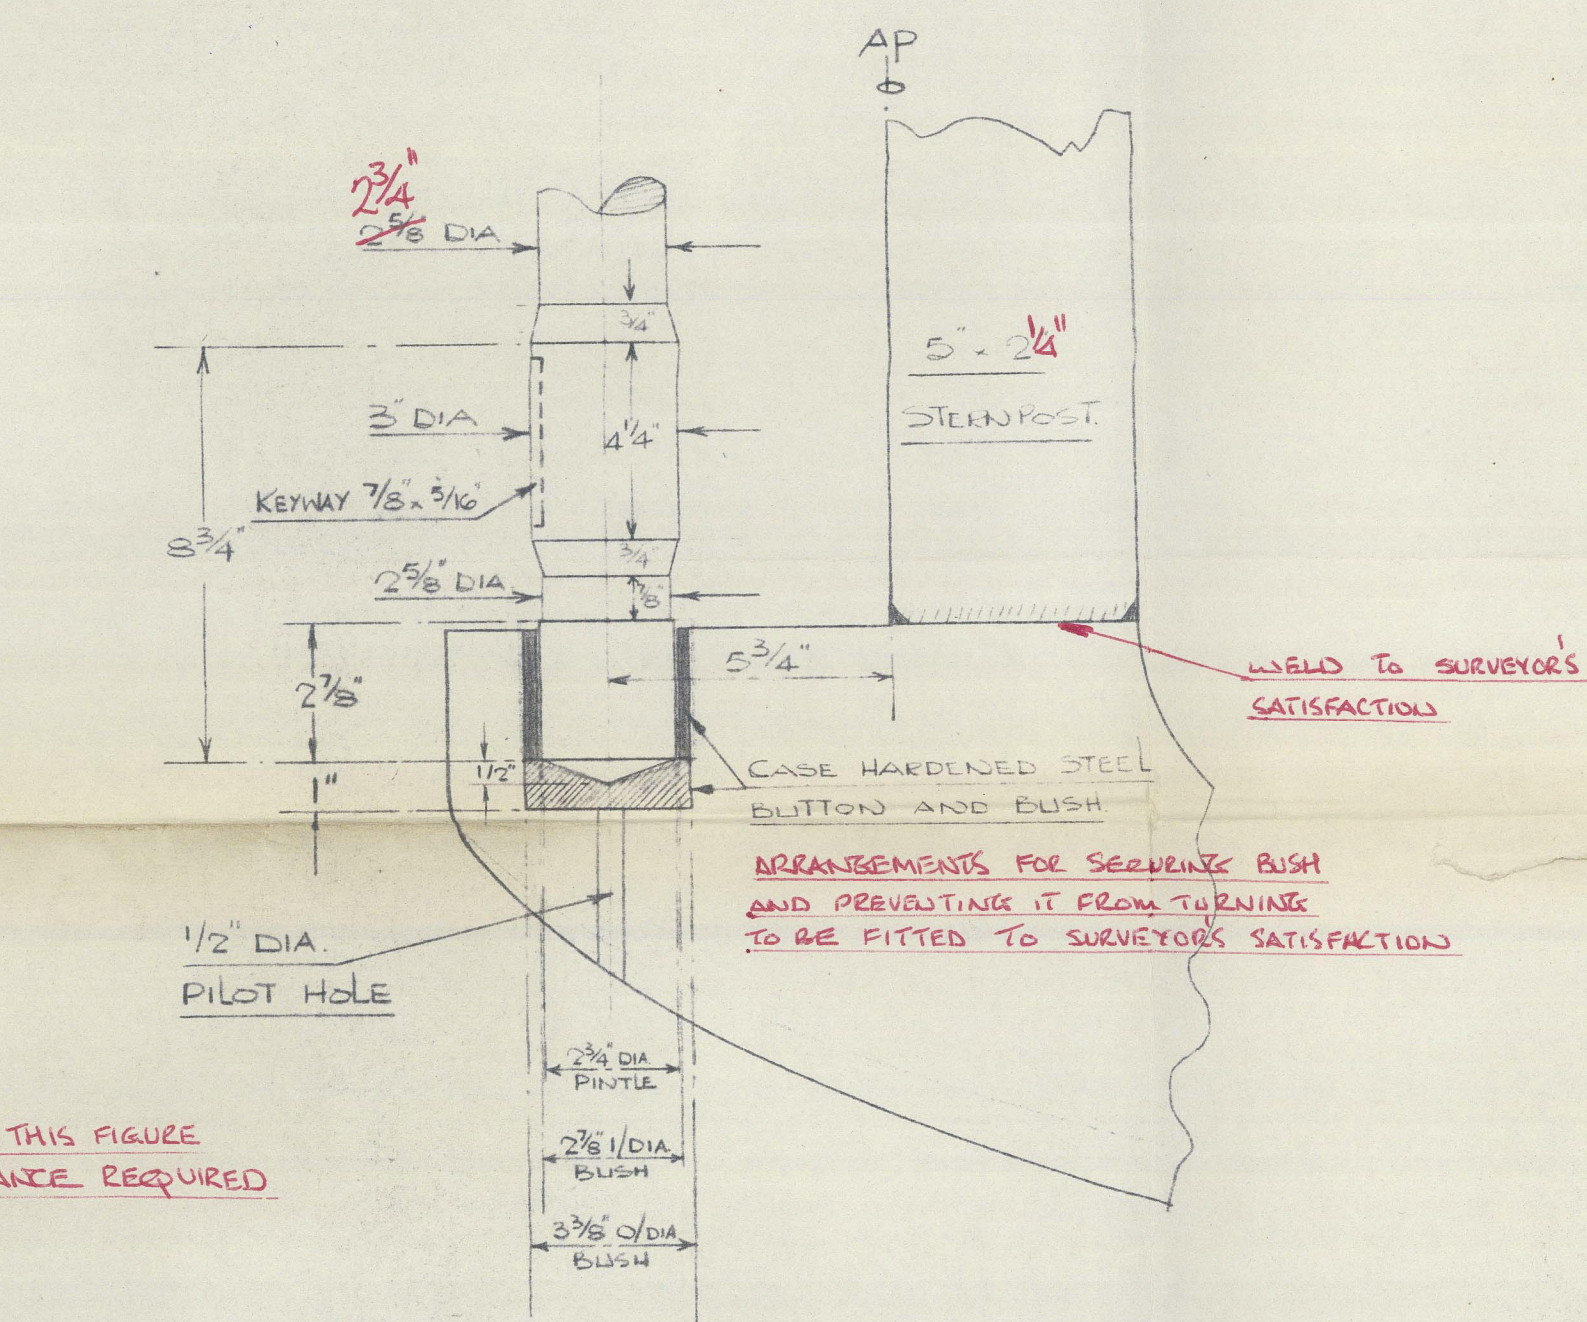

DETAIL OF PINTLE

SCALE: 3" = 1 FOOT.

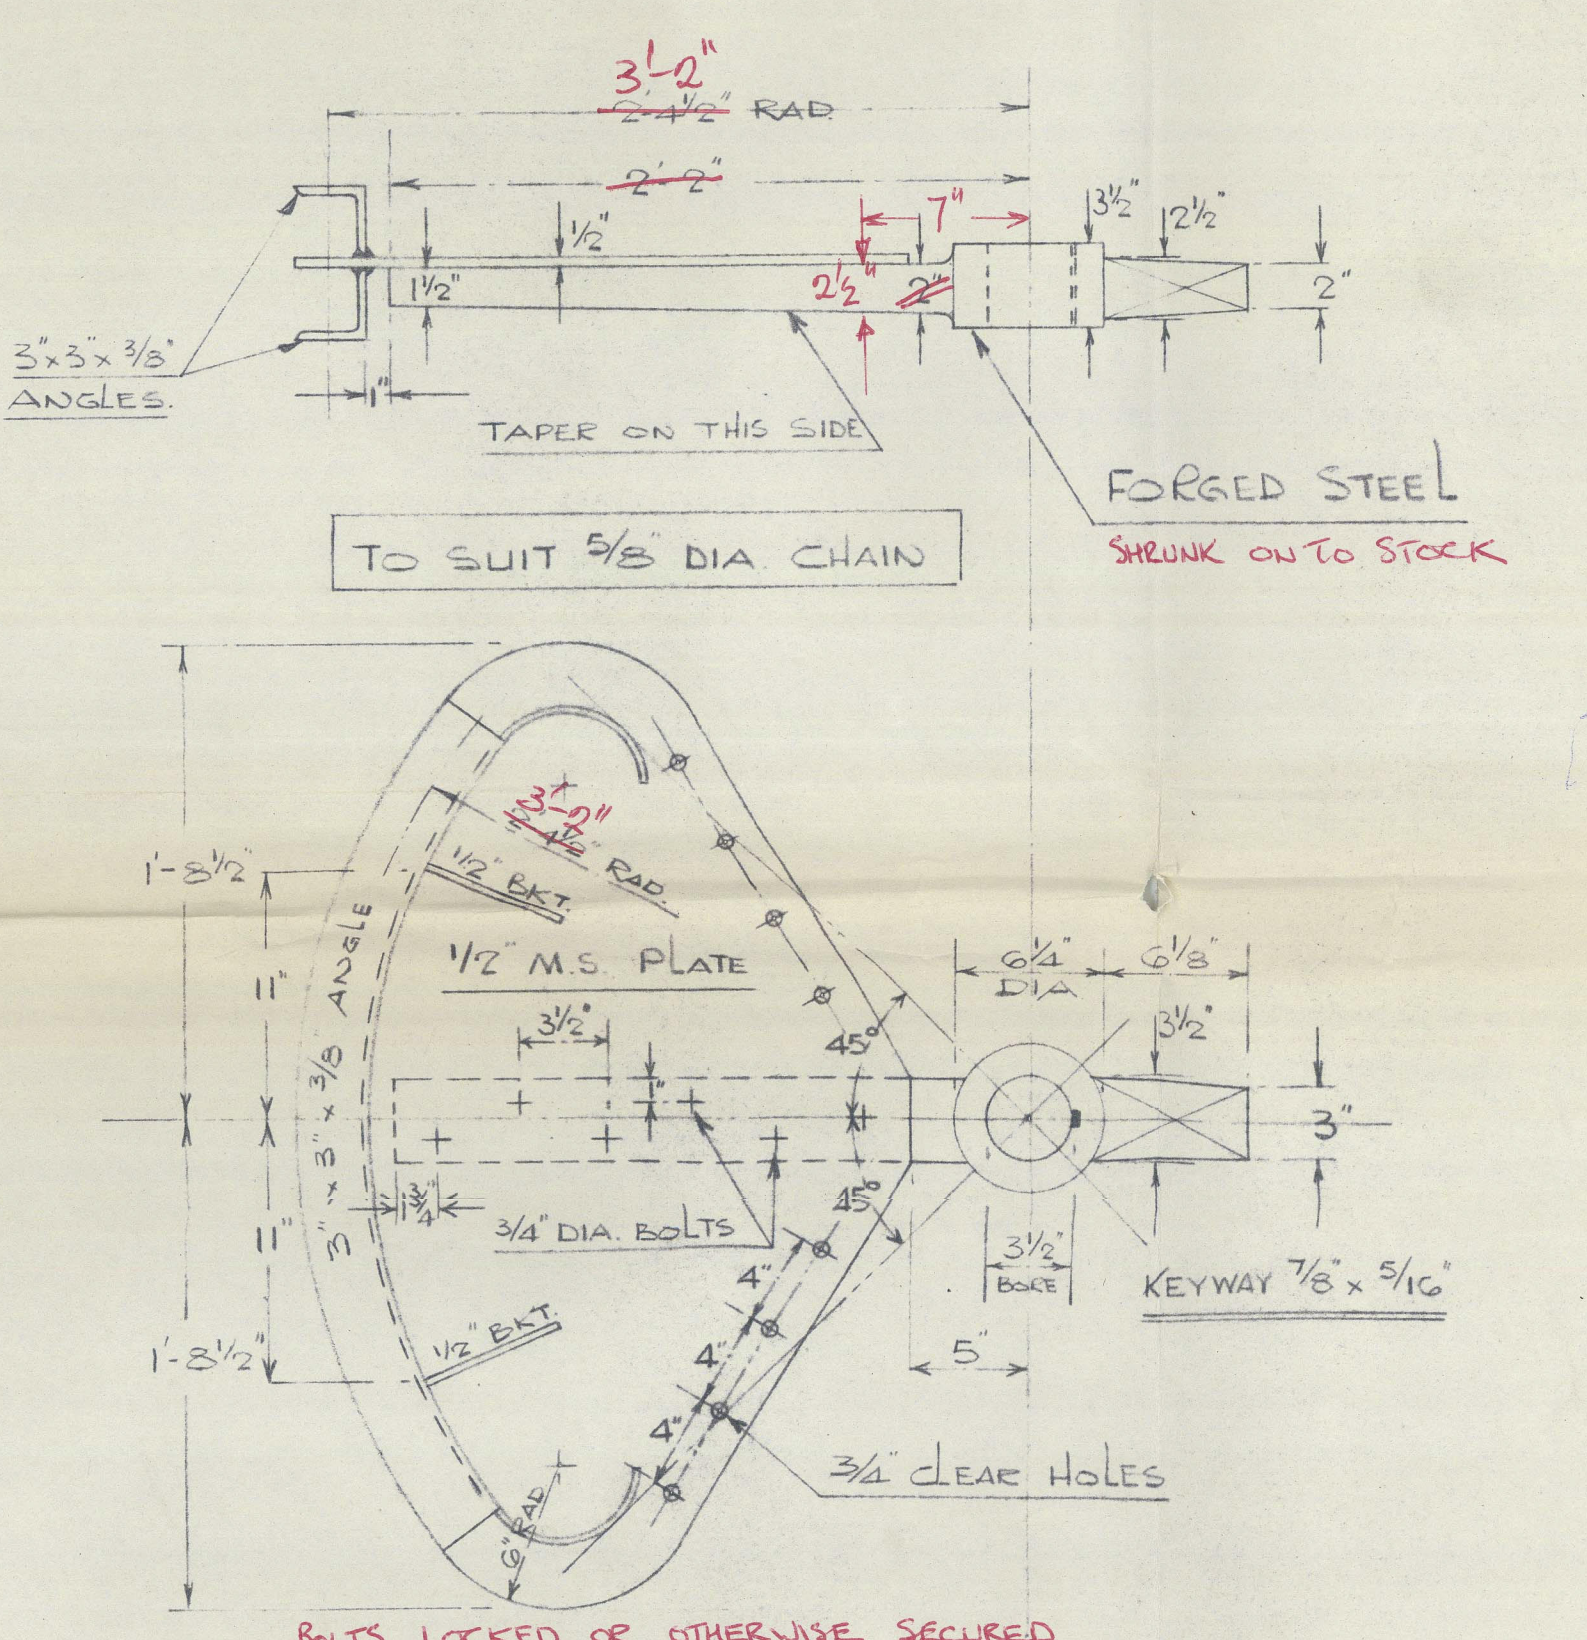

DETAIL OF QUADRANT.

SCALE: 1 1/2" = 1 FOOT.

APPROVED
LLOYD'S REGISTER OF SHIPPING
Date: 16/1/63

SCOTTS N° 695



M/V. "RAYLIGHT" ★

RUDDER & STERNFRAME

F.E. REPORT N° 27341

James McFarlane

RECORDS (USP)
(LONDON)

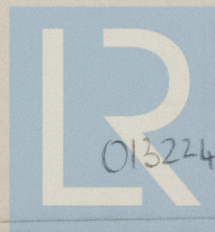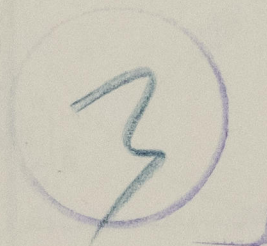

© 2021

013224-01323-0180

Lloyd's Register
Foundation