

W. J. YARWOOD & SONS LTD.

THE DOCK,

NORTHWICH.

MIDSHIP SECTION FOR CARGO STEAMER. YARD No 283.

LENGTH-96'-0"-B.P.


BREADTH-23'-0"-MOULDED.

DEPTH-10'-0"

SCALE 1"-1 FOOT.

DRAWING No 1649.

JAN. 28TH 1919.

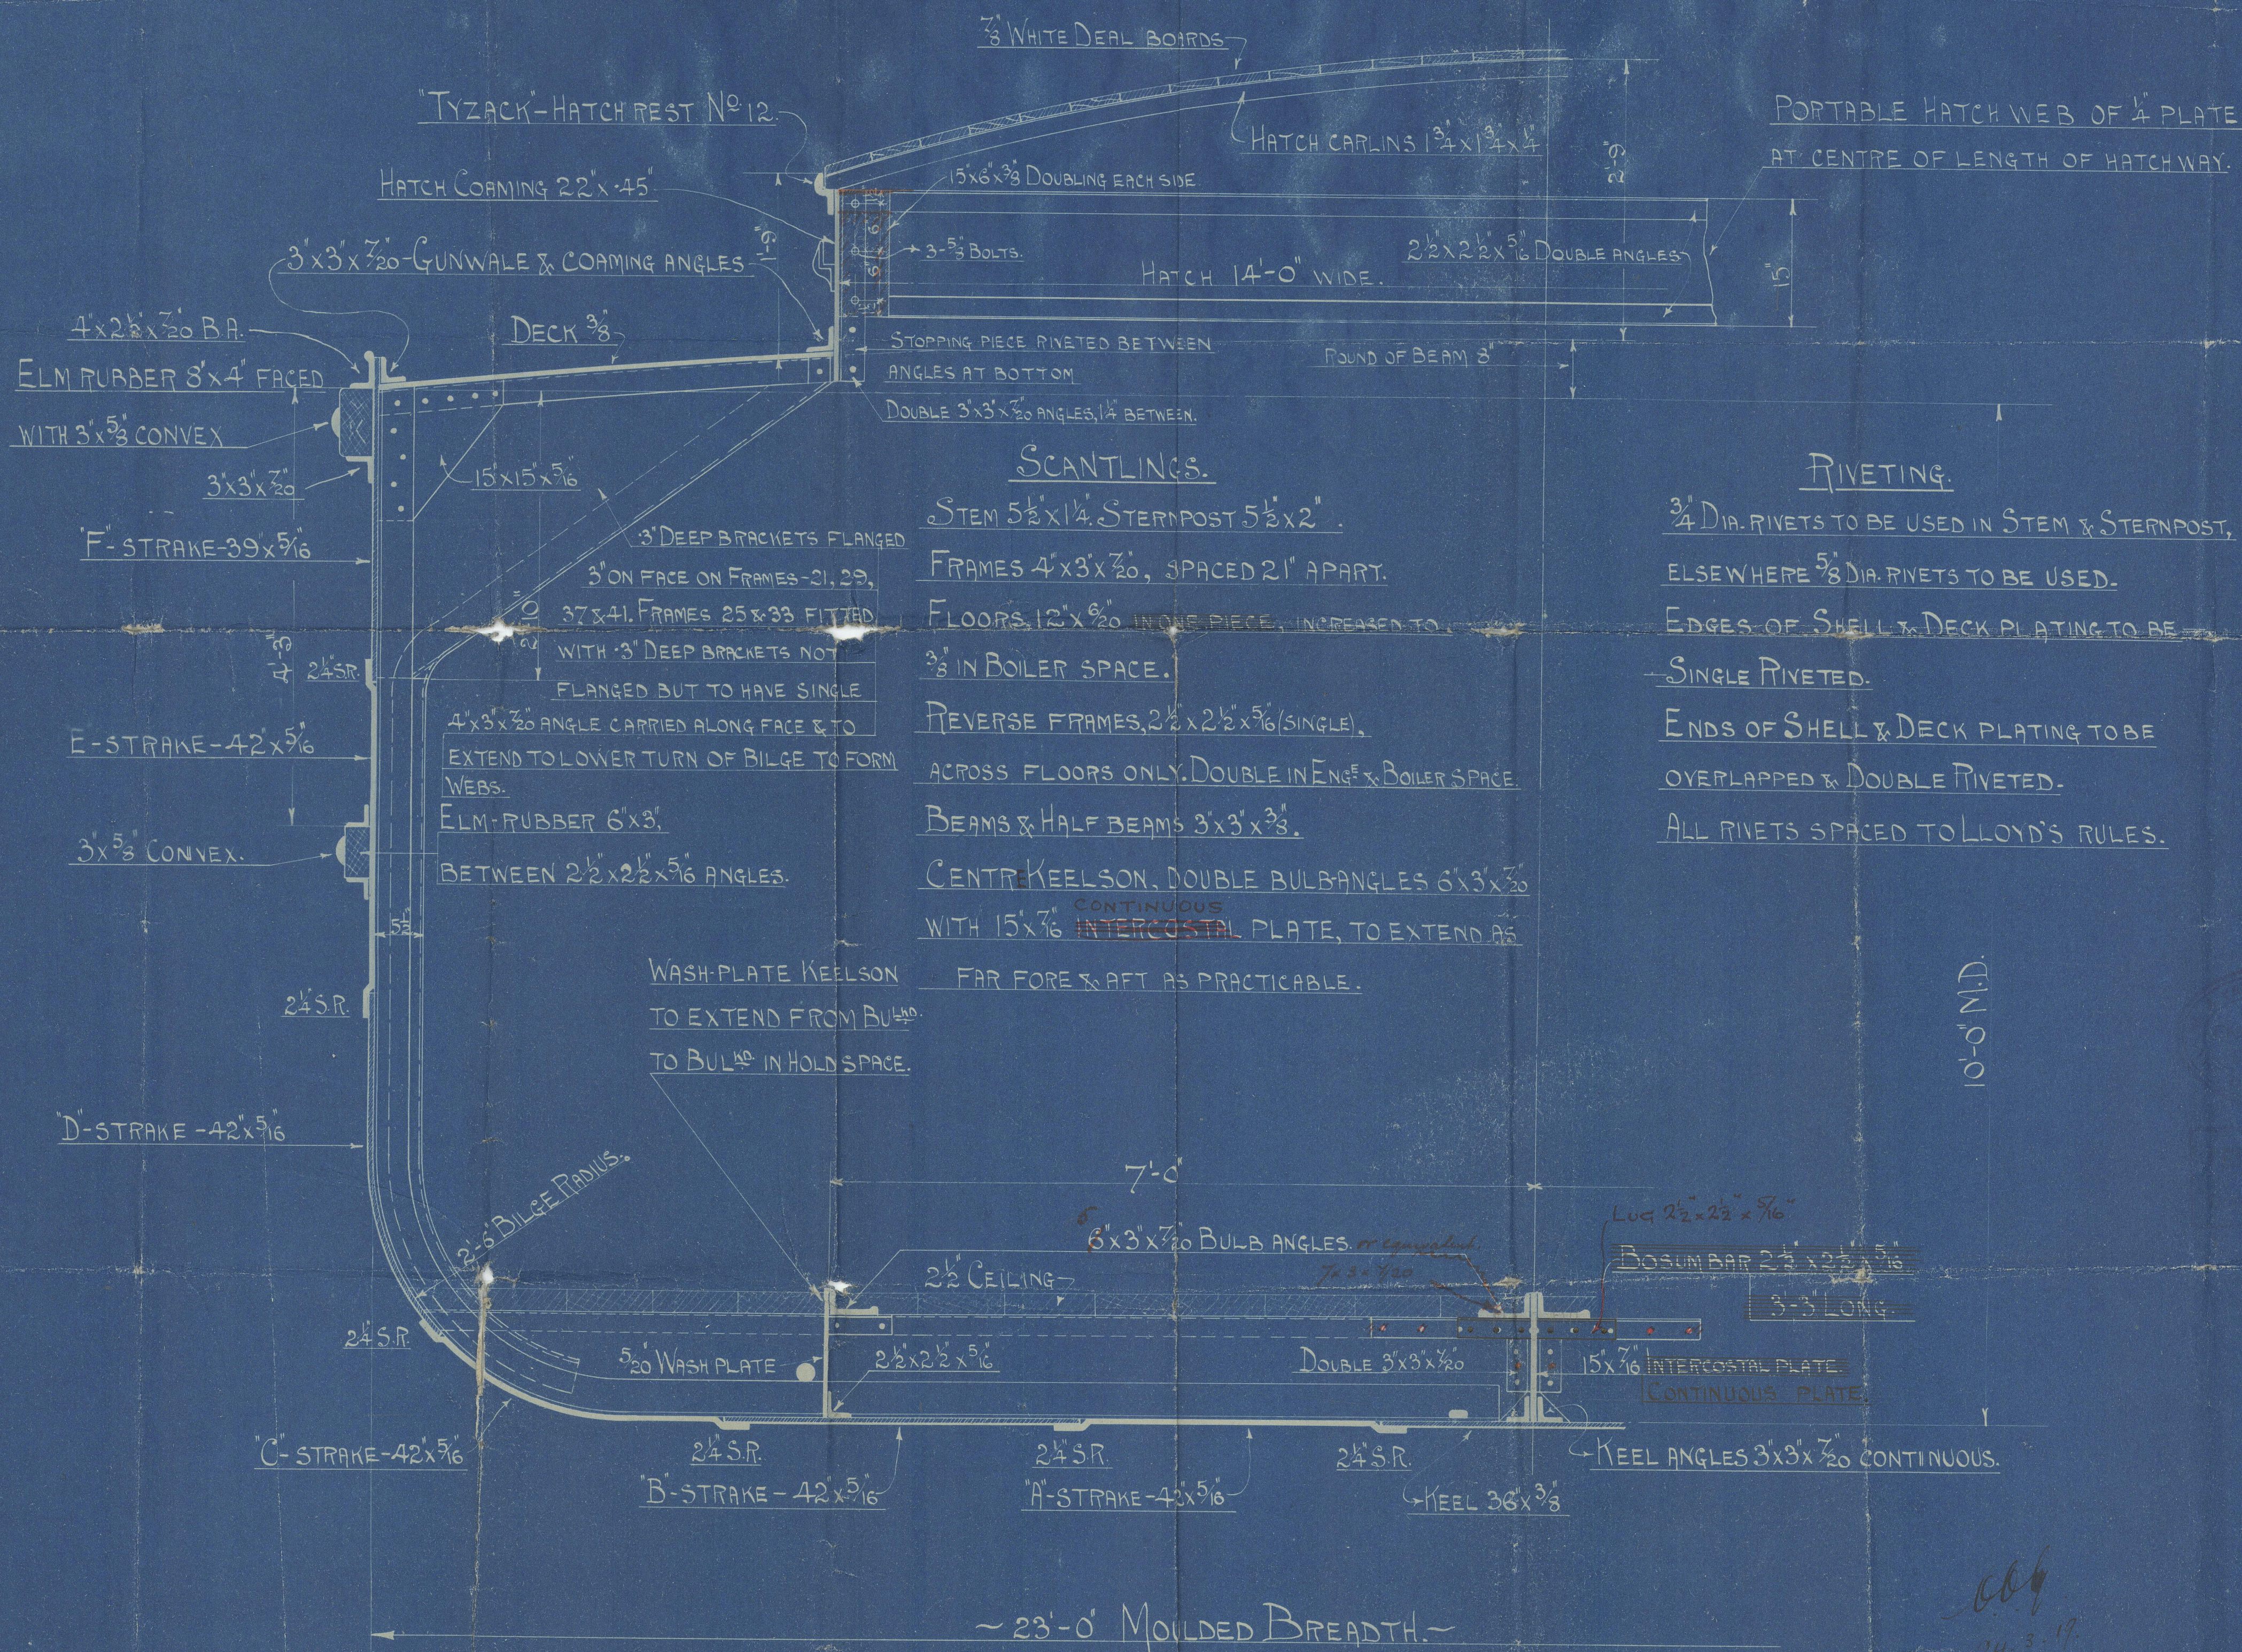

Yarwoods
Cargo Steamer
No 283
Midship Section

S.S. "W. Williams"

LIVERPOOL:

Report No. 80932

283

013750-013759-0123



© 2021

Lloyd's Register
Foundation