

T.S.M.S. MOANA ROA.  
SHIP NO 526.

TWIN SCREW, REFRIGERATED, PASSENGER CARGO MOTOR VESSEL. CLASS 100 A.I.

MIDSHIP SECTION. [AS FITTED]

SCALE:- 1/2" = ONE FOOT. BUILT BY: THE GRANGEMOUTH DOCKYARD CO. LTD. GRANGEMOUTH, JULY 1960

DIMENSIONS:-

LENGTH B.P. 270'0" (30% OF EXTREME LENGTH ON L.W.L. (277'83" x 96) = 266'72")

BREADTH MOULDED = 46'0"

DEPTH MOULDED = 22'0" TO MAIN DECK.

ALL SUPERSTRUCTURES = 8'0"

DRAUGHT LOADED (ABOUT 16") SCANTLINGS TO BE SUCH THAT A DRAUGHT OF 17'0" ABOVE TOP OF KEEL COULD BE OBTAINED AS A CARGO SHIP.  
SCANTLINGS SUITABLE FOR A SUMMER DRAUGHT OF 17'0" MEASURED ABOVE THE TOP OF KEEL.

EQUIPMENT NUMBER:-



HULL	270 (46' x 17) + 85 x 270 (22' - 11")	= 18157.5
BRIDGE	85 (15'0" x 10' x 8")	= 1065.25
BRIDGE DECKHOUSE	75 (8' x 13'0")	= 828.0
BOAT DECKHOUSE FWD.	85 (26'5" x 8")	= 248.0
BOAT DECKHOUSE AFT.	75 (8' x 29")	= 174.0
NAV. BRIDGE DECKHOUSE.	85 (31'35" x 8")	= 2125.05

EQUIPMENT LETTER "C"

2 POWER ANCHORS EACH 3375 CWT. STOCKLESS.  
240 FATHOMS 1 1/2" TAYES SPECIAL STEEL STUD LINK CHAIN CABLE.  
100 FATHOMS 4" F.D. F.W. MOORING ROPES.  
3100 FATHOMS 2 1/4" F.W. MOORING ROPES.

DAC SYSTEM 7 1/2" x 2" PLATE SYSTEM 50 BELOW LOAD WATERLINE TAPERS TO 36 AT STEAM HEAD 4000 PSI WITH WELDED BUTTS.  
PROTECTOR - 5" x 3/4" SOLID.



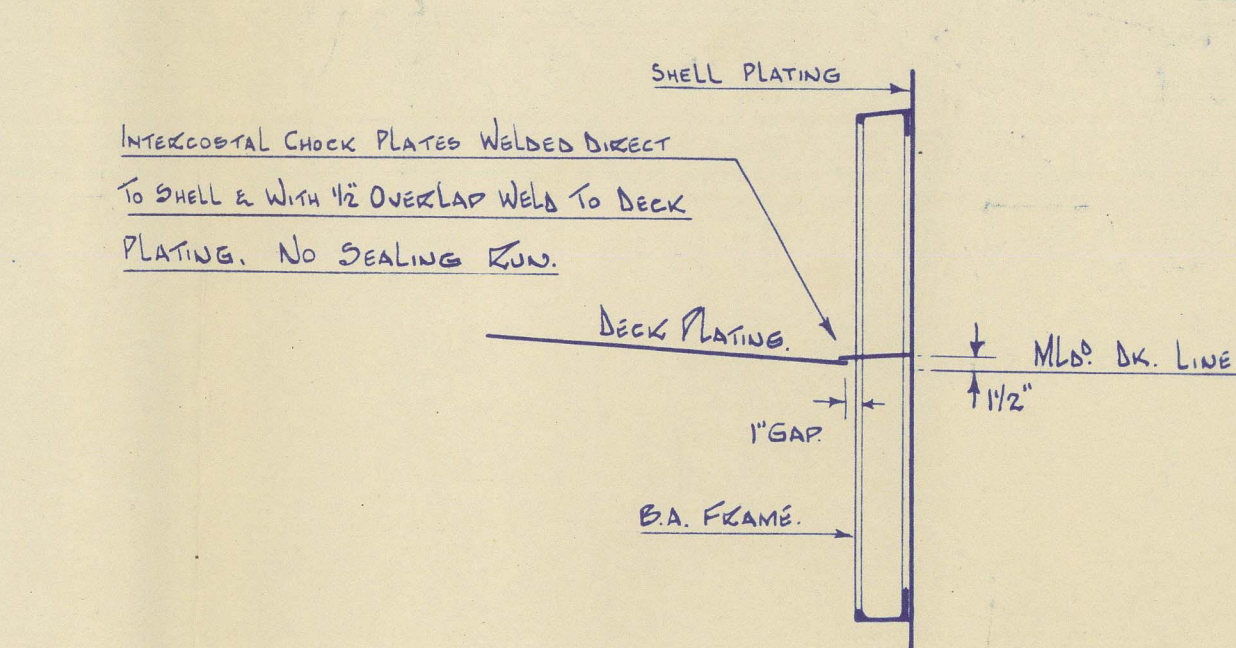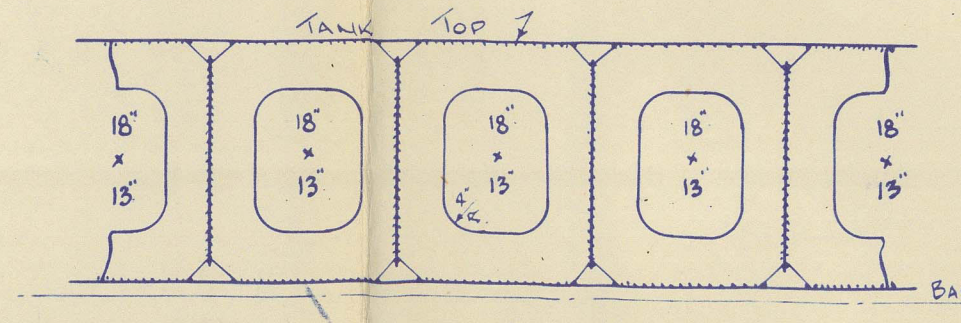

30 INTERCOSTAL LINE GIBBER IN HULLS 1/2" OFF F.P.D.  
30 INTERCOSTAL LINE GIBBER 7/8" OFF F.P.D. IN FORWARD 20L AND 20R.

DETAIL OF WELDED CHOCK PLATE

30 1/2 HT. INTL. SIDE GIBBER 3/4" OFF F.P.D. IN THE FORWARD 20L AND 20R.

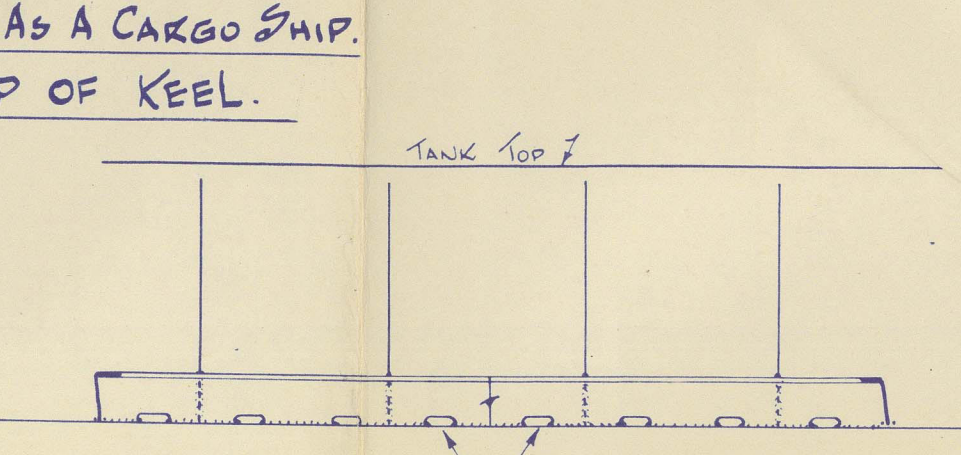

30 1/2 HT. INTL. SIDE GIBBER 3/4" OFF F.P.D. IN THE FORWARD 20L AND 20R.

LONGITUDINAL STIFFENING GIBBER 1/2" OFF F.P.D. EXTENT 4L AND 4R.

LONGITUDINAL STIFFENING GIBBER 1/2" OFF F.P.D. EXTENT 4L AND 4R.

1(A)

THE GRANGEMOUTH DOCKYARD CO., LTD.  
YARD No. 526.

MIDSHIP SECTION (AS FITTED).

GLASGOW REPORT No



91590

COMPUTERISED

MOANA

ROA

RECORDS DEPT.

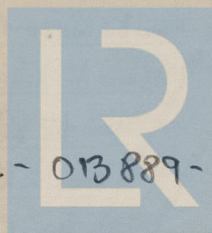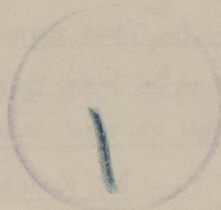

© 2021

013884 - 013889 - 0005

Lloyd's Register  
Foundation