



CONSTRUCTION PLAN

SCALE 1:50

PRINCIPAL DIMENSIONS

LENGTH O.A.	58.00	METER	192'-5 1/2"
L.W.L.	55.68	"	182'-8 1/2"
BREADTH	16.25	"	53'-9 3/4"
DEPTH TO UPPERDECK	4.25	"	13'-9 3/4"
CLASSIFICATION	LLOYD'S 100 A.1 WITH FREEBOARD CORRESPONDING TO A 255 VESSEL WITH TENNAGE OPENING		
FIRST NR	L x D	182.68 x 16.25 = 2968.8	
SECOND	L x (B + D)	182.68 x (27.9 + 16.25) = 8056	
BT	L x B	182.68 x 16.25 = 2968.8	
		12	

ARRANGEMENT OF DECKS
OR BULKHEAD IN HOLD & TWEEN DECK

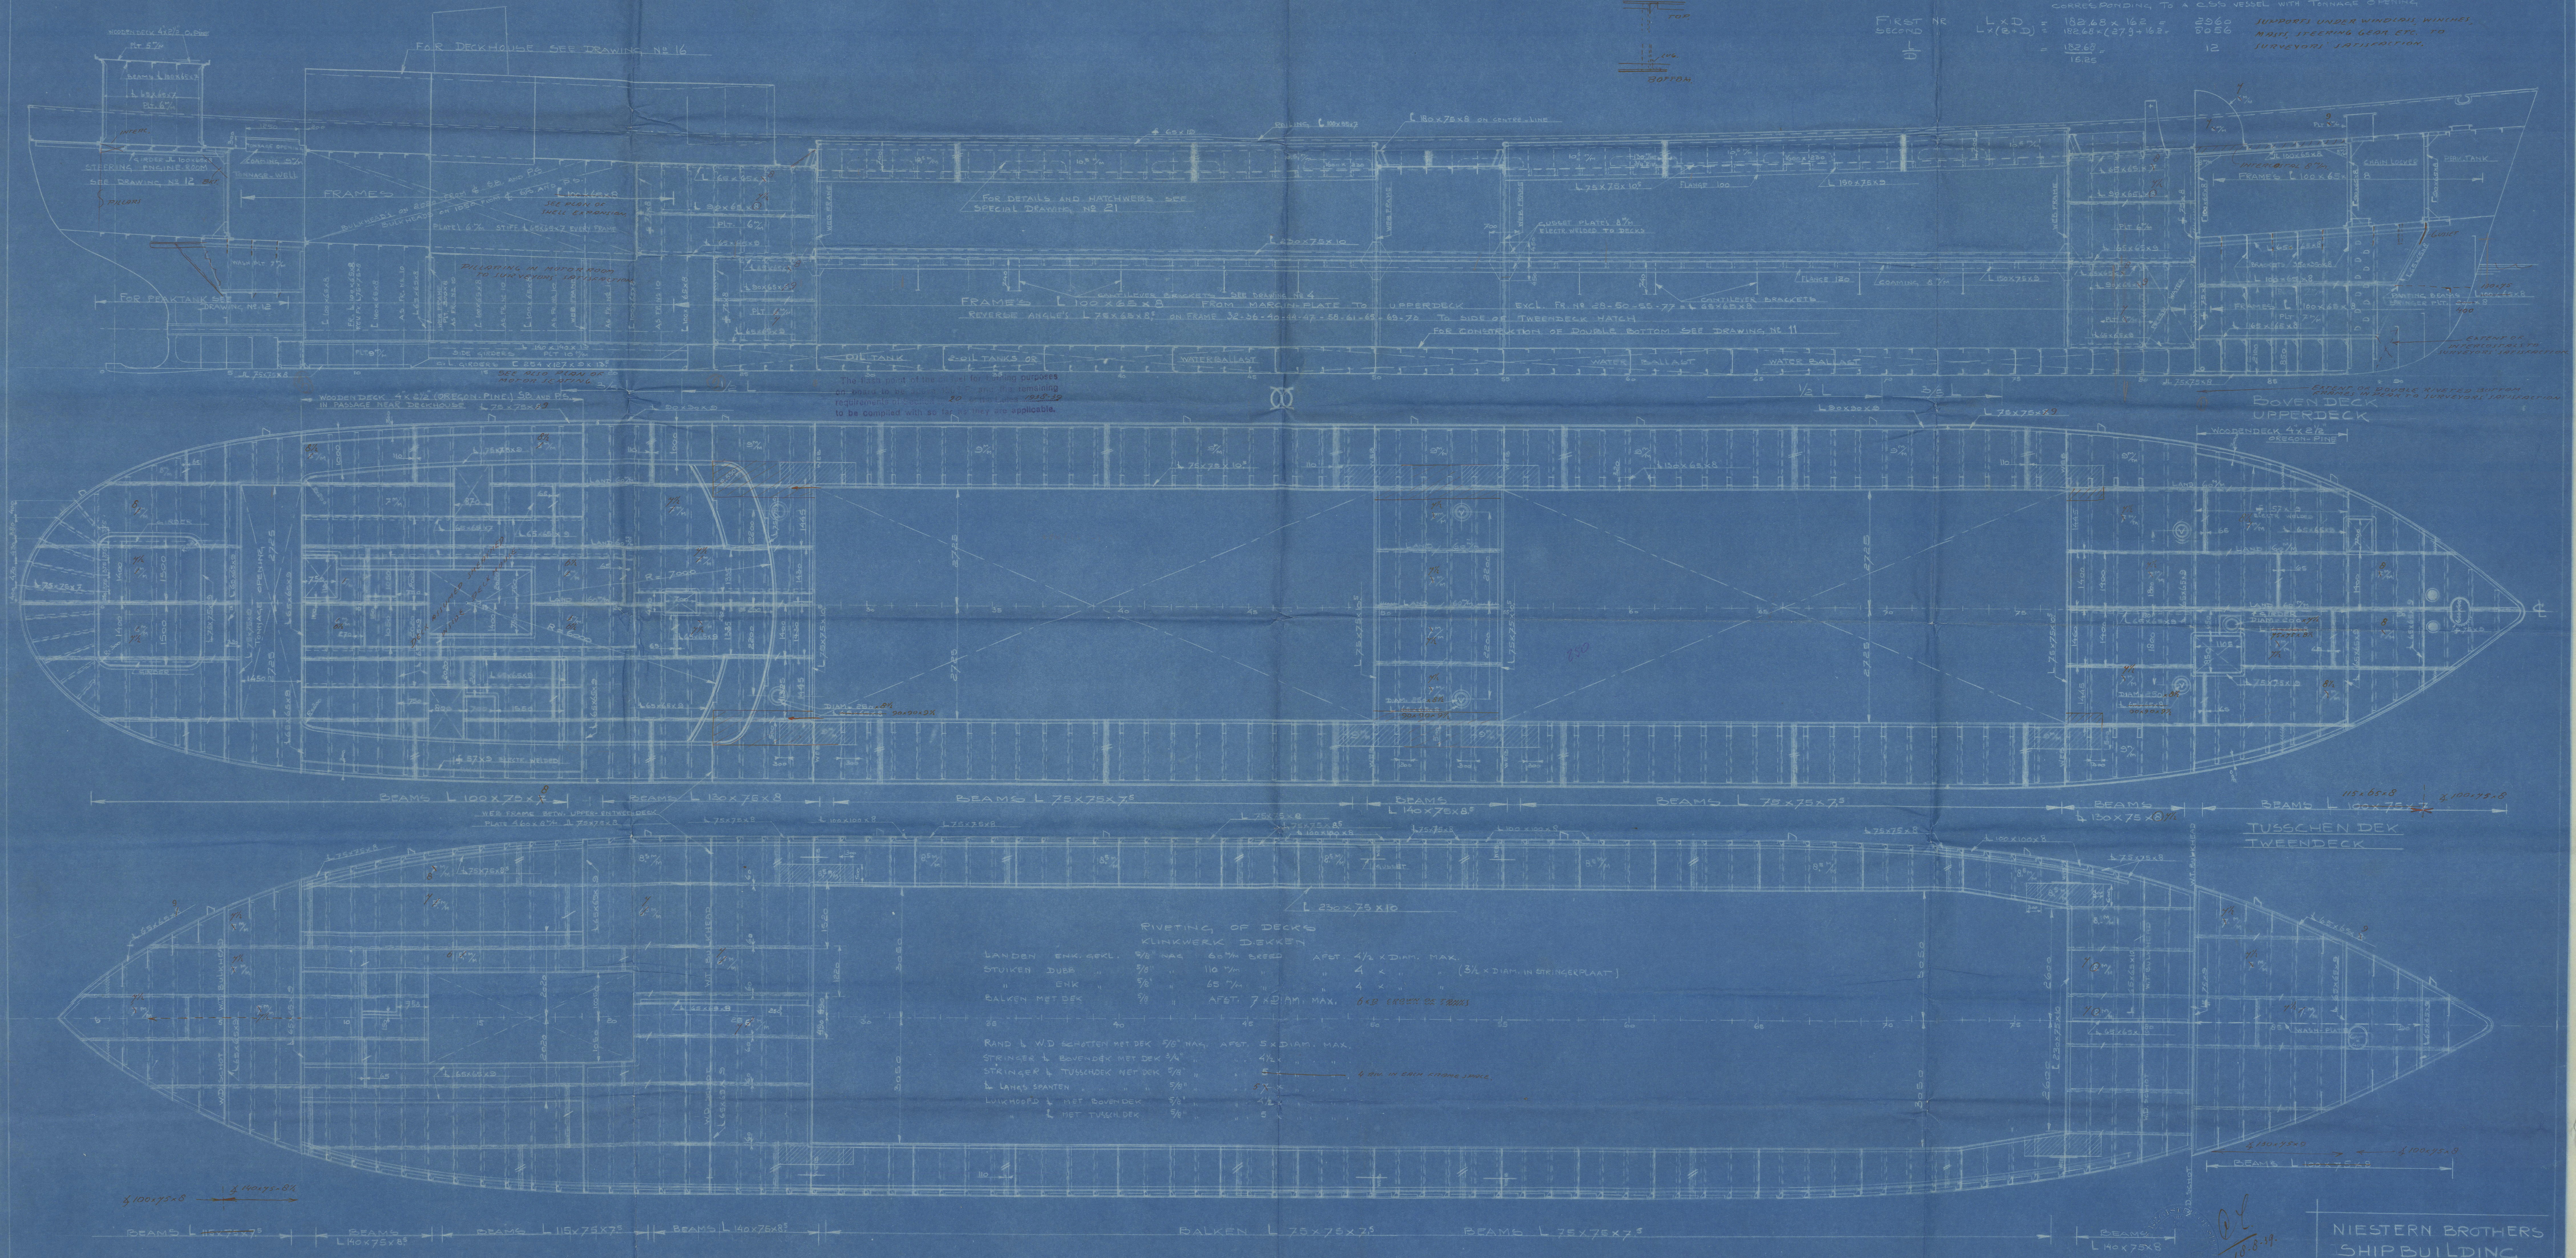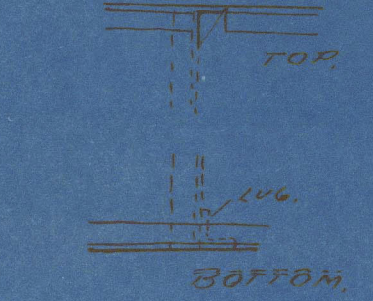


RIVETING OF DECKS
KLINKWERK DECKEN

LANDEN ENK. GPKL.	5/8" HAS	60" MAX	AFST. 4 1/2" DIAM. MAX.
STUIKEN DUBB.	5/8" "	110" "	4" " (3" x DIAM. IN RINGERPLAAT)
" ENK.	5/8" "	65" "	4" " "
BALKEN MET BEK.	7/8" "	AFST. 7 1/2" DIAM. MAX.	6 1/2" EXPOSED DECK

RAND L. W.D. GEWITTEN MET DEK	5/8" HAS	AFST. 5" DIAM. MAX.
STRIJKER L. BOVENDEK MET DEK	5/8" "	4" "
STRIJKER L. TUSSENDEK MET DEK	5/8" "	5" "
L. LANGS SPANTEN	5/8" "	5" "
LOKHOED L. MET BOVENDEK	5/8" "	5" "
" L. MET TUSSENDEK	5/8" "	5" "

NIESTERN BROTHERS
SHIPBUILDING
DELFTZUL - HOLLAND
B. No 226
DR. No 66
10 AUG. 38

LONDON

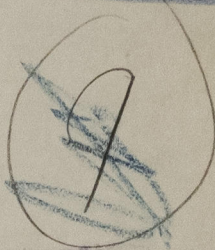

369


GEBR. NIESTERN.

226.

PROFILE & DECKS.

"BATAVIER" ❁

3

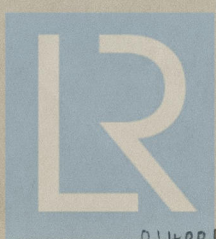

© 2021

Lloyd's Register
Foundation

014004-014014-0028