

N. Y. K.
AKI - MARU

CONSTRUCTION
PROFILE &
DECK PLAN
SHEET I
(FINISHED PLAN)


DIMENSION 1400-190-105
SCALE 1/100 CLASS 14
HULL DESIGNING SECTION
SHIP DESIGNING DEPARTMENT
YOKOHAMA


REG NO. 1438
JANUARY 1938
H-111B

"Aki Maru" ★

RECORDS DEPT
LONDON. /

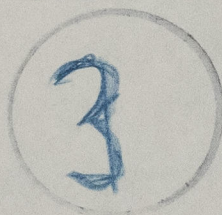

Construction, profile & Deck Plan.

Sheet II (Finished plan).




© 2021

Lloyd's Register
Foundation

014794-014805-0058

NS-606

FEB. 2. 1954

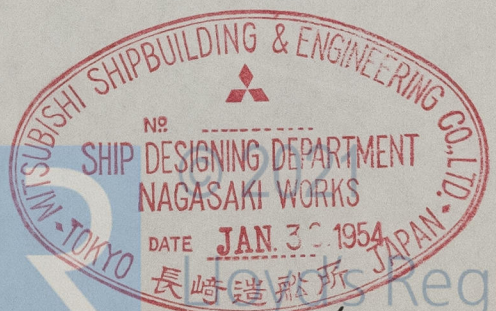

Register
Foundation
T. Okabe